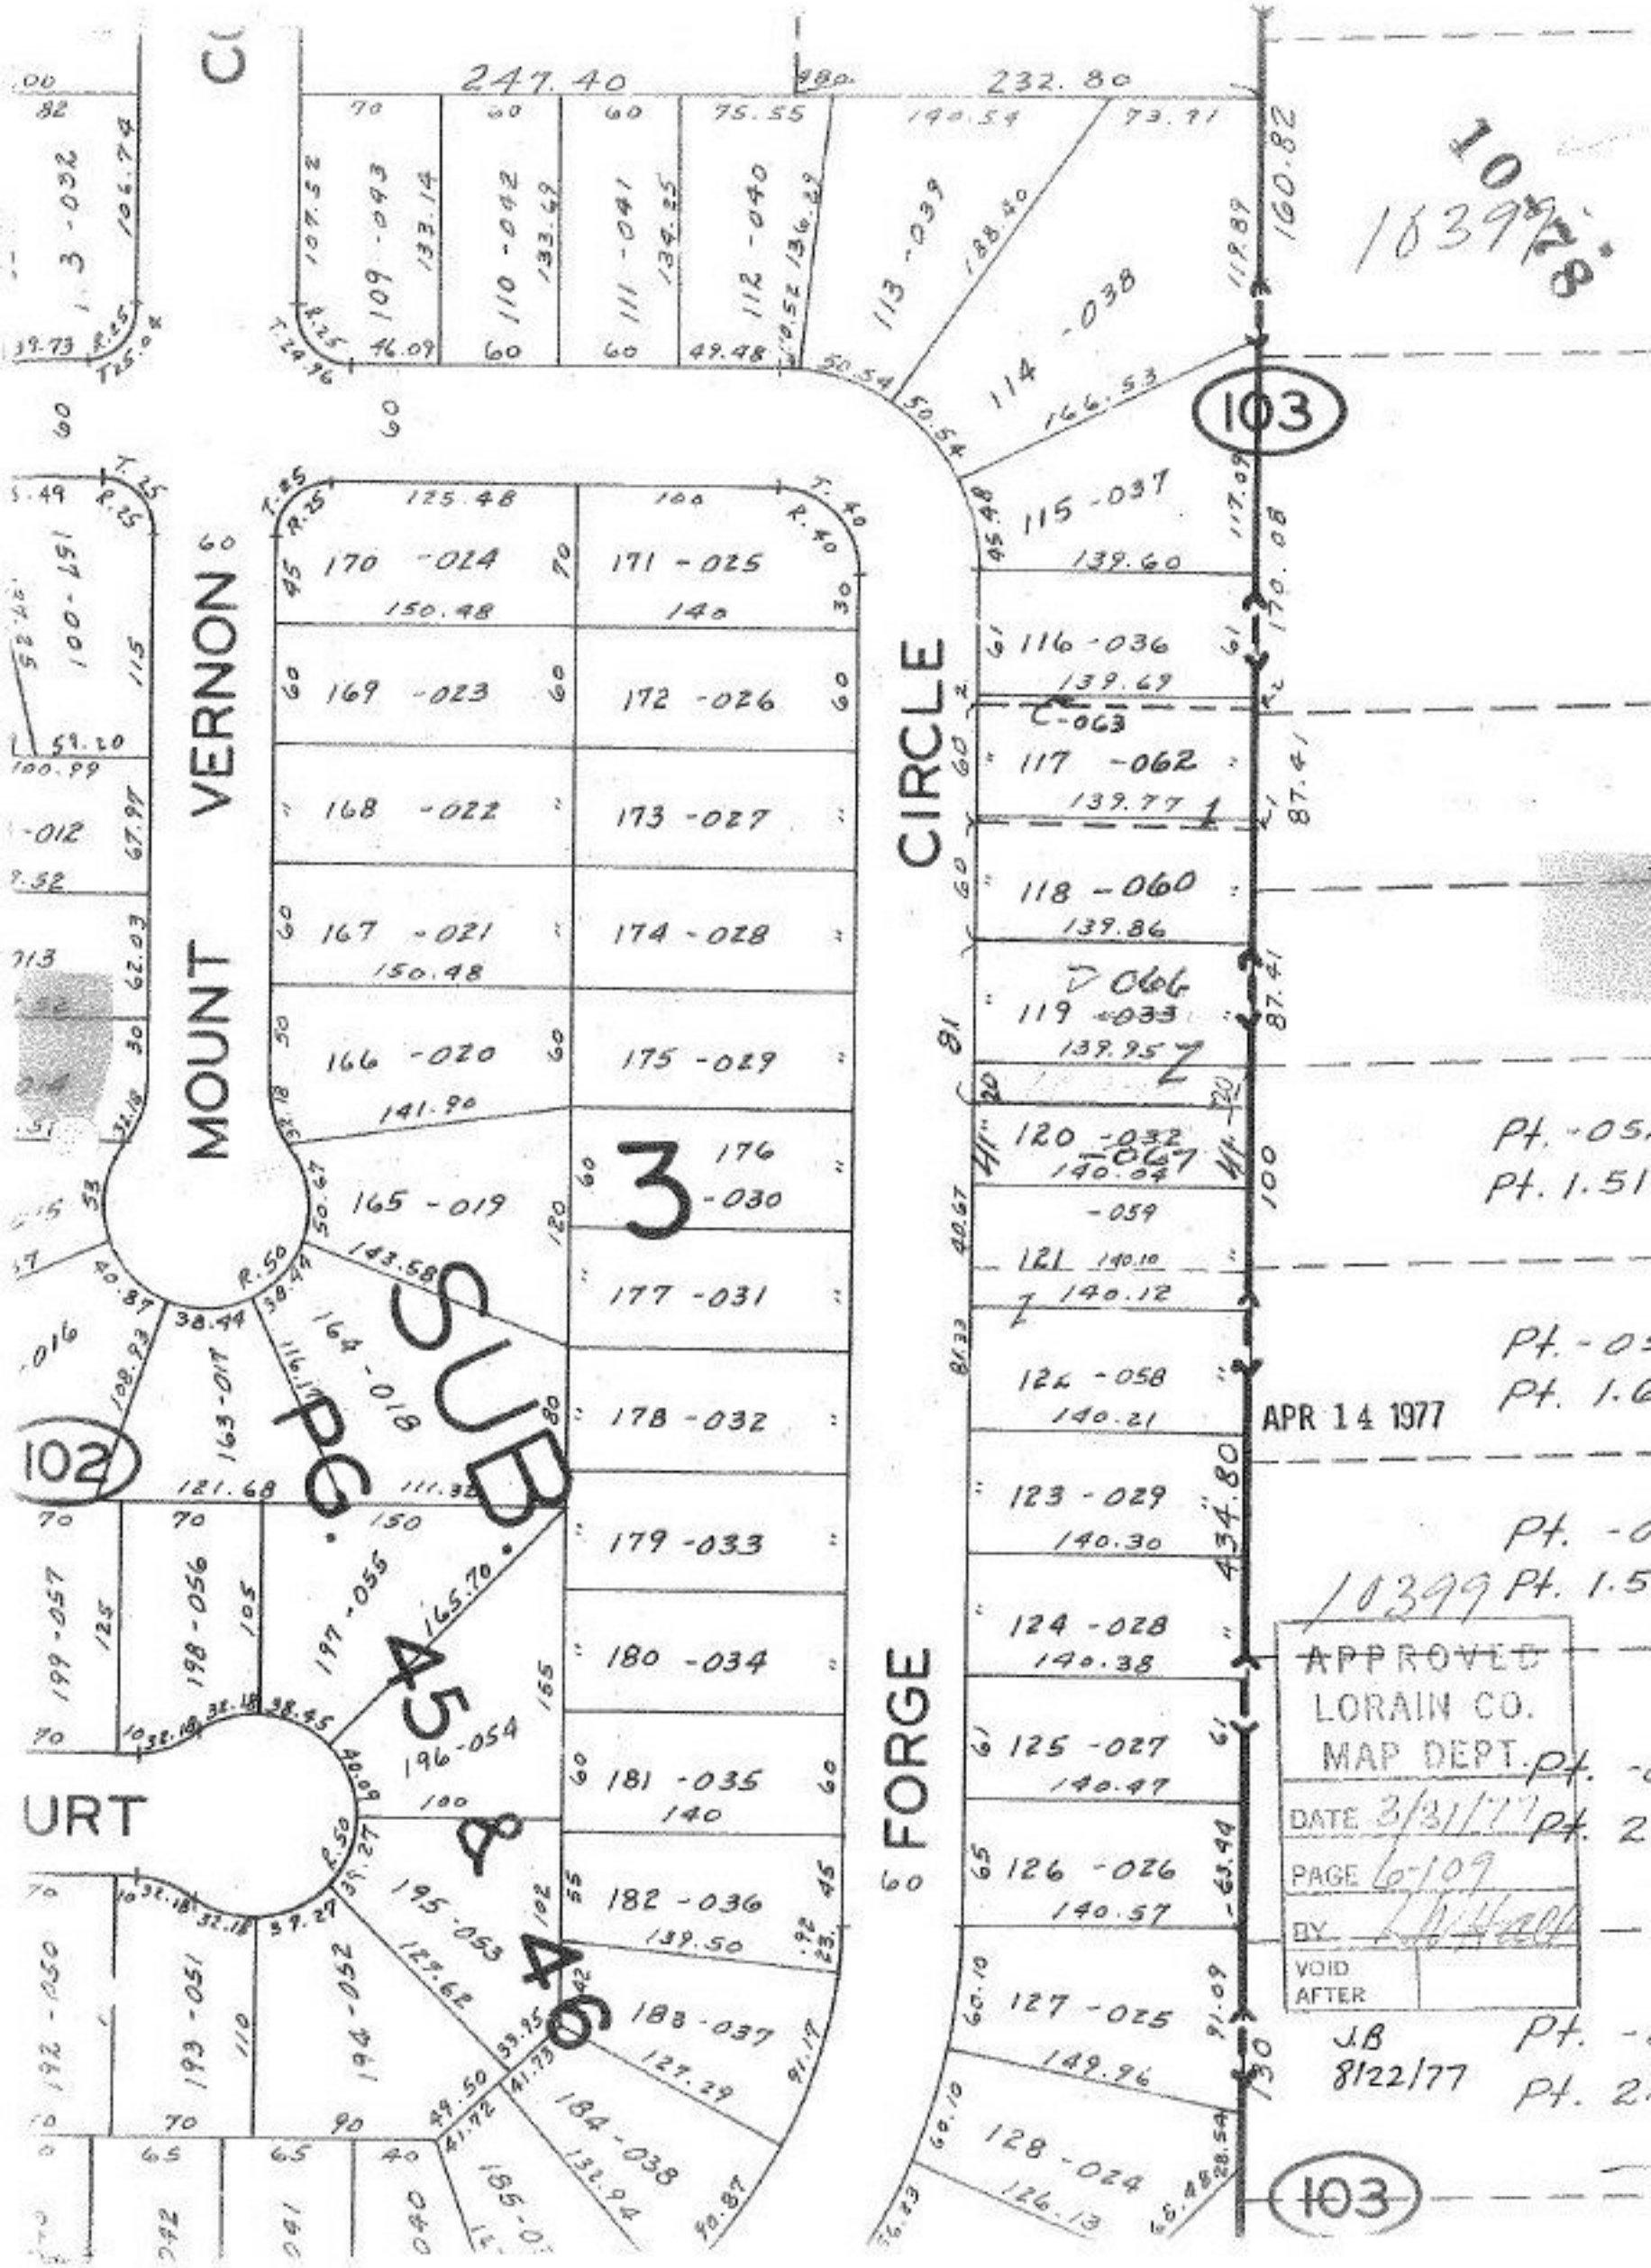

MOUNT VERNON
CIRCLE
FORGE
SUB
PG. 45 & 46
3
102
103
247.40
232.80
160.82
170.08
87.41
434.80
130
APR 14 1977
10399
APPROVED
LORAIN CO.
MAP DEPT.
DATE 3/31/77
PAGE 6-109
BY
VOID AFTER
J.B
8/22/77