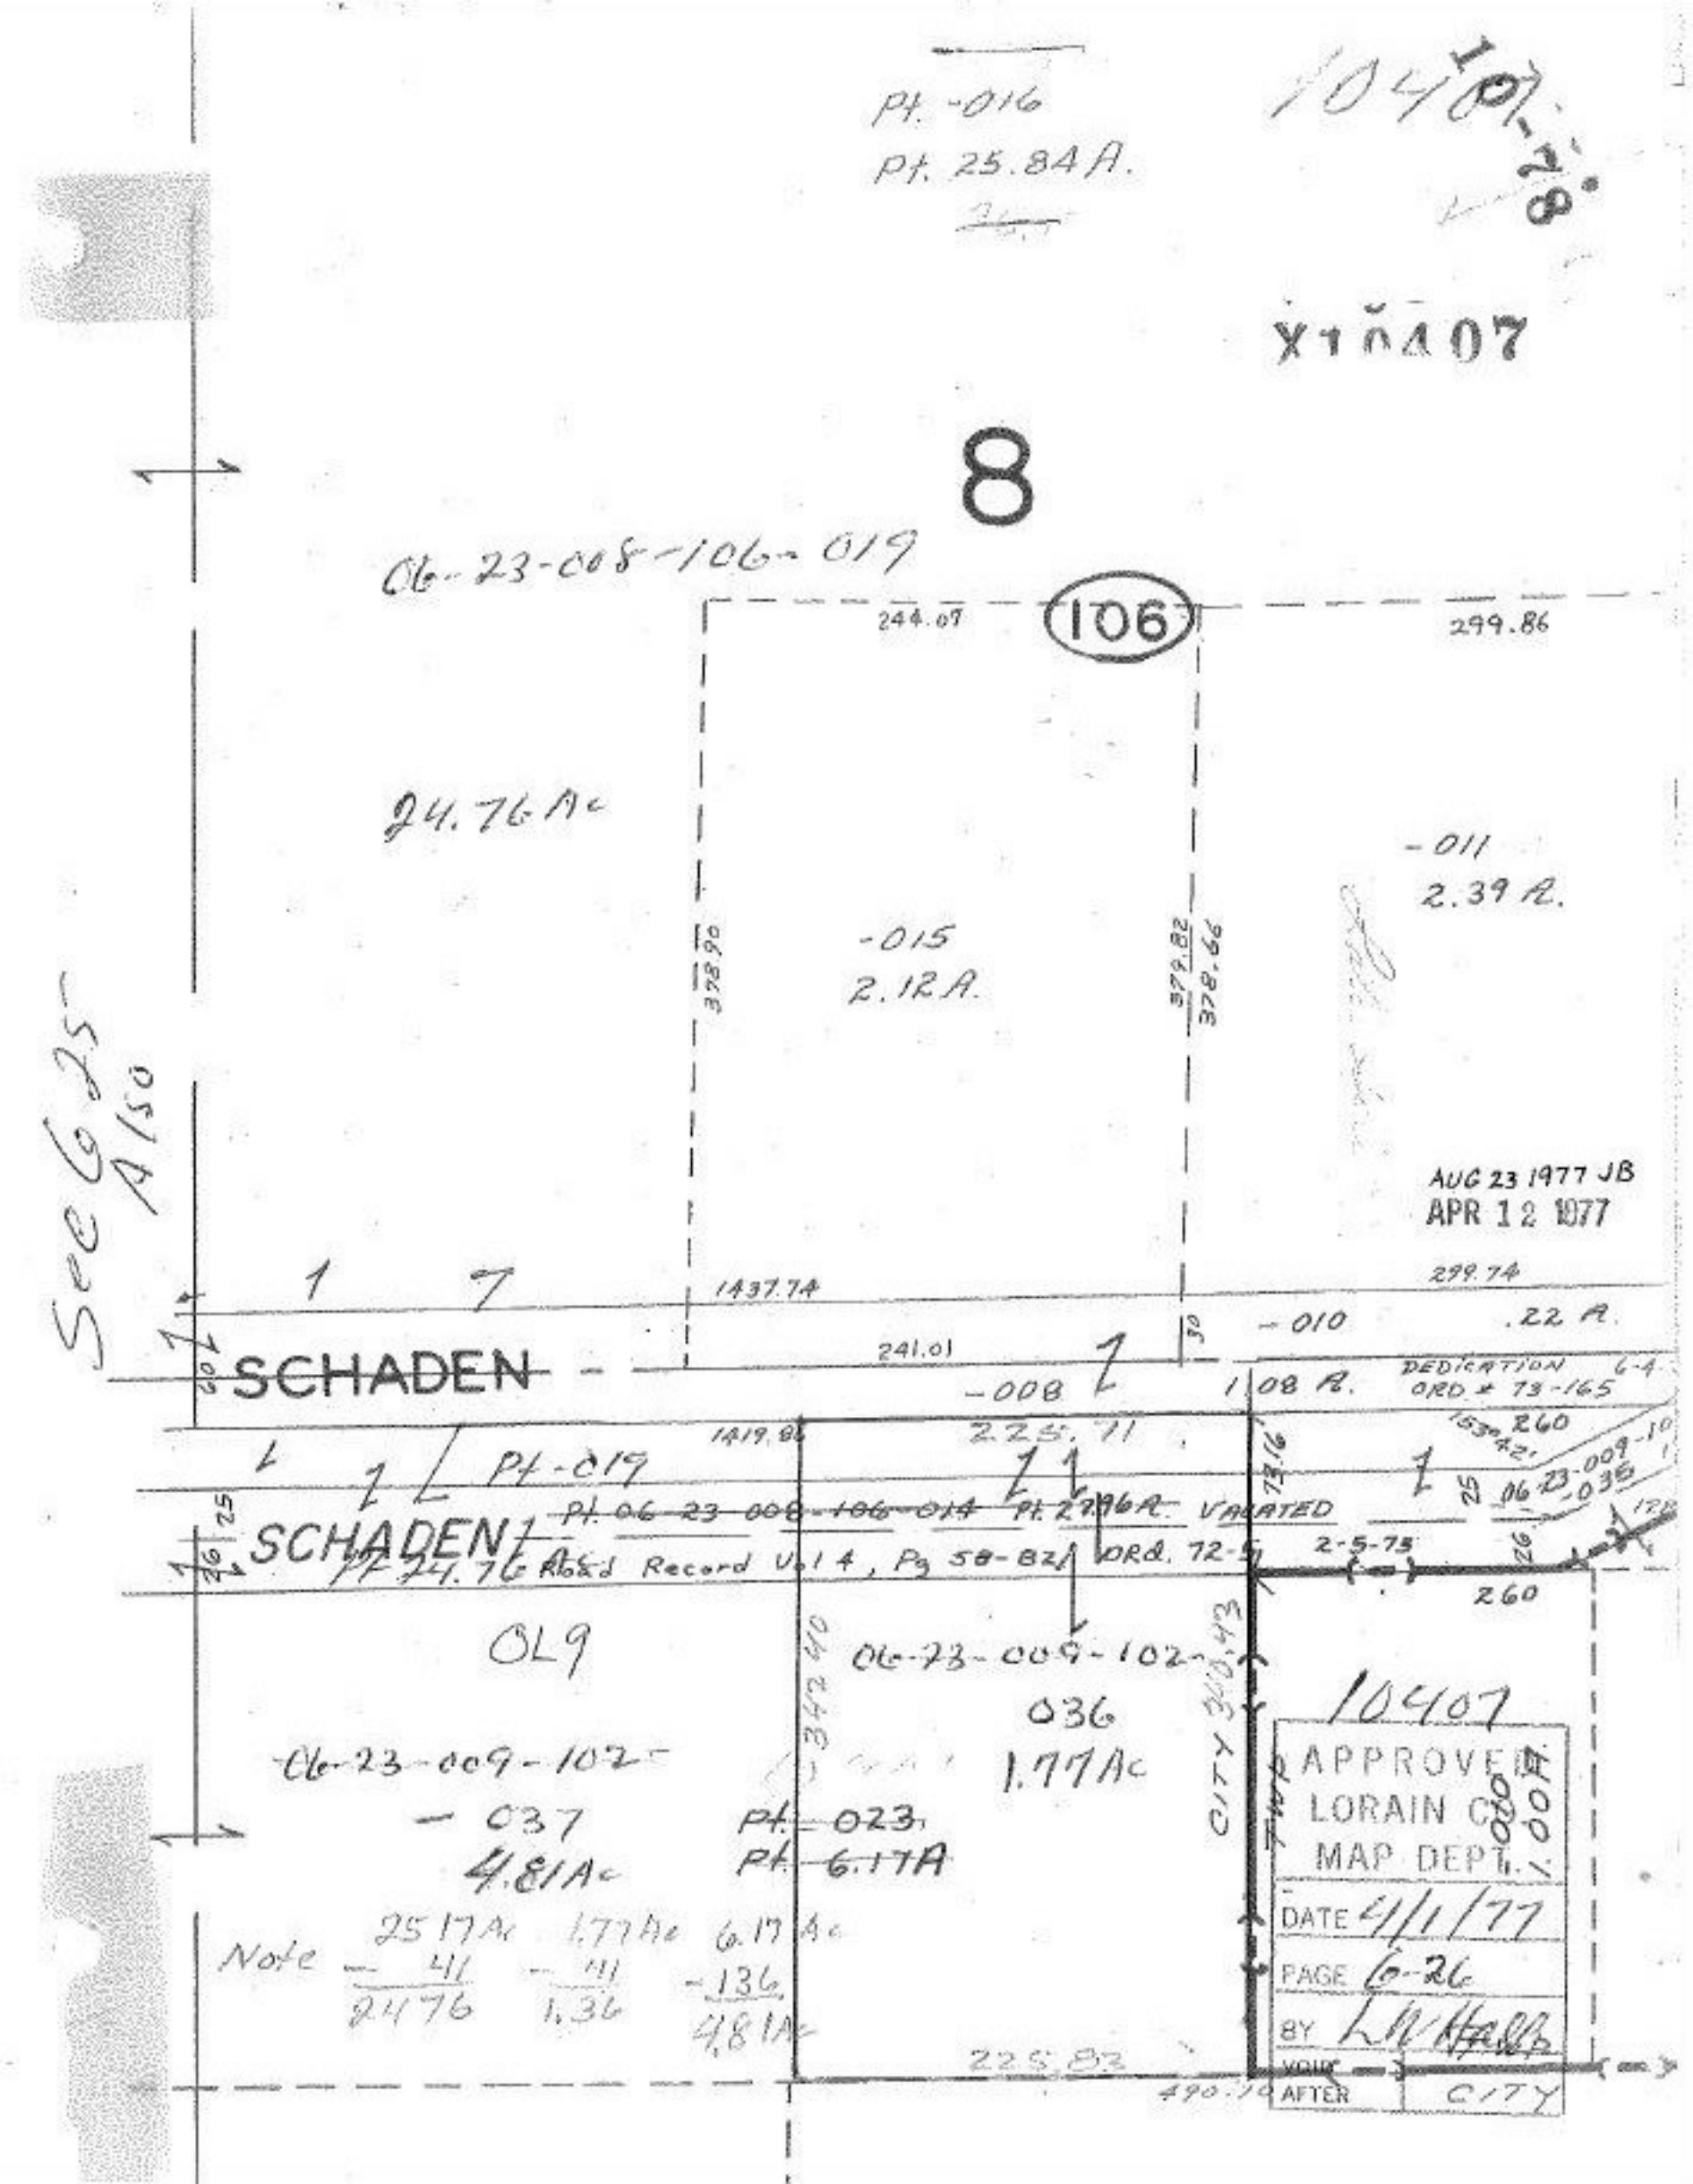

Pt. -016
Pt. 25.84 A.
10407
X10407
8
06-23-008-106-019
106
244.07
299.86
24.76 Ac
-011
2.39 A.
-015
2.12 A.
378.90
379.82
378.66
See 6-25 Also
AUG 23 1977 JB
APR 12 1977
1437.74
299.74
-010
.22 A.
SCHADEN
241.01
-008
1.08 A.
DEDICATION ORD # 73-165
1419.86
225.71
260
Pt-019
Pt. 06-23-008-106-014 Pt. 27.96 A. VACATED
SCHADEN
Pt 24.76 Road Record Vol 4, Pg 58-82 ORD. 72-5
2-5-73
260
OL9
06-23-009-102-036
1.77 Ac
10407
06-23-009-102-037
4.81 Ac
Pt. 023
Pt. 6.17 A
CITY
APPROVED
LORAIN CO
MAP DEPT.
DATE 4/1/77
PAGE 6-26
BY
VOID
AFTER
CITY
Note 25.17 Ac 1.77 Ac 6.17 Ac
- 41 - 41 - 136
24.76 1.36 4.81 Ac
225.83
490.70