


10 L'11

APPROVED  
 LORAIN CO.  
 MAP DEPT.  
 DATE 4/6/77  
 PAGE 3-00-041  
 BY LNHall  
 VOID AFTER MAY 27 1977

101

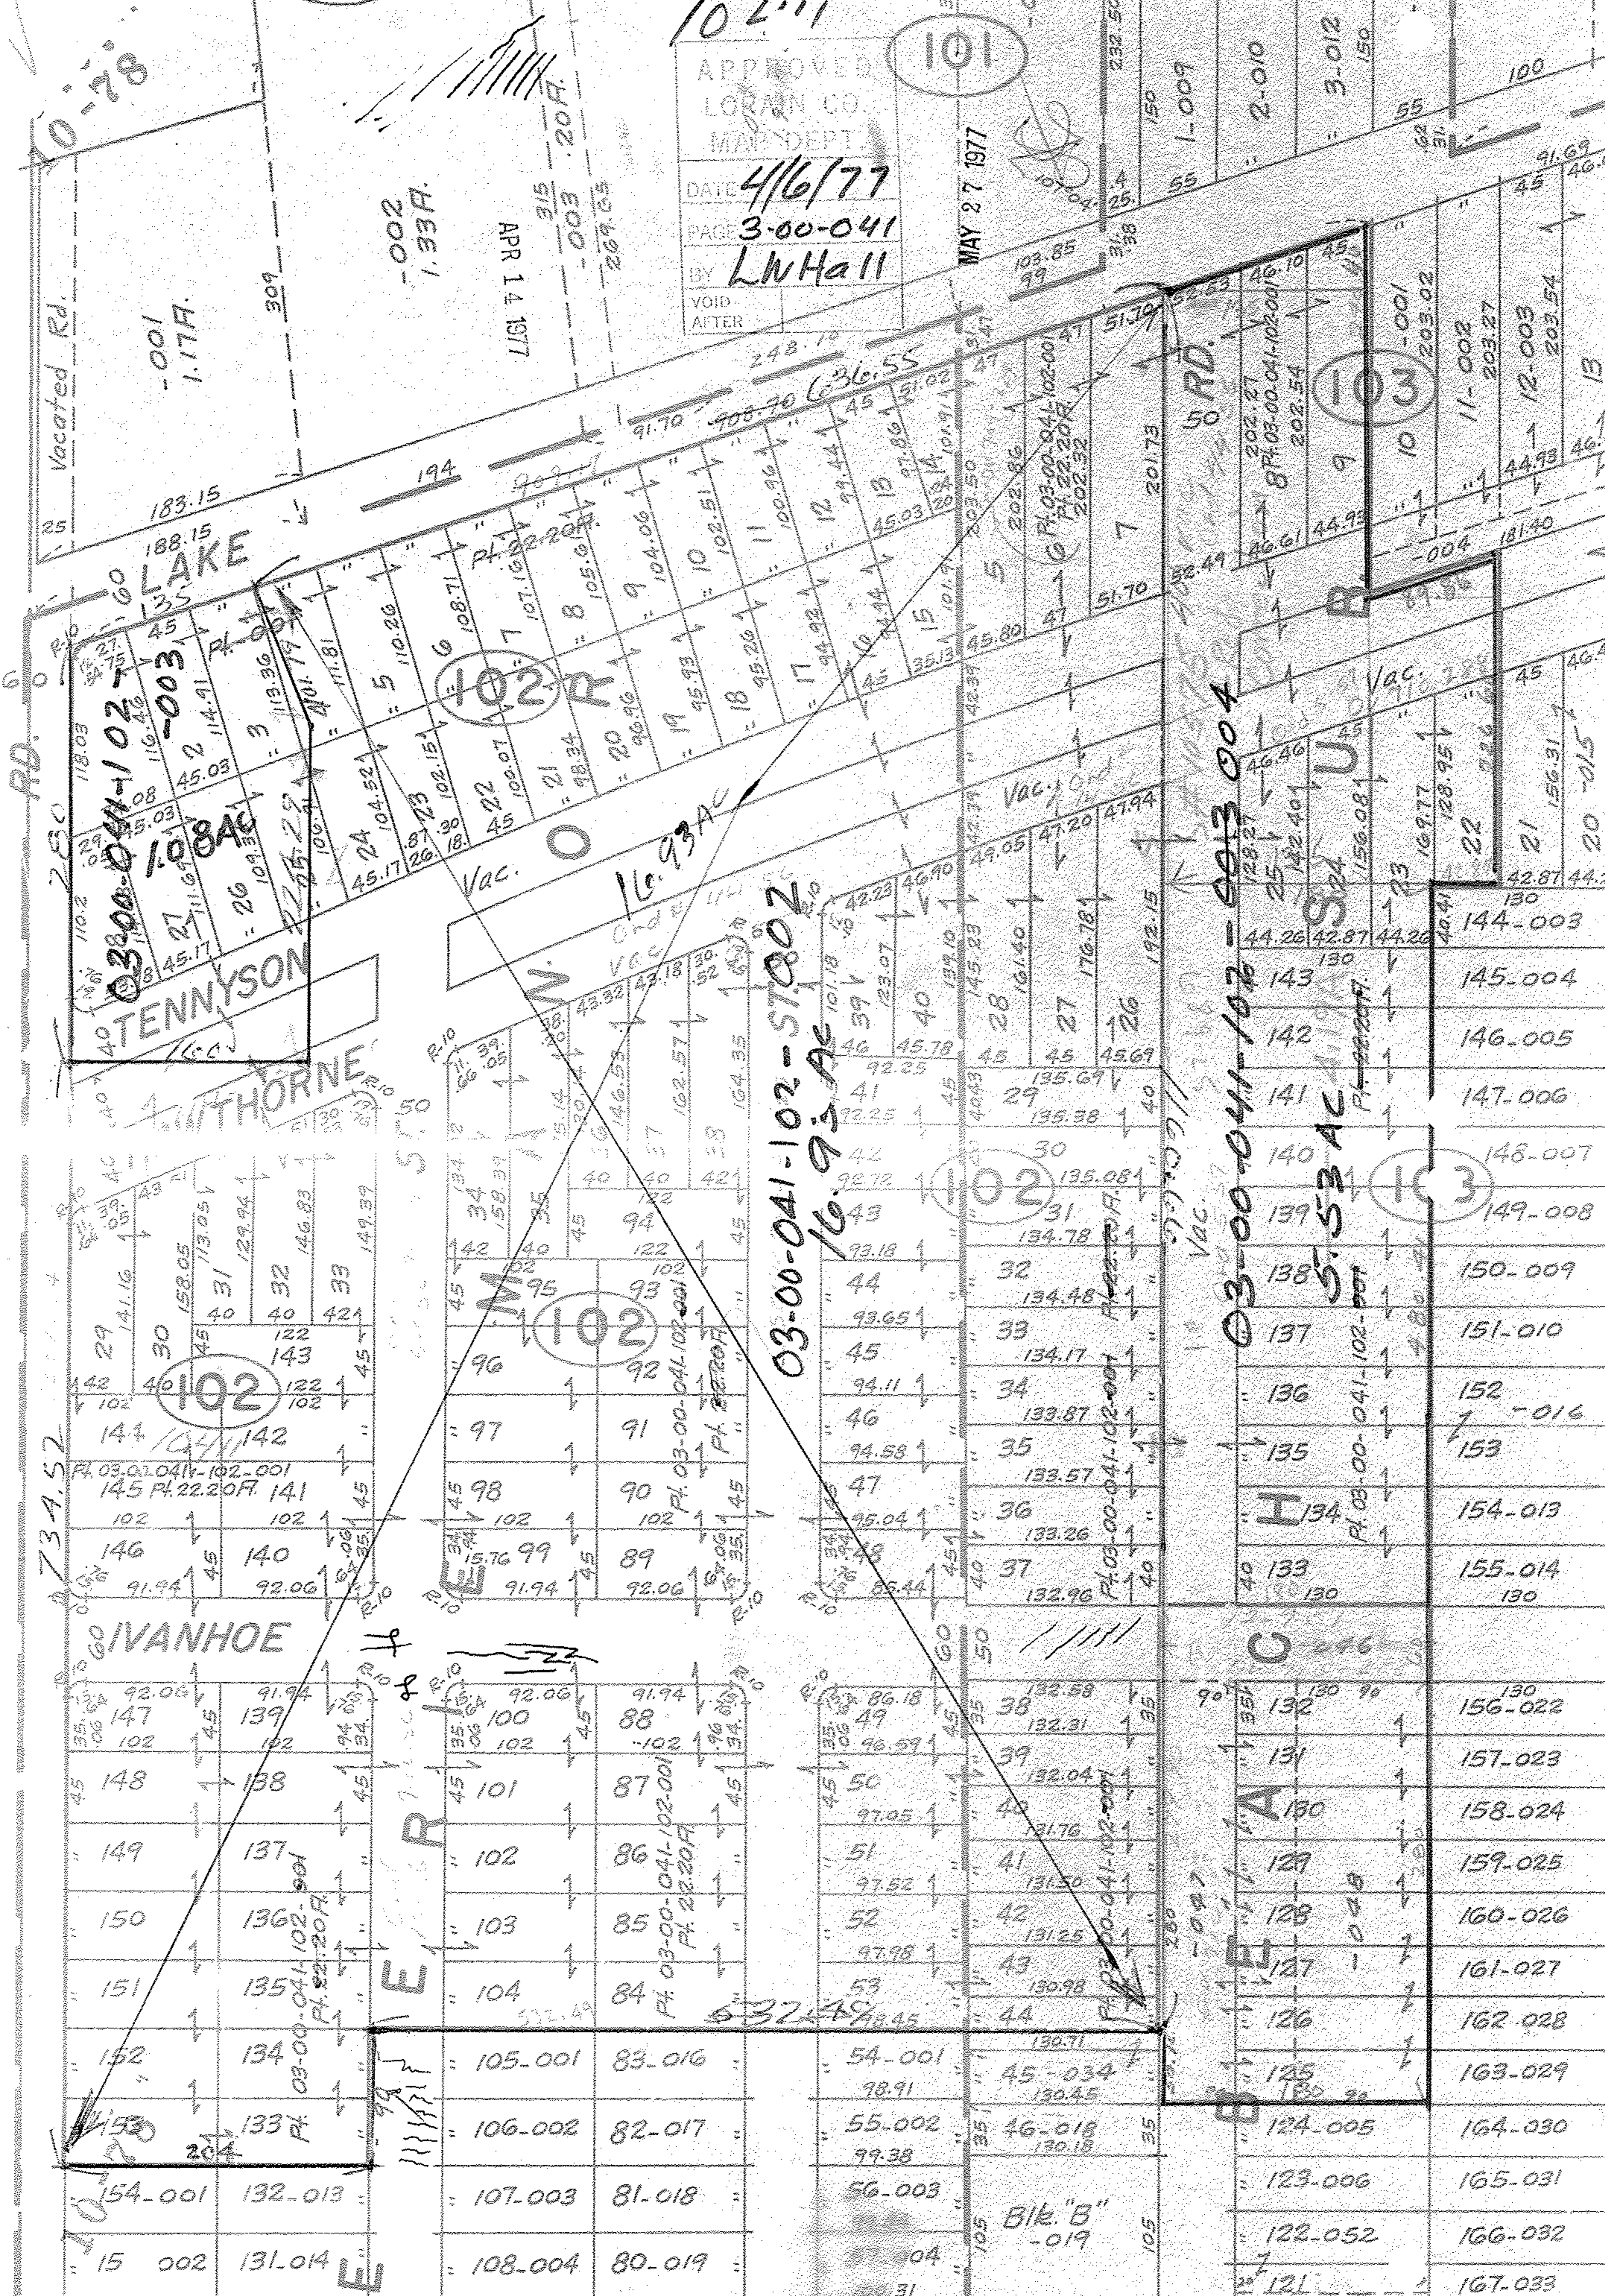

10-78

1.17A

1.33A

APR 14 1977

51E  
-000  
-20F  
209.05

03-00-041-102-003  
 108AC  
 TENNYSON

HAWTHORNE

IVANHOE

3 A 57

03-00-041-102-ST.002  
 16.93 AC

03-00-041-102-003 004  
 5.53 AC

50 RD.

LAKE

TENNYSON

IVANHOE

15 002 131.04

154-001 132-013

152 134 03-00-041-102-001

150 136 03-00-041-102-001

148 138

146 140

144 142









102

102

10