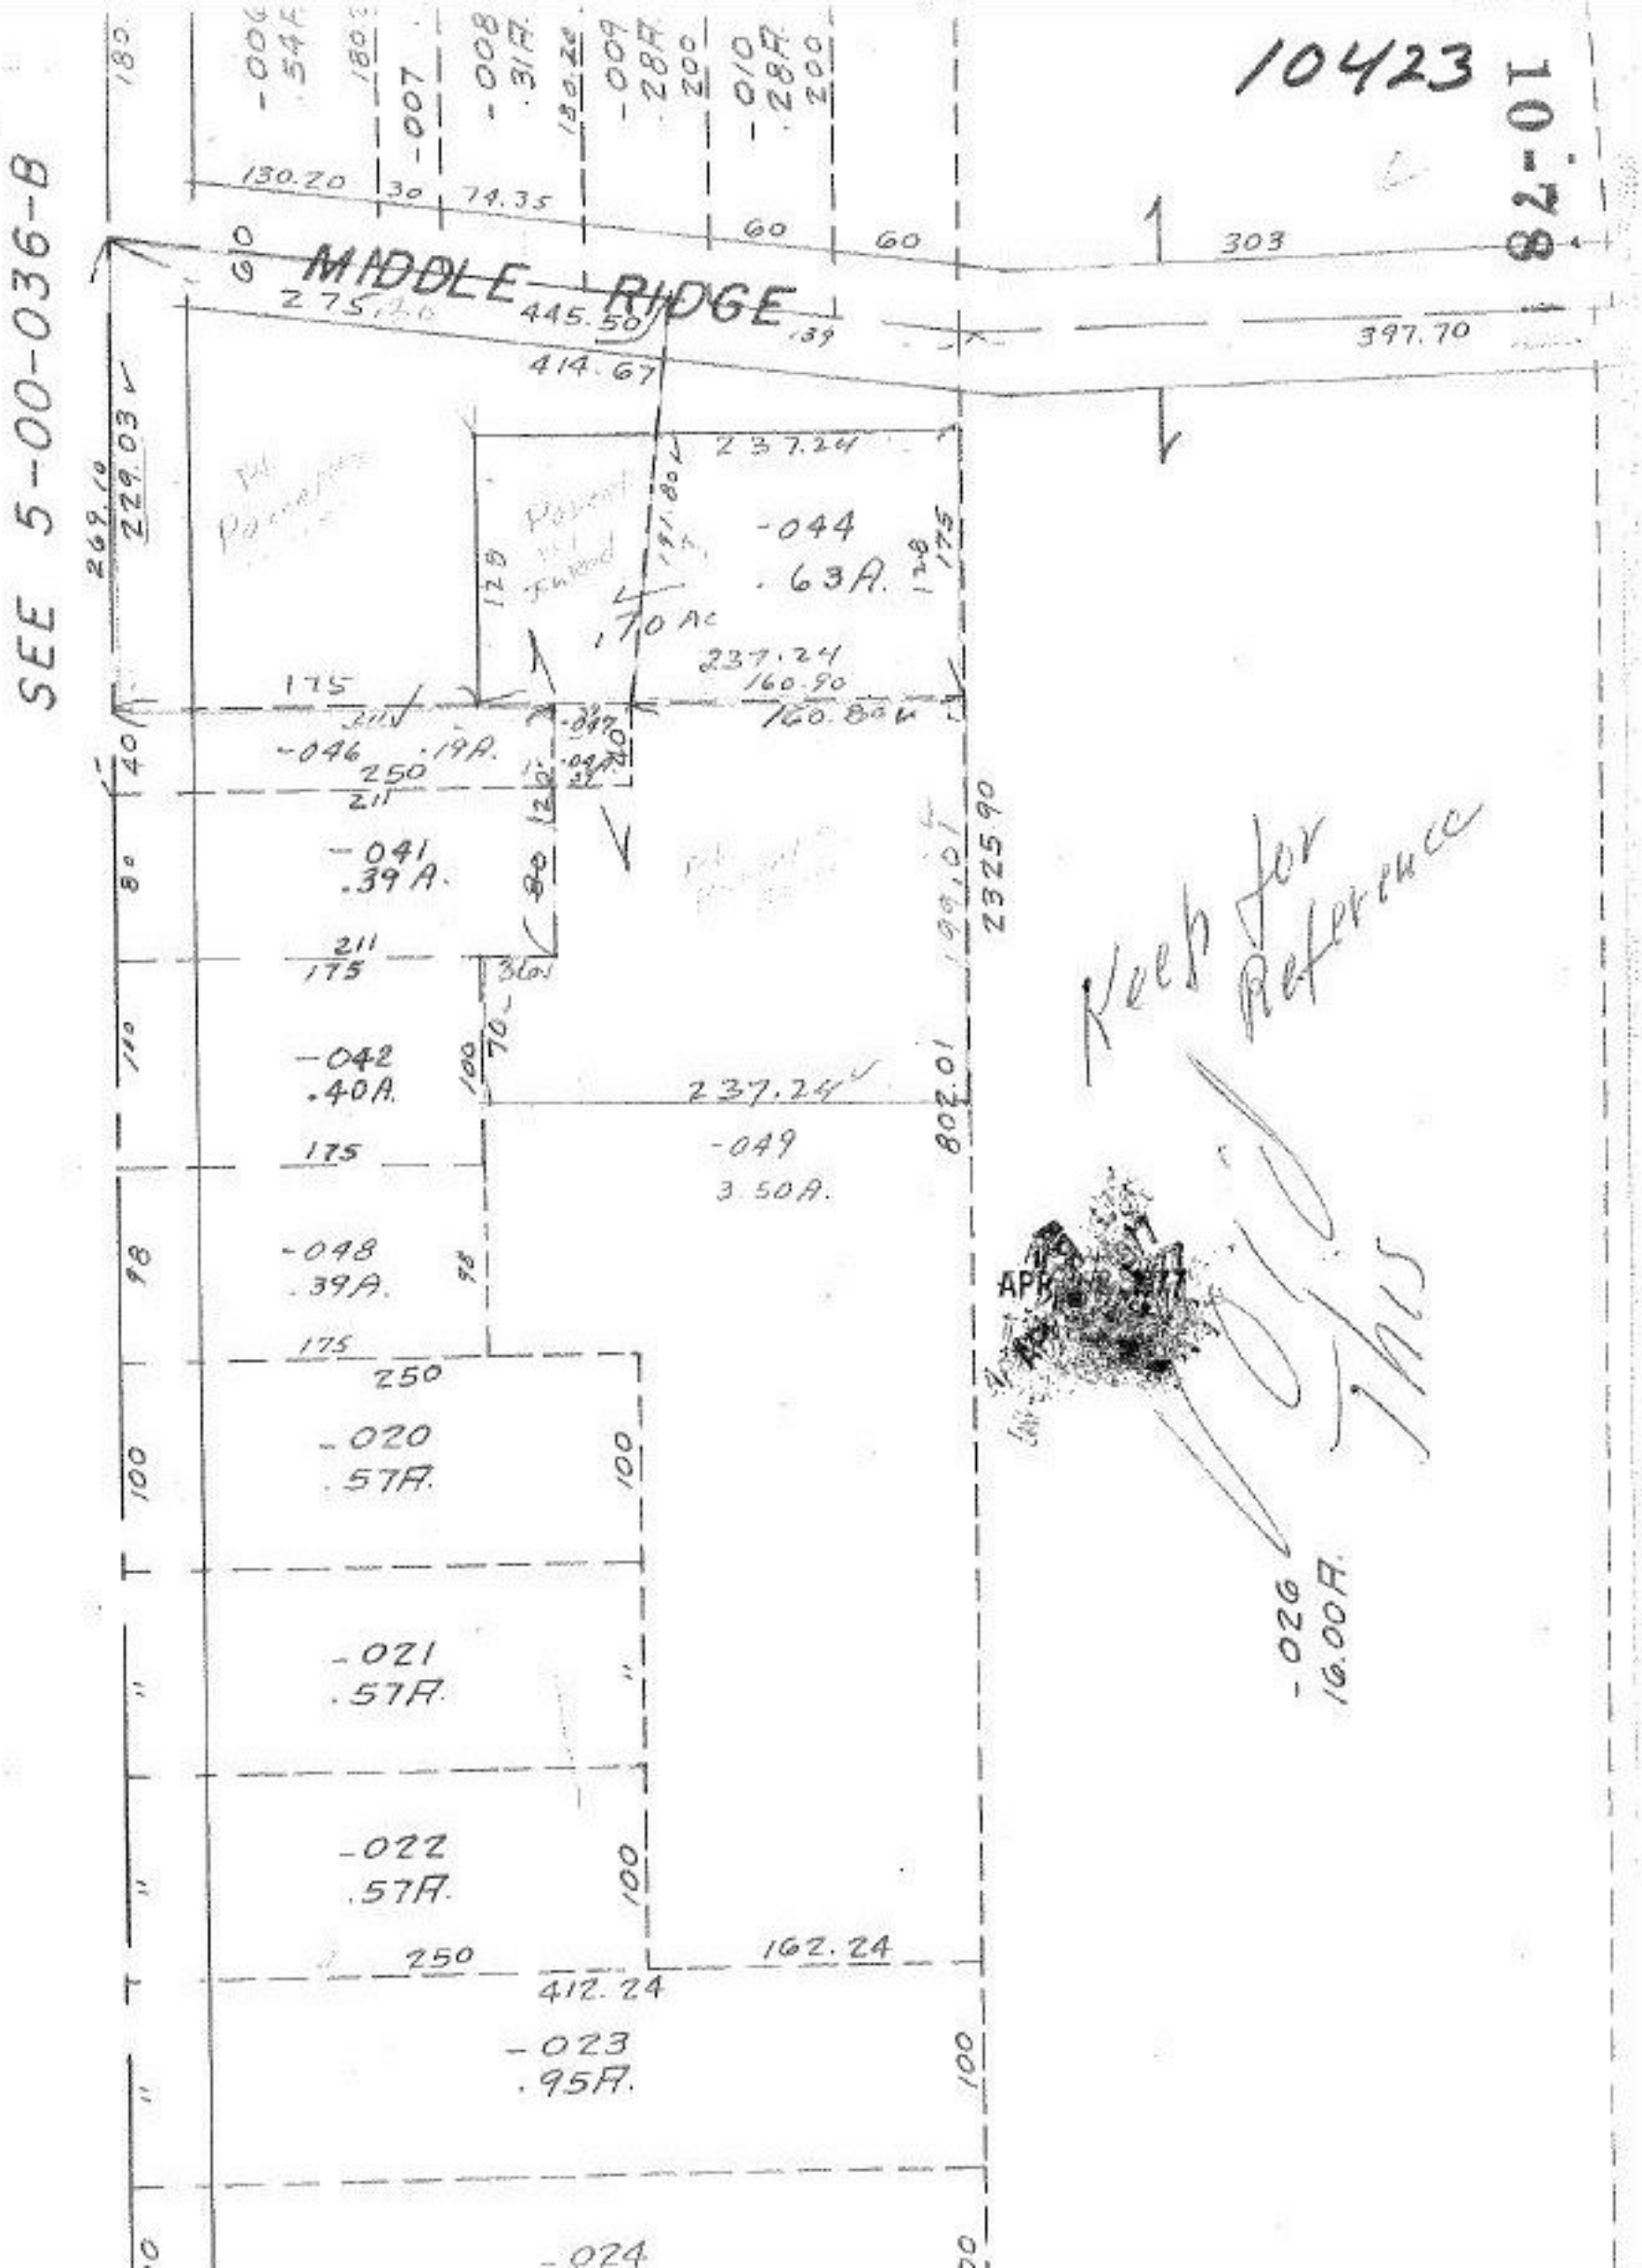
10423
10-78
SEE 5-00-036-B
MIDDLE RIDGE
130.20
30
74.35
60
60
303
445.50
414.67
397.70
237.24
-044
.63A.
237.24
160.90
160.80
175
-046
.19A.
250
211
-041
.39A.
211
175
-042
.40A.
237.24
-049
3.50A.
175
-048
.39A.
175
250
-020
.57A.
-021
.57A.
-022
.57A.
250
162.24
412.24
-023
.95A.
-024
2325.90
802.01
-026
16.00A.
Keep for Reference
APR