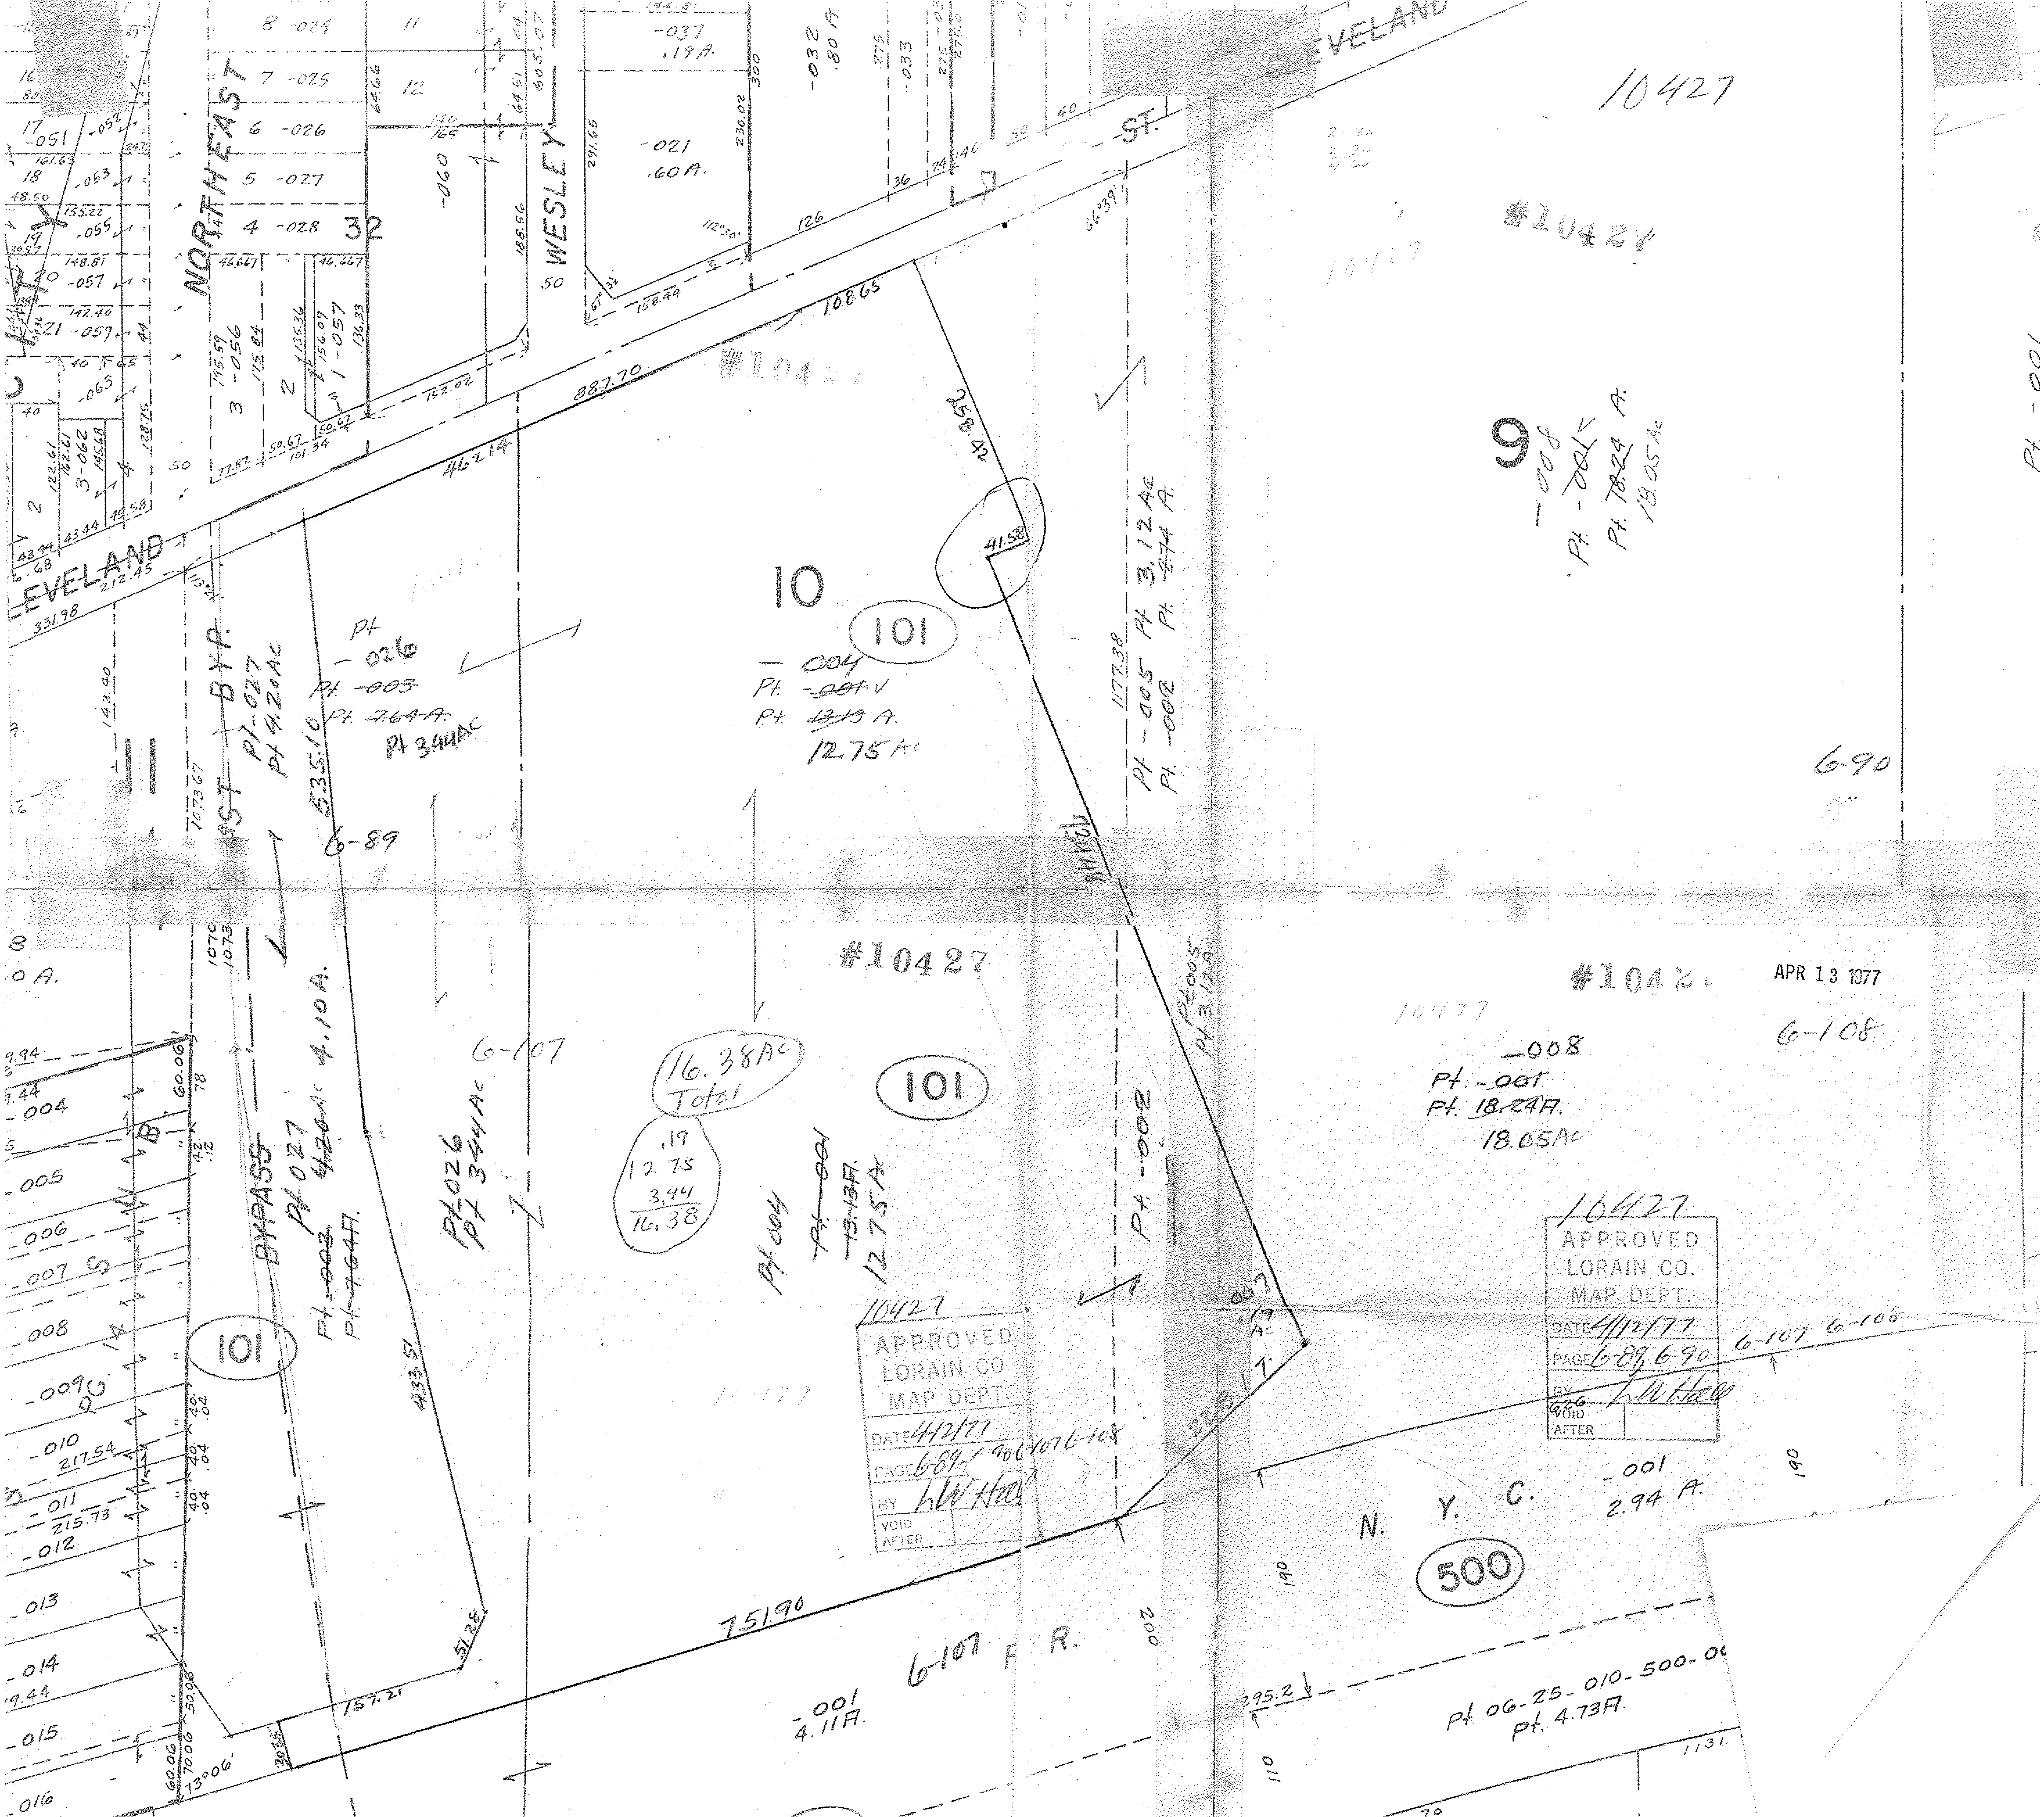
CLEVELAND
ST.
NORTHEAST
WESLEY
BYPASS
10427
#10427
9
-008
Pt. -001
Pt. 18.24 A.
18.05 Ac
10
101
-004
Pt. -001
Pt. 13.13 A.
12.75 Ac
Pt -026
Pt. -003
Pt. 7.64 A.
Pt 3.44 Ac
Pt -027
Pt 4.20 Ac
4.10 A.
16.38 Ac Total
.19
12.75
3.44
16.38
Pt -005 Pt 3.12 Ac
Pt -002 Pt 2.74 A.
-007
.19 Ac
6-89
6-90
6-107
6-108
APR 13 1977
APPROVED
LORAIN CO.
MAP DEPT.
DATE 4/12/77
PAGE 6-89, 6-90
BY LW Hall
VOID
AFTER
N. Y. C.
R. R.
500
-001
2.94 A.
-001
4.11 A.
Pt 06-25-010-500-00
Pt. 4.73 A.
887.70
462.14
108.65
751.90
1177.38
535.10
433.51
157.21
41.58
-004
-005
-006
-007
-008
-009
-010
-011
-012
-013
-014
-015
-016
PG. 14
-051
-052
-053
-055
-057
-059
-063
3-062
8 -024
7 -025
6 -026
5 -027
4 -028
32
3 -056
1 -057
-060
-021
.60 A.
-037
.19 A.
-032
.80 A.
-033