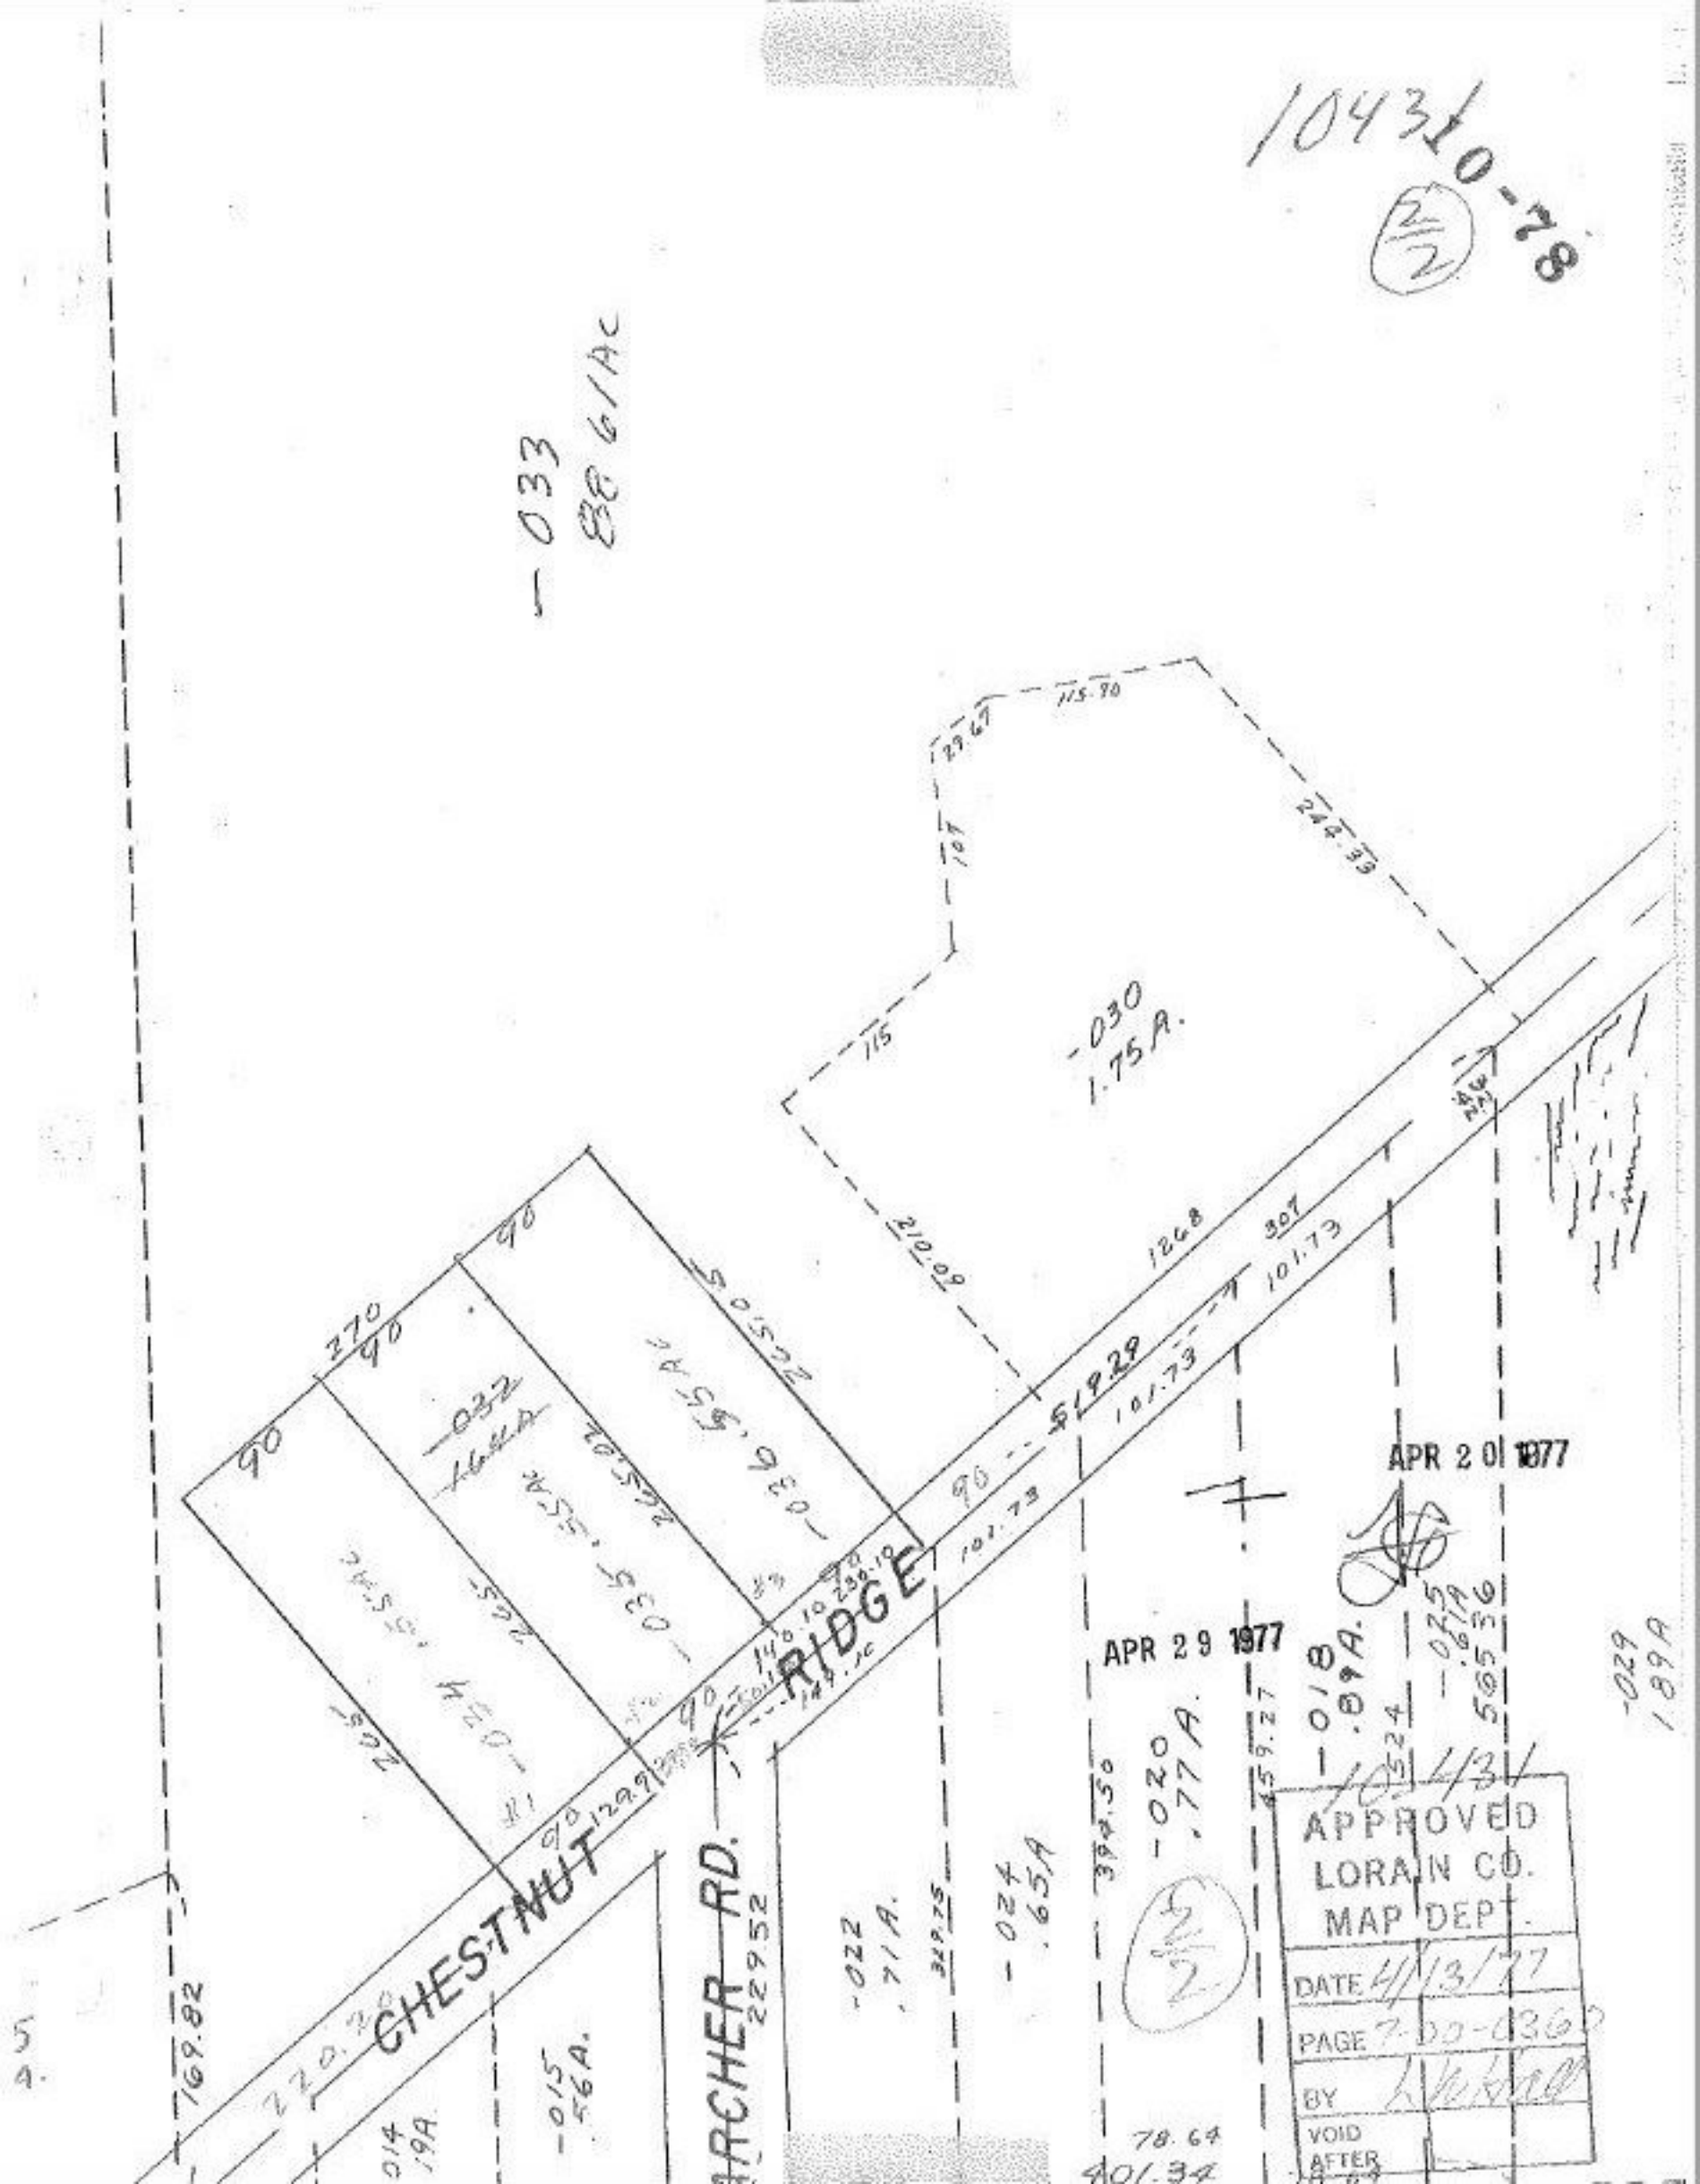

10431
10-78
2/2
-033
88.61AC
115.90
29.67
107
244.33
115
-030
1.75A.
210.09
1268
307
101.73
519.29
90
270
-032
-036
-035
-024
-025
-029
1.89A
-018
.89A.
-020
.77A.
-022
.71A.
-024
.65A
-015
.56A.
CHESTNUT RIDGE
ARCHER RD.
229.52
169.82
78.64
401.34
APR 20 1977
APR 29 1977
APPROVED
LORAIN CO.
MAP DEPT.
DATE 4/13/77
PAGE 7-00-0360
BY
VOID
AFTER