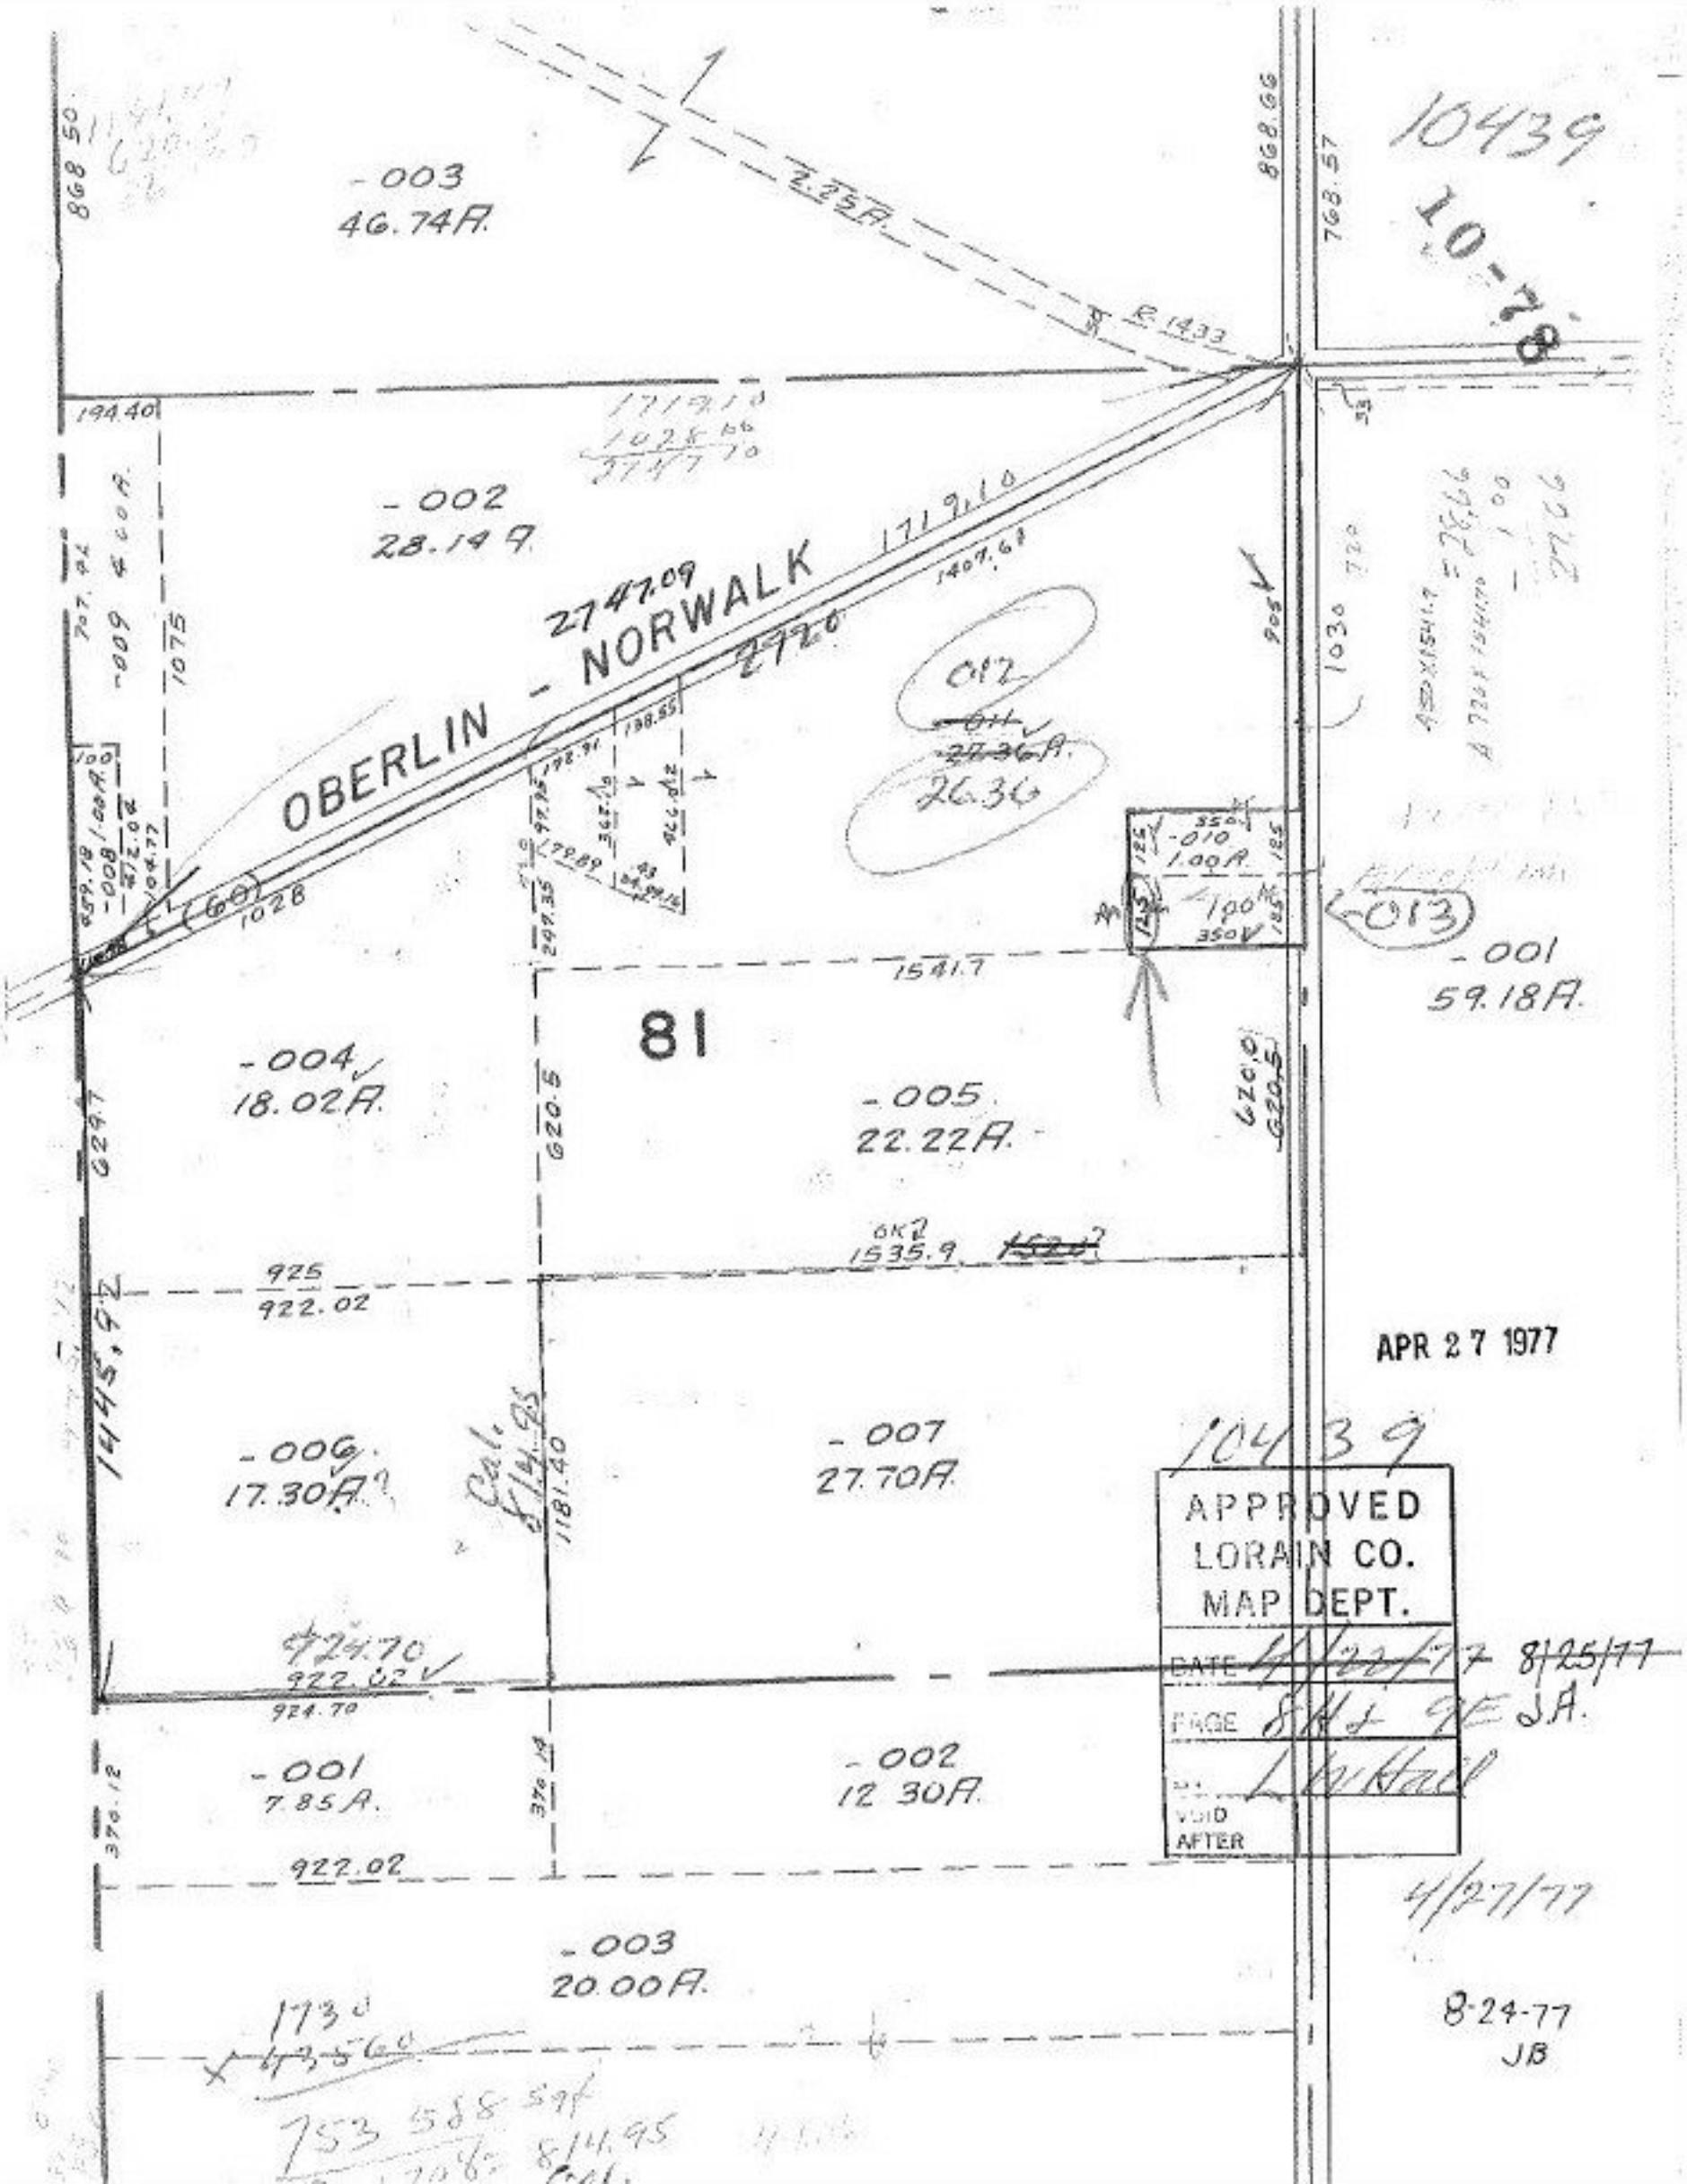
10439
10-78
-003
46.74A.
2.25A.
R 1433
868.50
868.66
768.57
194.40
-002
28.14A.
1719.10
1028.66
2747.70
2747.09
OBERLIN - NORWALK
1719.10
1407.63
2720
1075
-009
-008
1028
012
26.36
-010
1.00A.
-013
-001
59.18A.
1541.7
81
-004
18.02A.
-005
22.22A.
620.5
620.0
629.7
1535.9
925
922.02
1445.92
APR 27 1977
-006
17.30A.
Cal. 814.95
1181.40
-007
27.70A.
10439
APPROVED
LORAIN CO.
MAP DEPT.
DATE 4/22/77 8/25/77
PAGE 8H & 9E J.A.
BY L.W. Hall
VOID
AFTER
924.70
922.02
924.70
-001
7.85A.
-002
12.30A.
370.12
370.14
922.02
4/27/77
-003
20.00A.
8-24-77
JB
1730
753 588 sqf
814.95