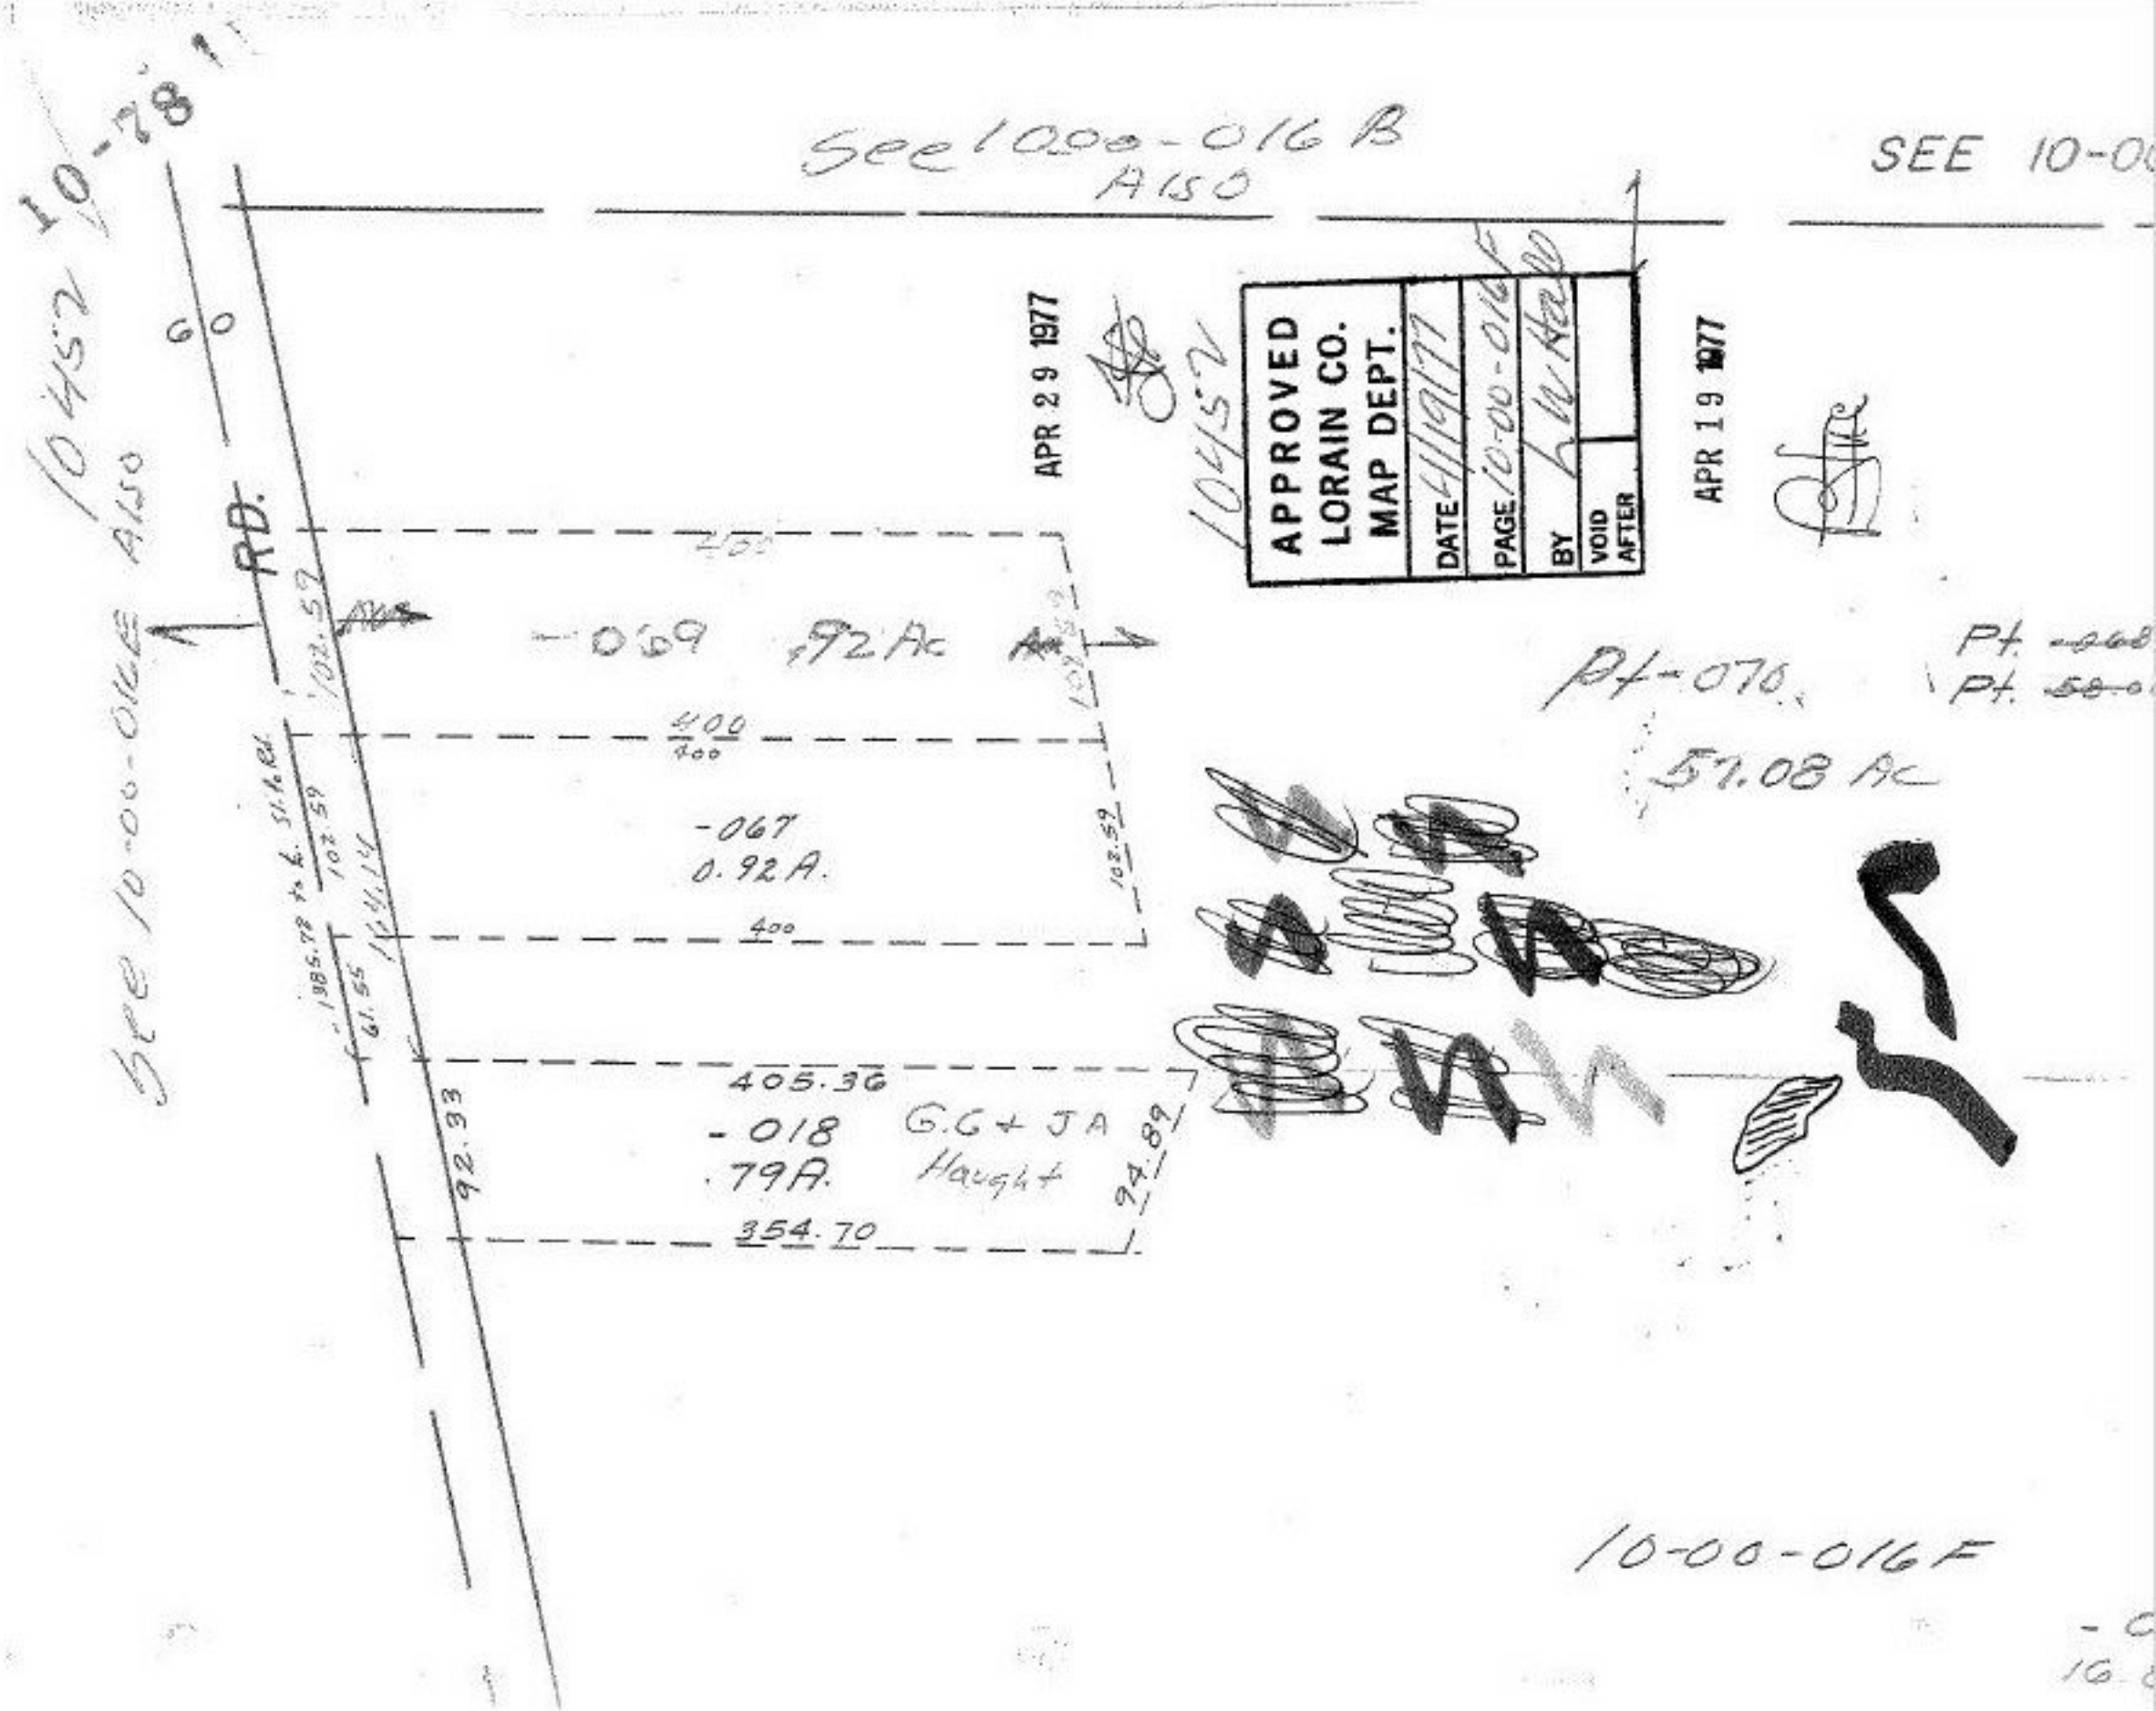

See 10-00-016 B
Also
SEE 10-00
10-78
10452
See 10-00-016E Also
RD.
60
APR 29 1977
APPROVED
LORAIN CO.
MAP DEPT.
DATE 4/19/77
PAGE 10-00-016F
BY
VOID AFTER
APR 19 1977
-069 .92 Ac
400
400
-067
0.92 A.
400
102.59
102.59
1385.78 to L. St. Rd.
61.55
405.36
-018
.79A.
G.G + JA
Haught
92.33
94.89
354.70
Pt-070
57.08 Ac
10-00-016F