10462

10-78

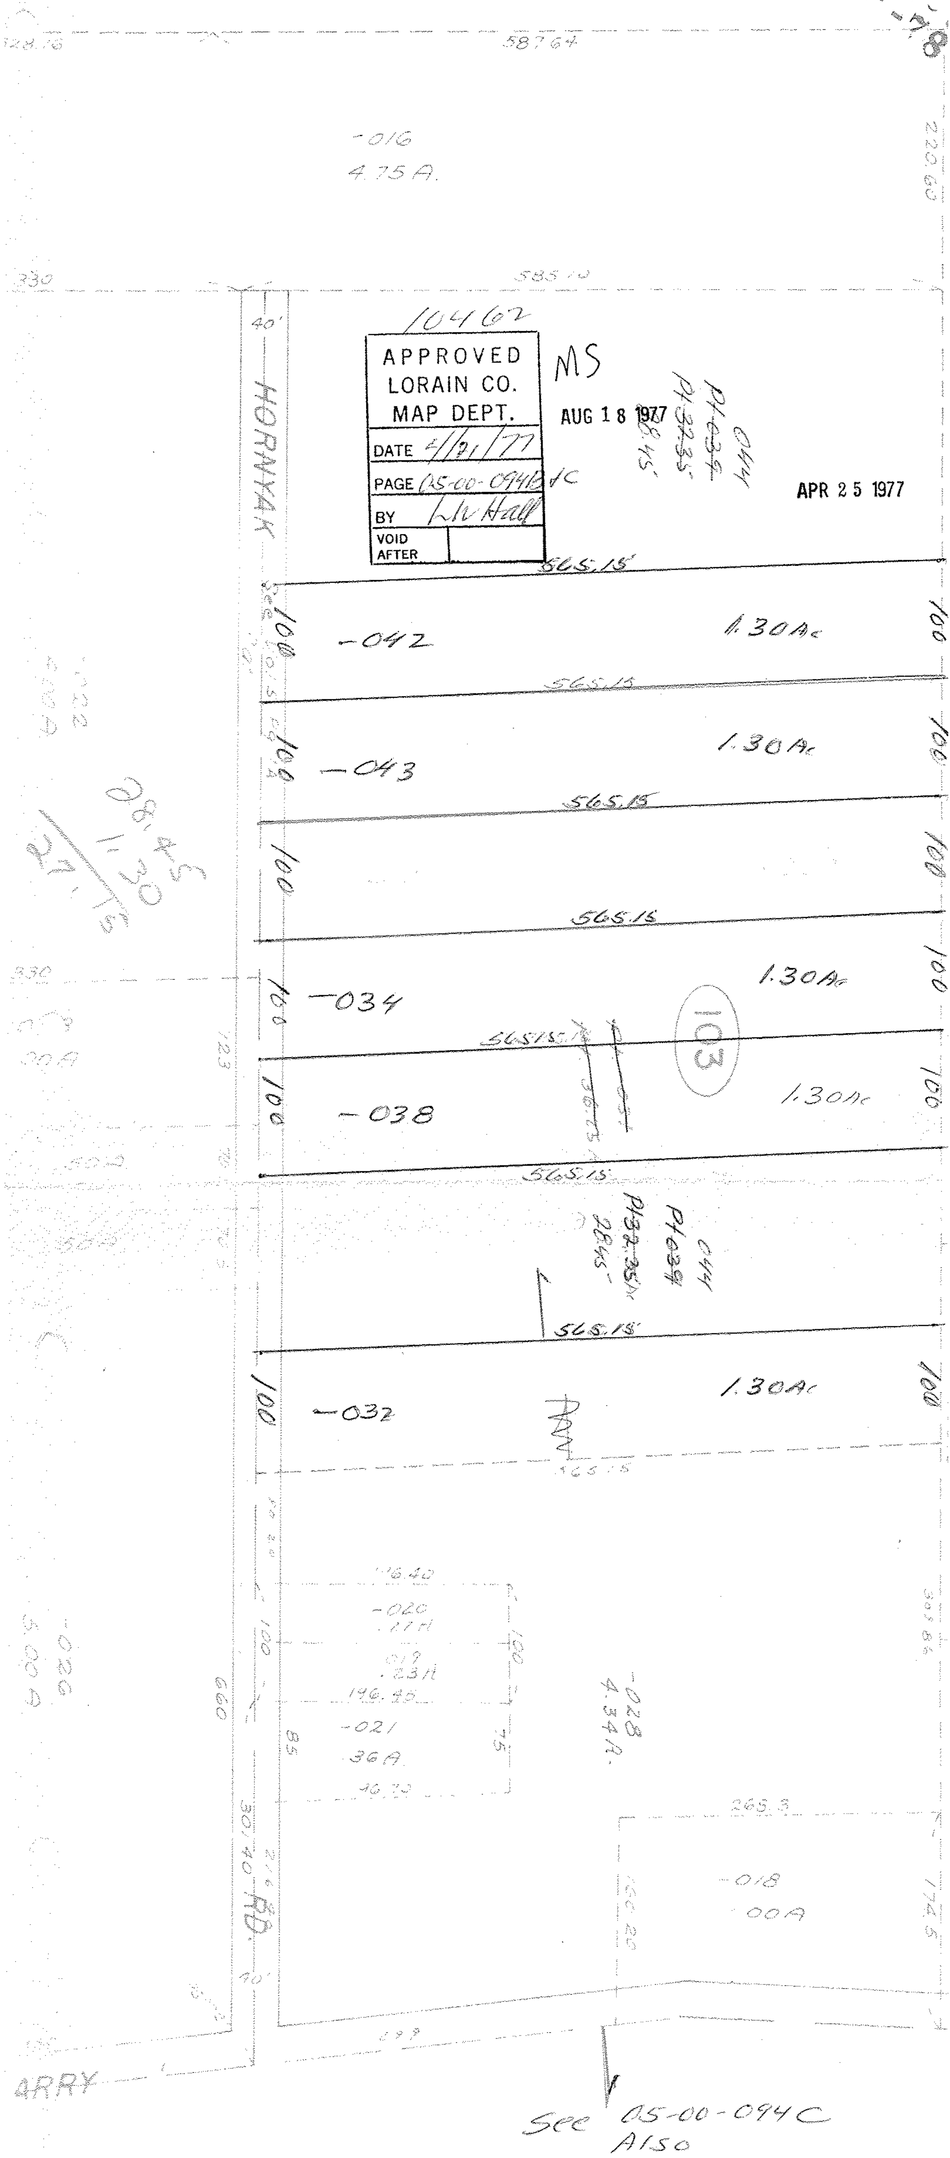

See 05-00-094C
Also