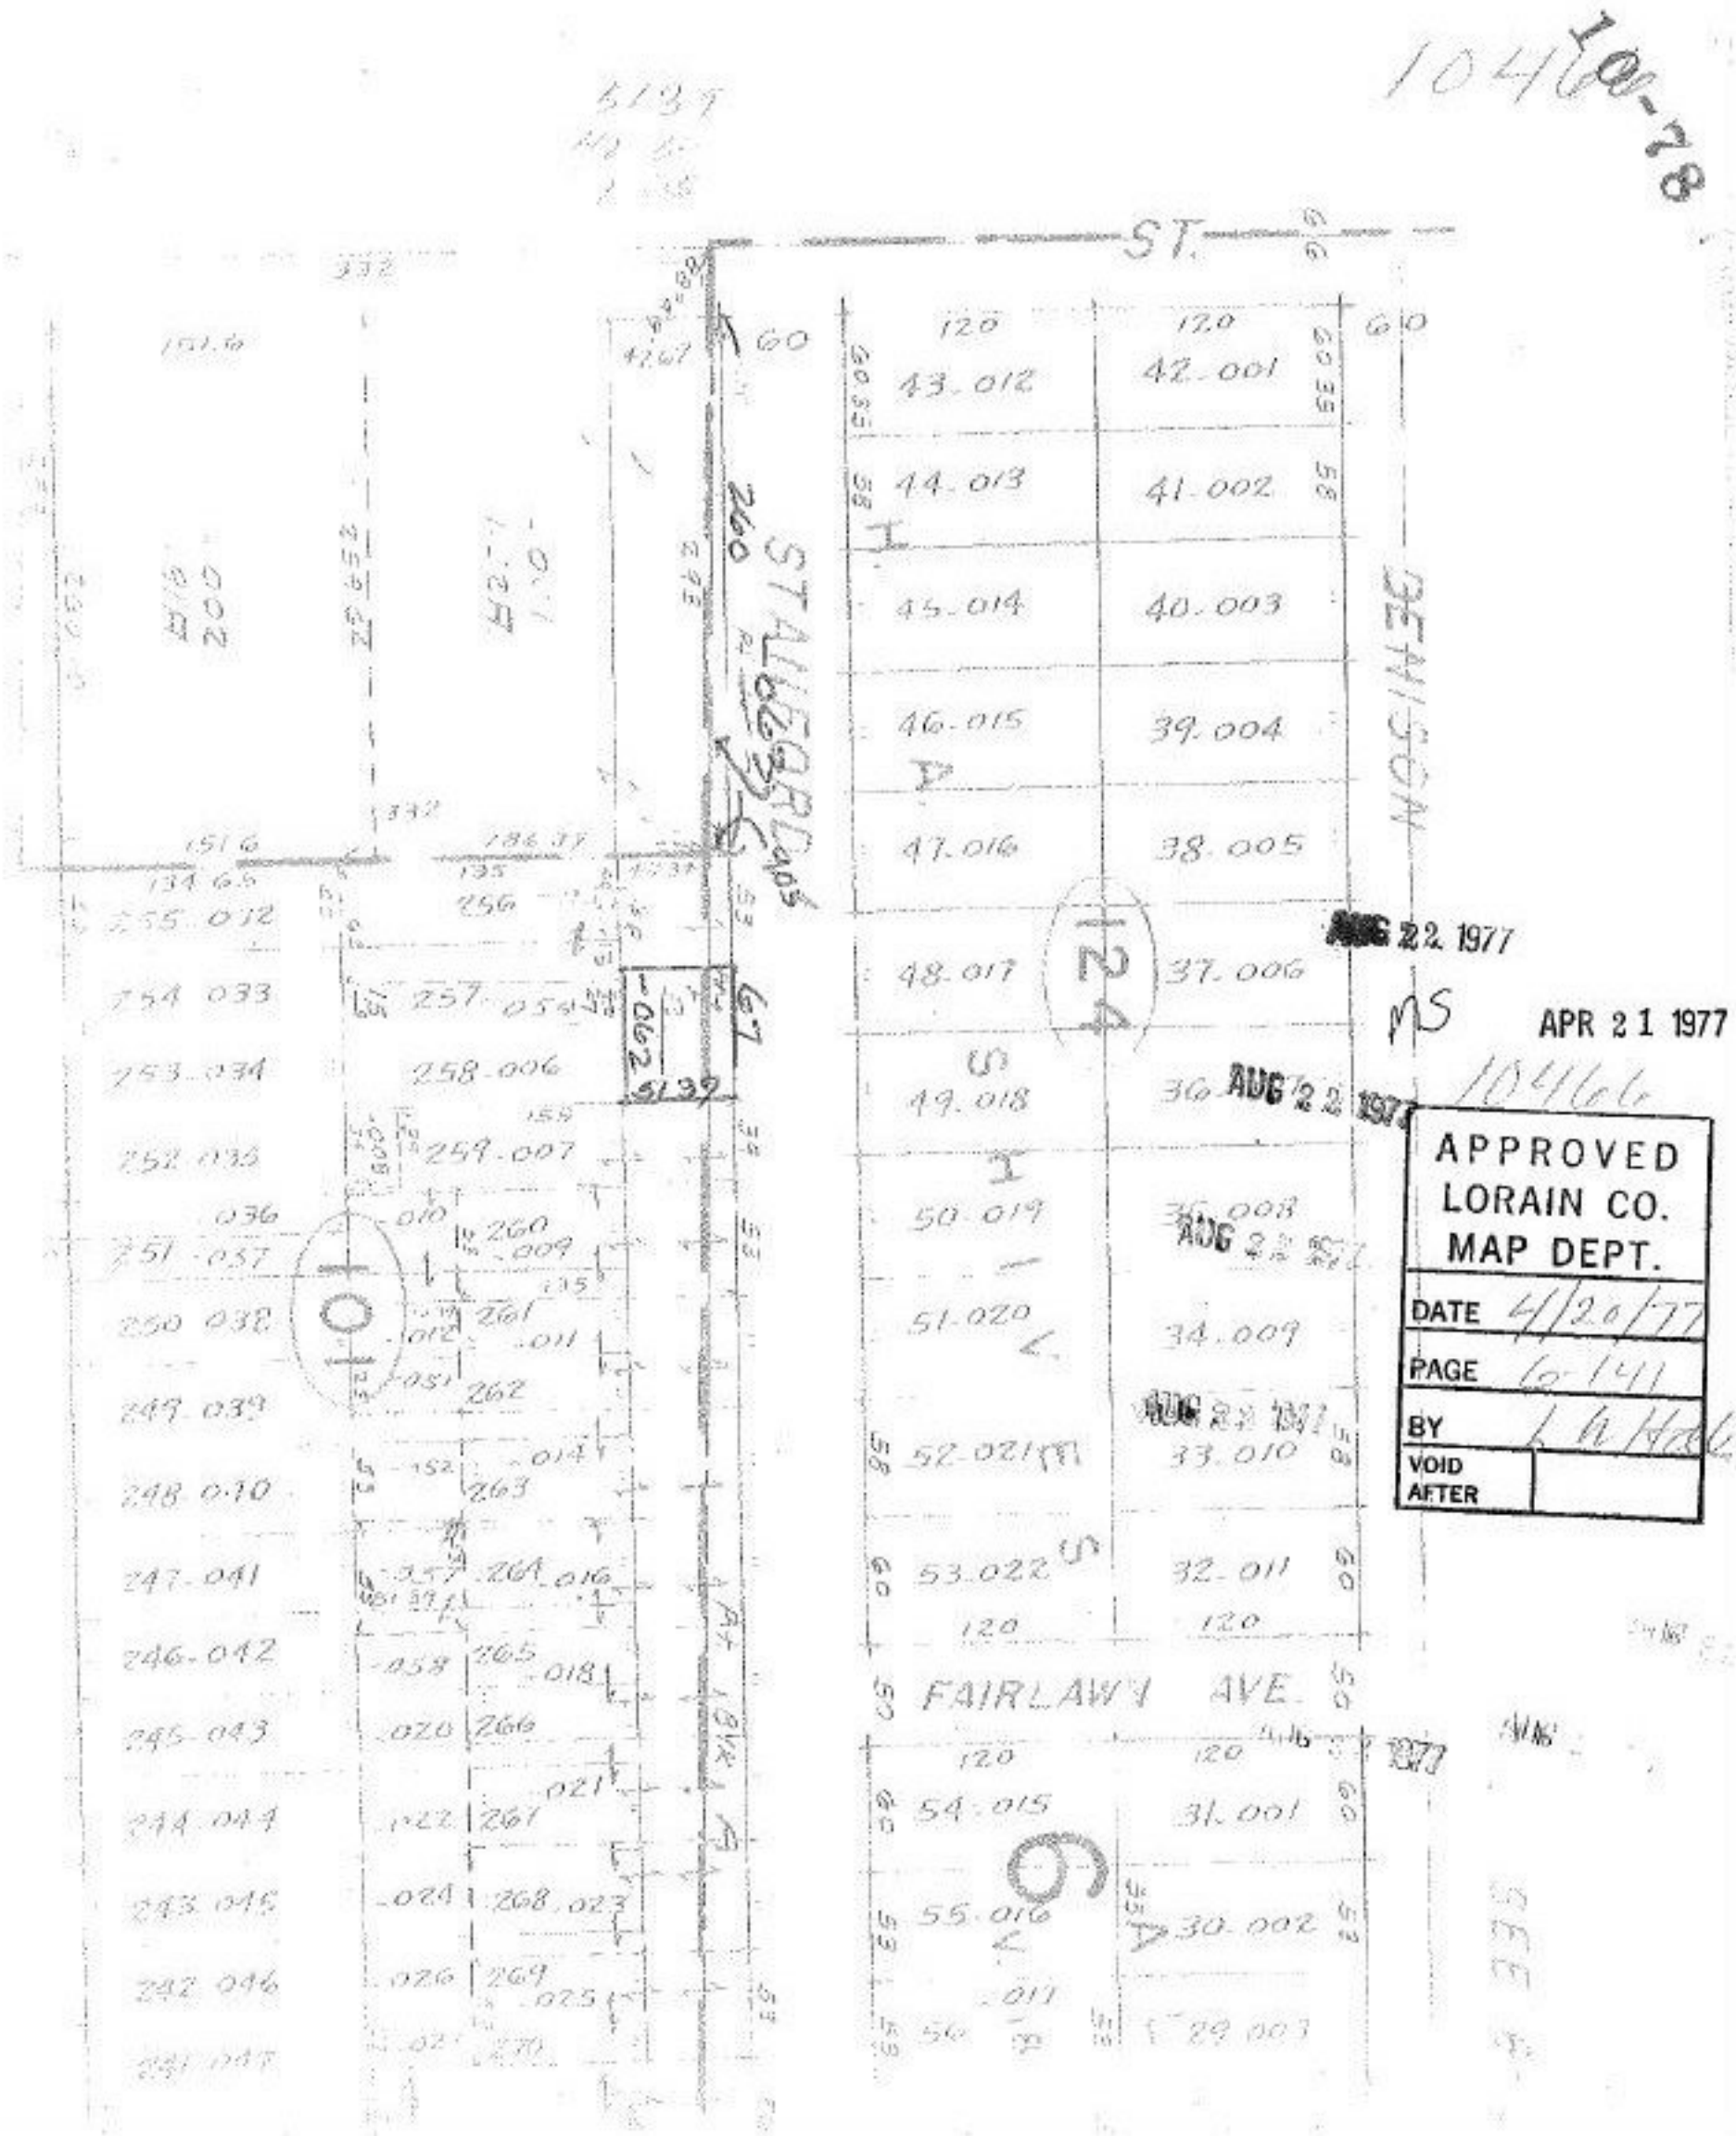

10466
10-78
ST.
STALLFORD
BENISON
FAIRLAWN AVE.
43.012
42.001
44.013
41.002
45.014
40.003
46.015
39.004
47.016
38.005
48.017
37.006
49.018
50.019
51.020
34.009
52.021
33.010
53.022
32.011
54.015
31.001
55.016
30.002
29.003
255.012
254.033
253.034
252.035
251.037
250.038
249.039
248.040
247.041
246.042
245.043
244.044
243.045
242.046
258.006
259.007
260
261
262
263
264
265
266
268
269
270
AUG 22 1977
MS
APR 21 1977
10466
APPROVED
LORAIN CO.
MAP DEPT.
DATE 4/20/77
PAGE 6-141
BY
VOID AFTER