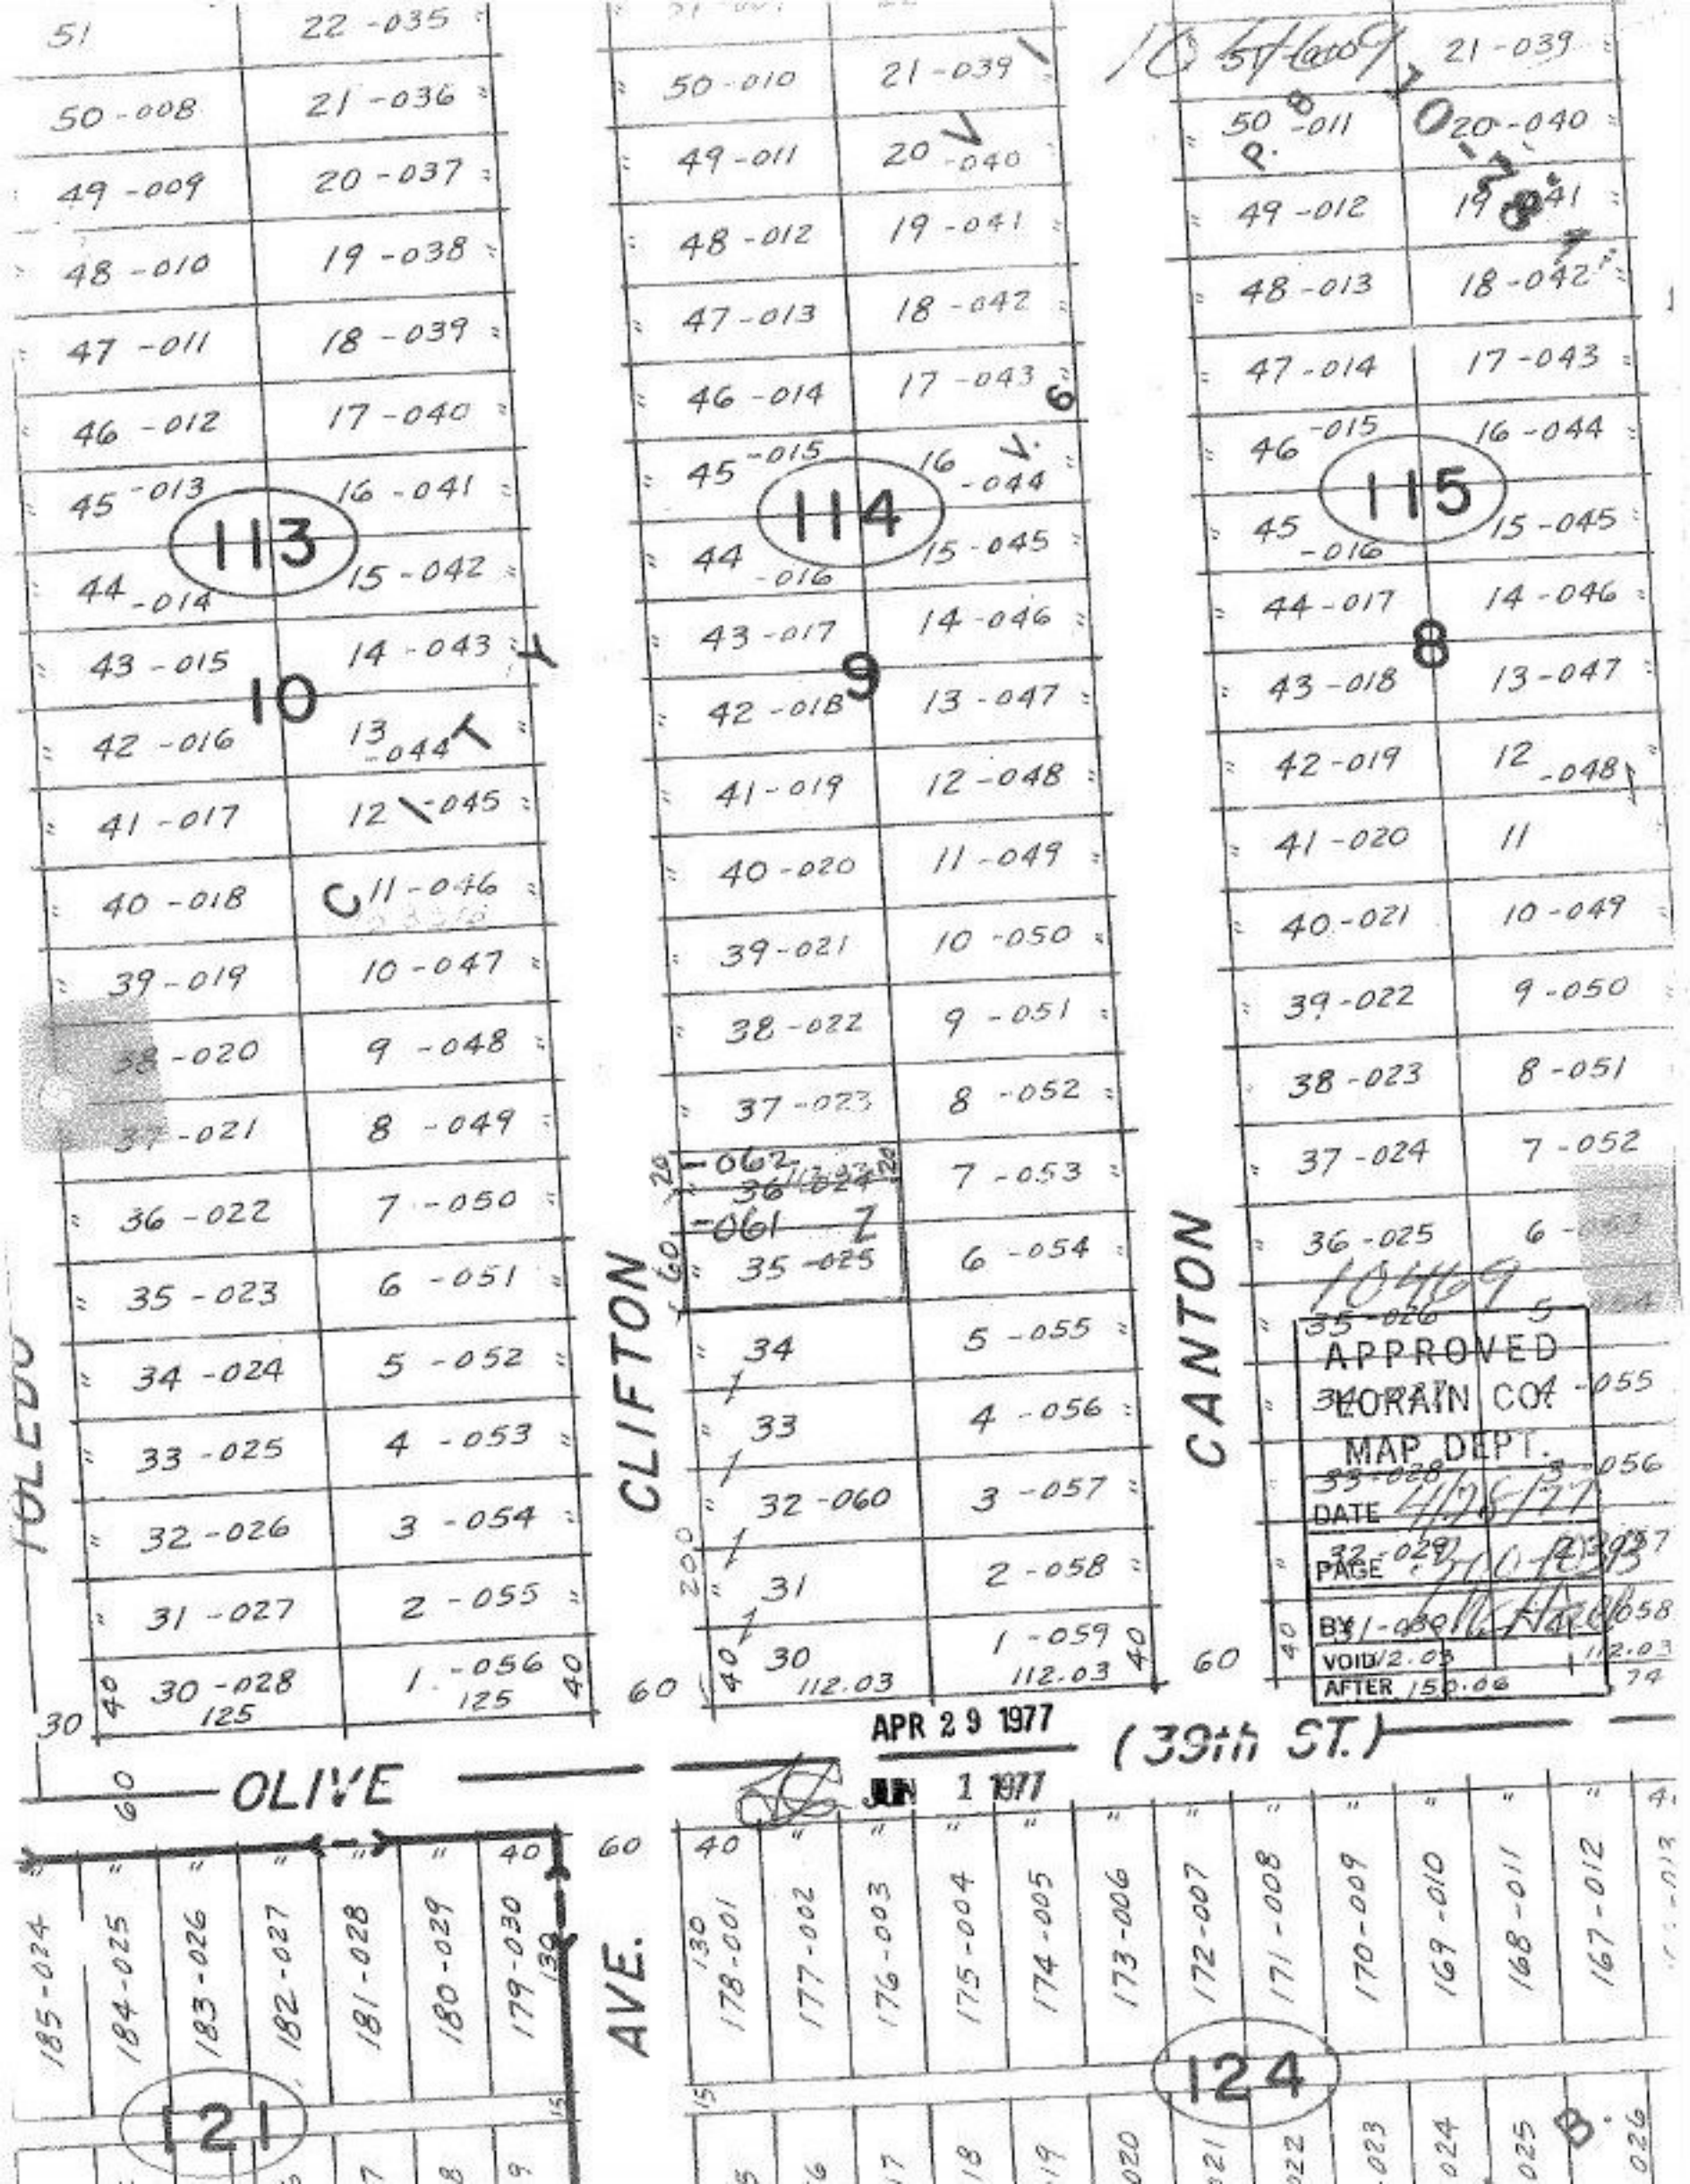

TOLEDO
CLIFTON
CANTON
OLIVE
(39th ST.)
AVE.
113
114
115
10
9
8
121
124
APPROVED
LORAIN CO.
MAP DEPT.
DATE
PAGE
BY
VOID
AFTER
APR 29 1977
JUN 1 1977