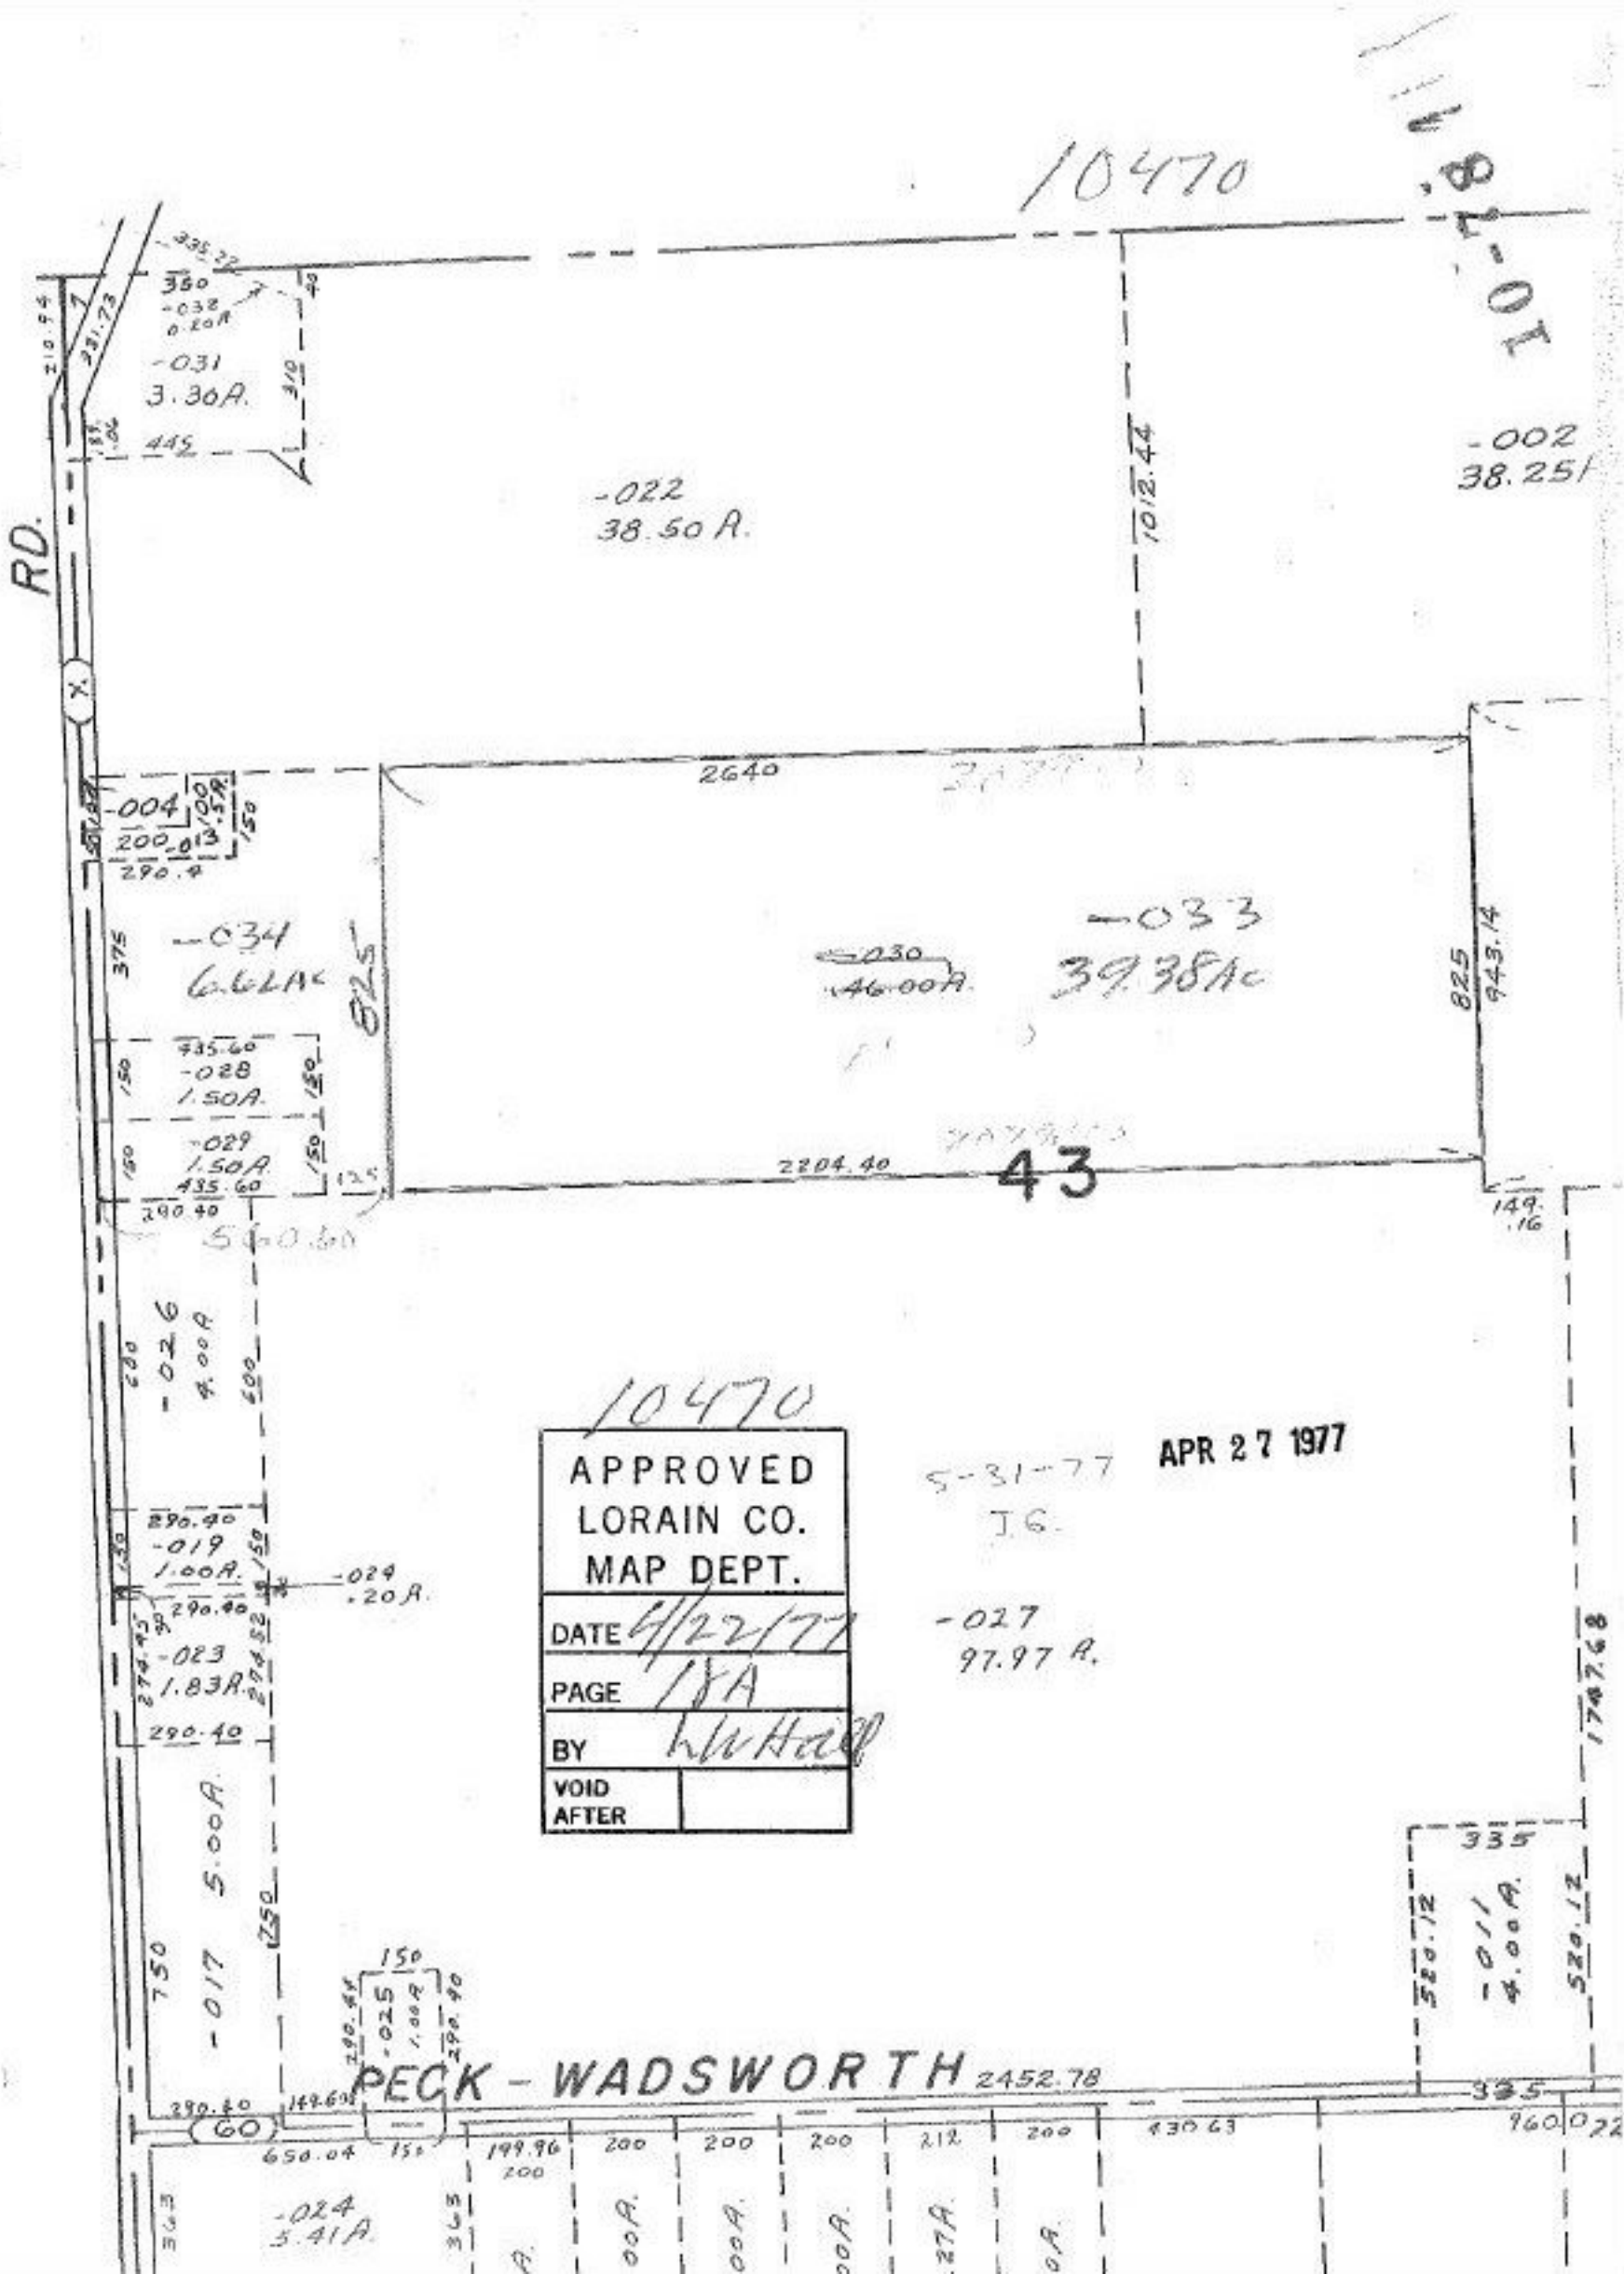
10470
10-78
RD.
-022
38.50 A.
-002
38.25
1012.44
2640
-004
200
-013
290.4
-034
6.62Ac
825
-033
39.38Ac
-030
46.00A.
825
943.14
-028
1.50A.
-029
1.50A.
435.60
2204.40
43
149.16
-026
4.00A
10470
APPROVED
LORAIN CO.
MAP DEPT.
DATE 4/22/77
PAGE 18A
BY
VOID AFTER
5-31-77
J.G.
APR 27 1977
-027
97.97 A.
-019
1.00A.
-024
.20A.
-023
1.83A.
-017
5.00A.
1747.68
335
-011
4.00A.
520.12
PECK - WADSWORTH
2452.78
335
960.0
60
650.04
199.96
200
200
200
212
200
430.63
-024
5.41A.