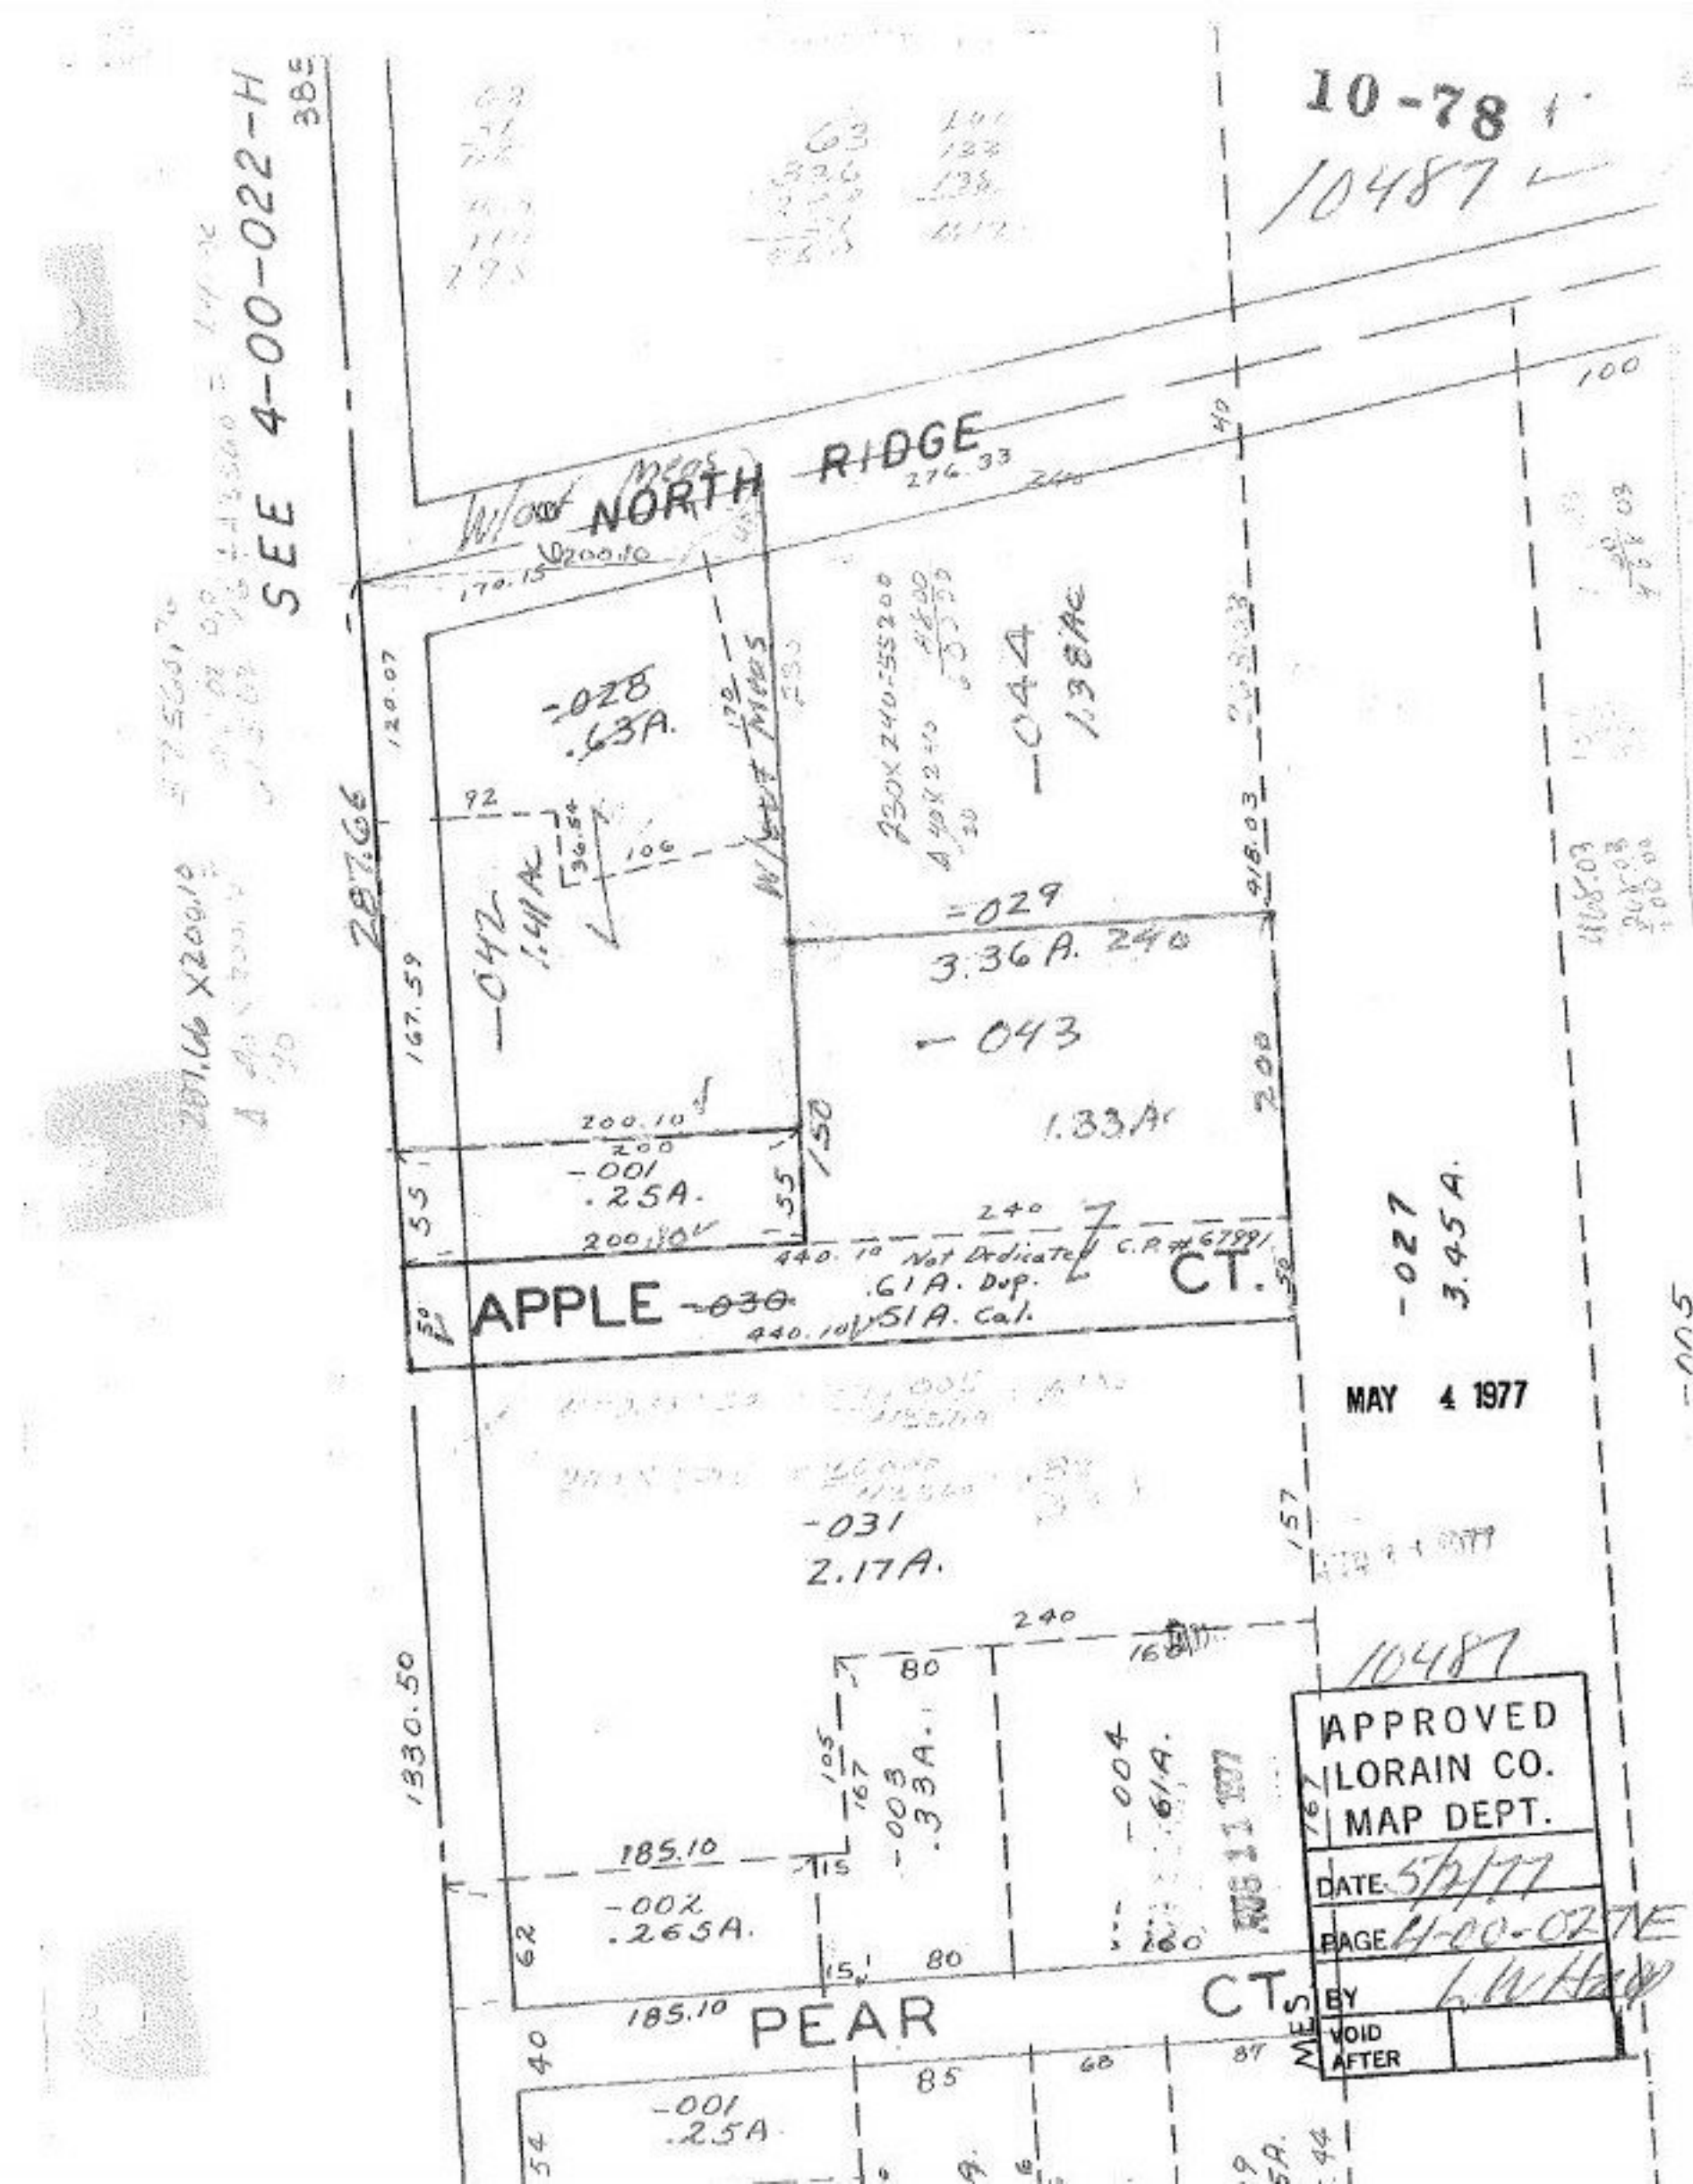
10-78
10487
SEE 4-00-022-H
NORTH RIDGE
W/out Meas
276.33
200.10
170.15
120.07
287.66
-028
.63A.
-042
1.41Ac
-044
1.38Ac
-029
3.36A. 240
-043
1.33Ac
-001
.25A.
200.10
440.10 Not Dedicated C.P.#67991
.61A. Dup.
.51A. Cal.
APPLE -030 CT.
-027
3.45A.
MAY 4 1977
-031
2.17A.
1330.50
185.10
-002
.265A.
-003
.33A.
-004
.61A.
PEAR CT.
-001
.25A
10487
APPROVED
LORAIN CO.
MAP DEPT.
DATE 5/2/77
PAGE 4-00-022E
BY L.W. Hay
VOID AFTER