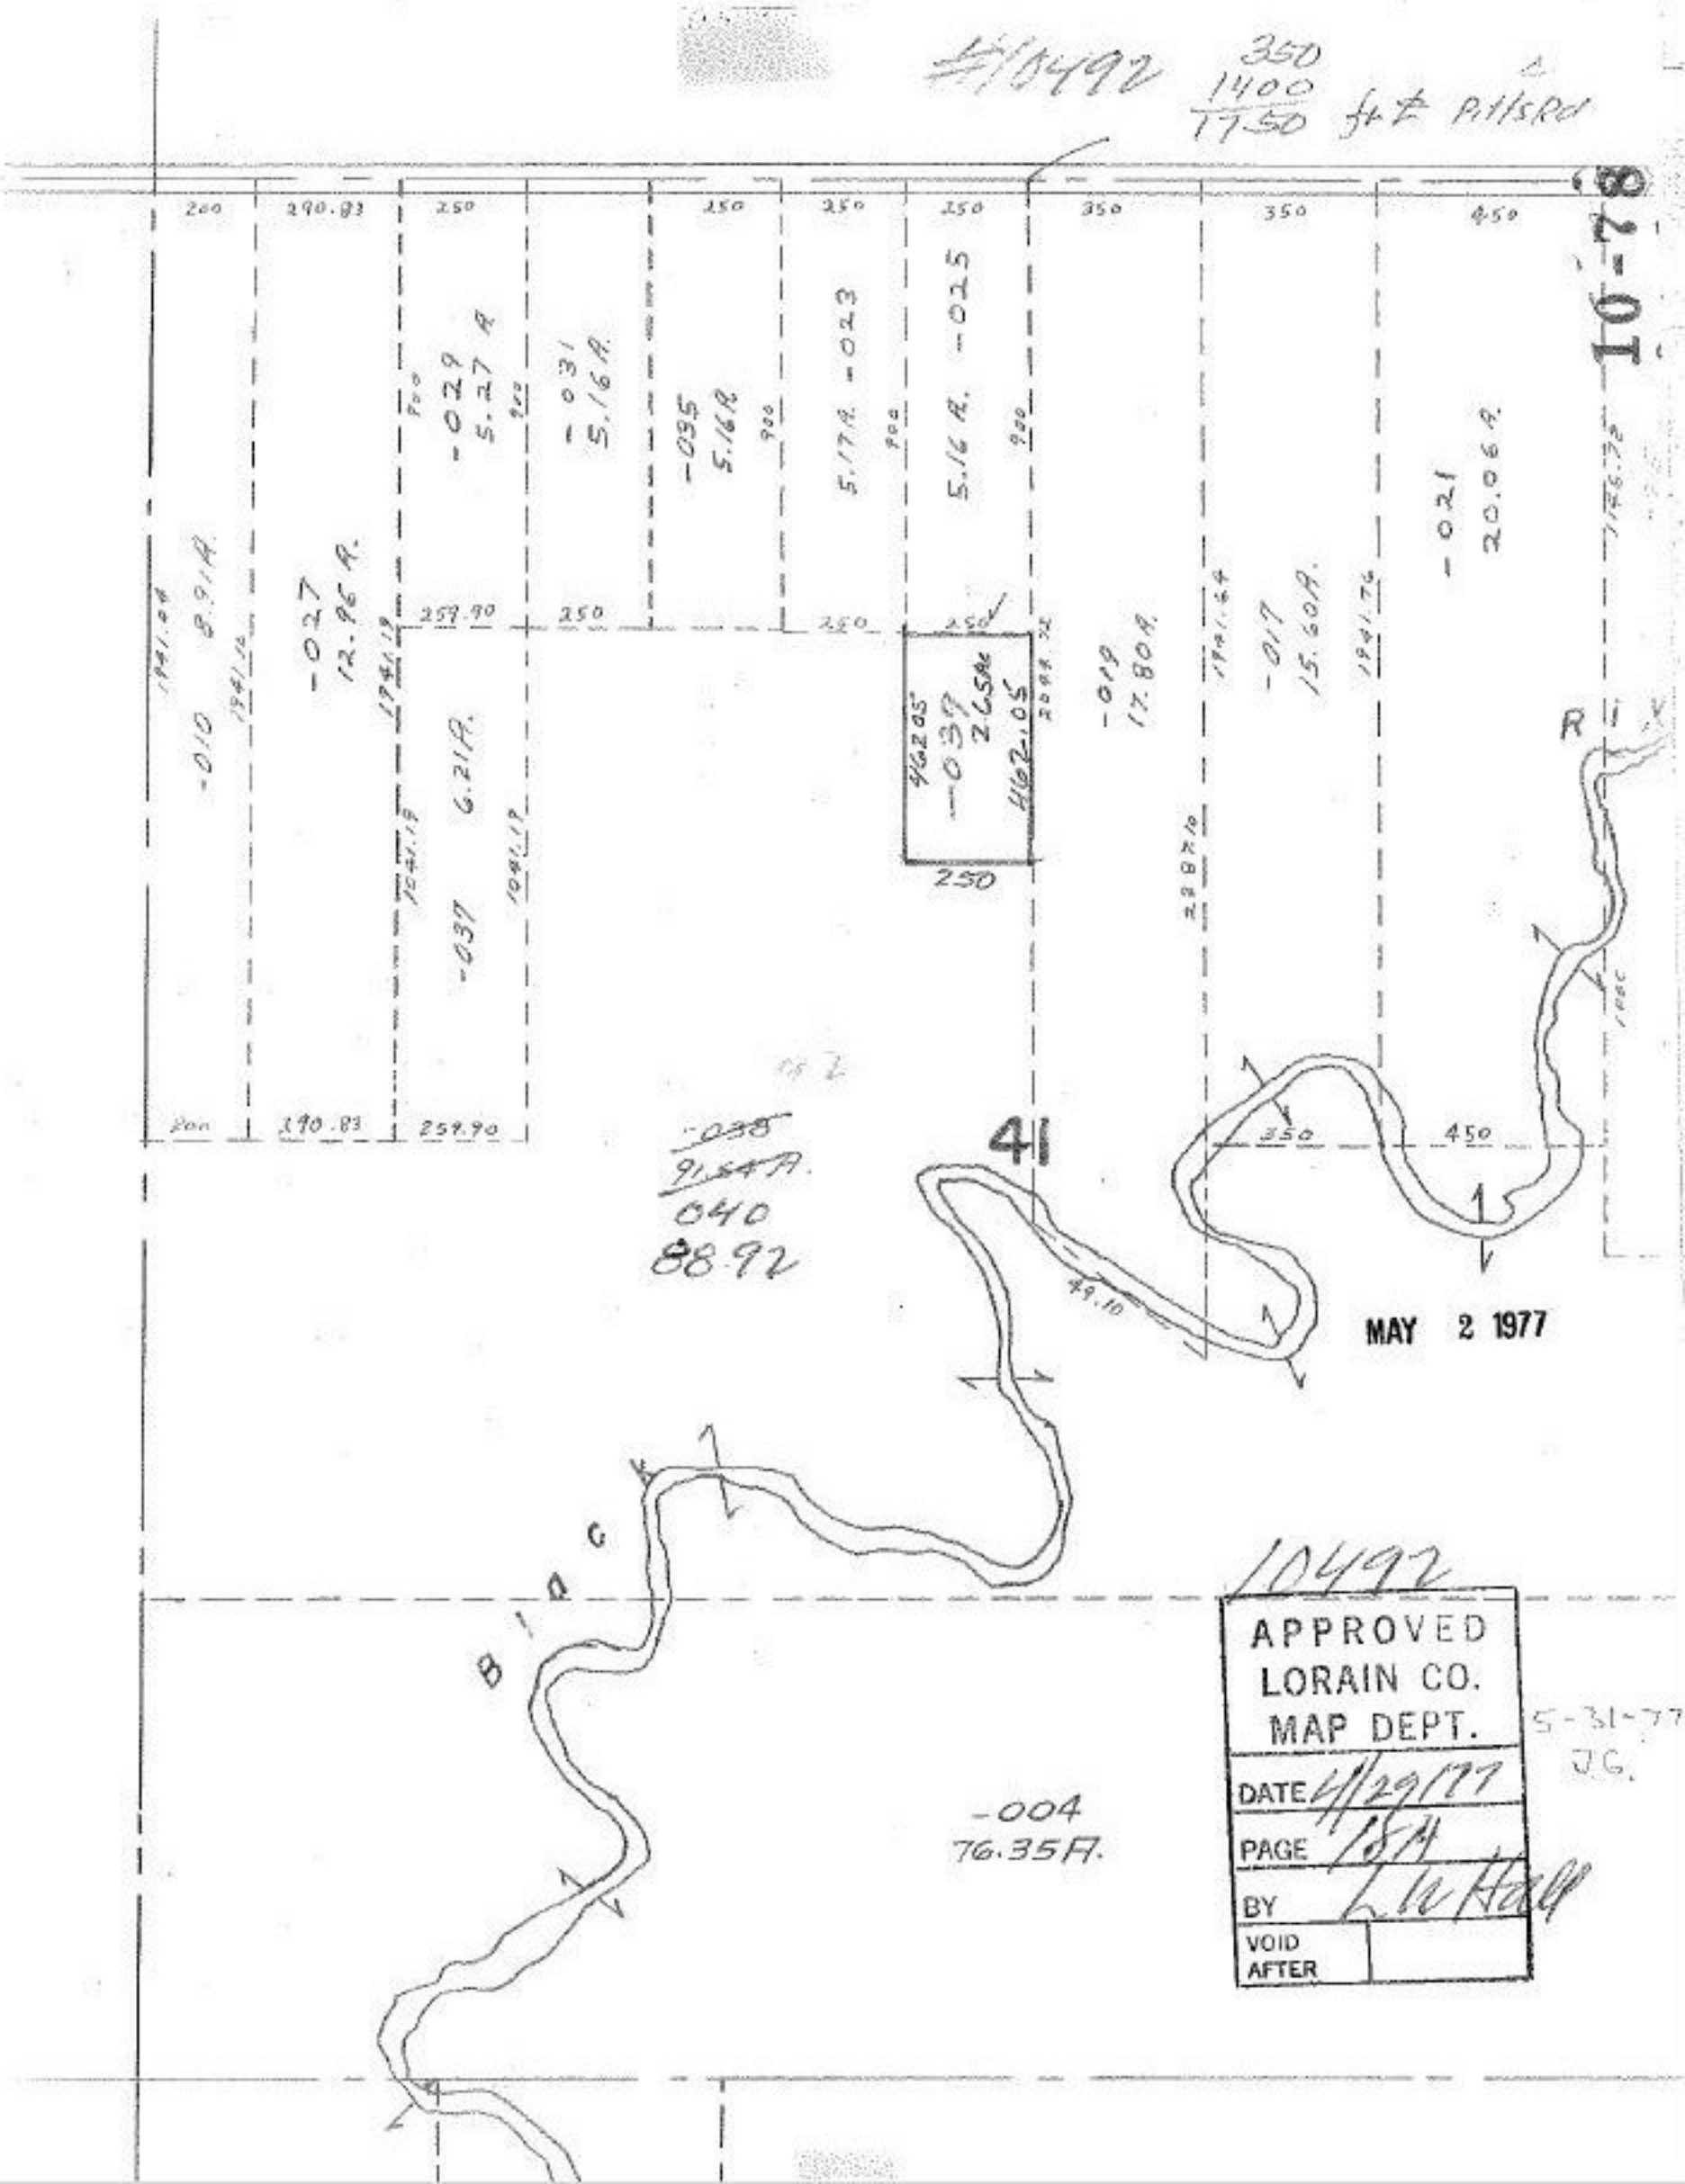

#10492
350
1400
1750 ft ± Pitts Rd
10-78
200
290.83
250
250
250
250
350
350
450
-010 8.91A.
-027 12.96A.
-029 5.27A.
-031 5.16A.
-035 5.16A.
5.17A. -023
5.16A. -025
-021 20.06A.
-037 6.21A.
-039 2.65Ac
462.05
-019 17.80A.
-017 15.60A.
259.90
250
250
250
250
290.83
259.90
350
450
41
~~-038~~
~~91.54A.~~
040
88.92
49.10
MAY 2 1977
Black
-004
76.35A.
10492
APPROVED
LORAIN CO.
MAP DEPT.
DATE 4/29/77
PAGE 18A
BY L.W. Hall
VOID AFTER
5-31-77
J.G.