10493-78

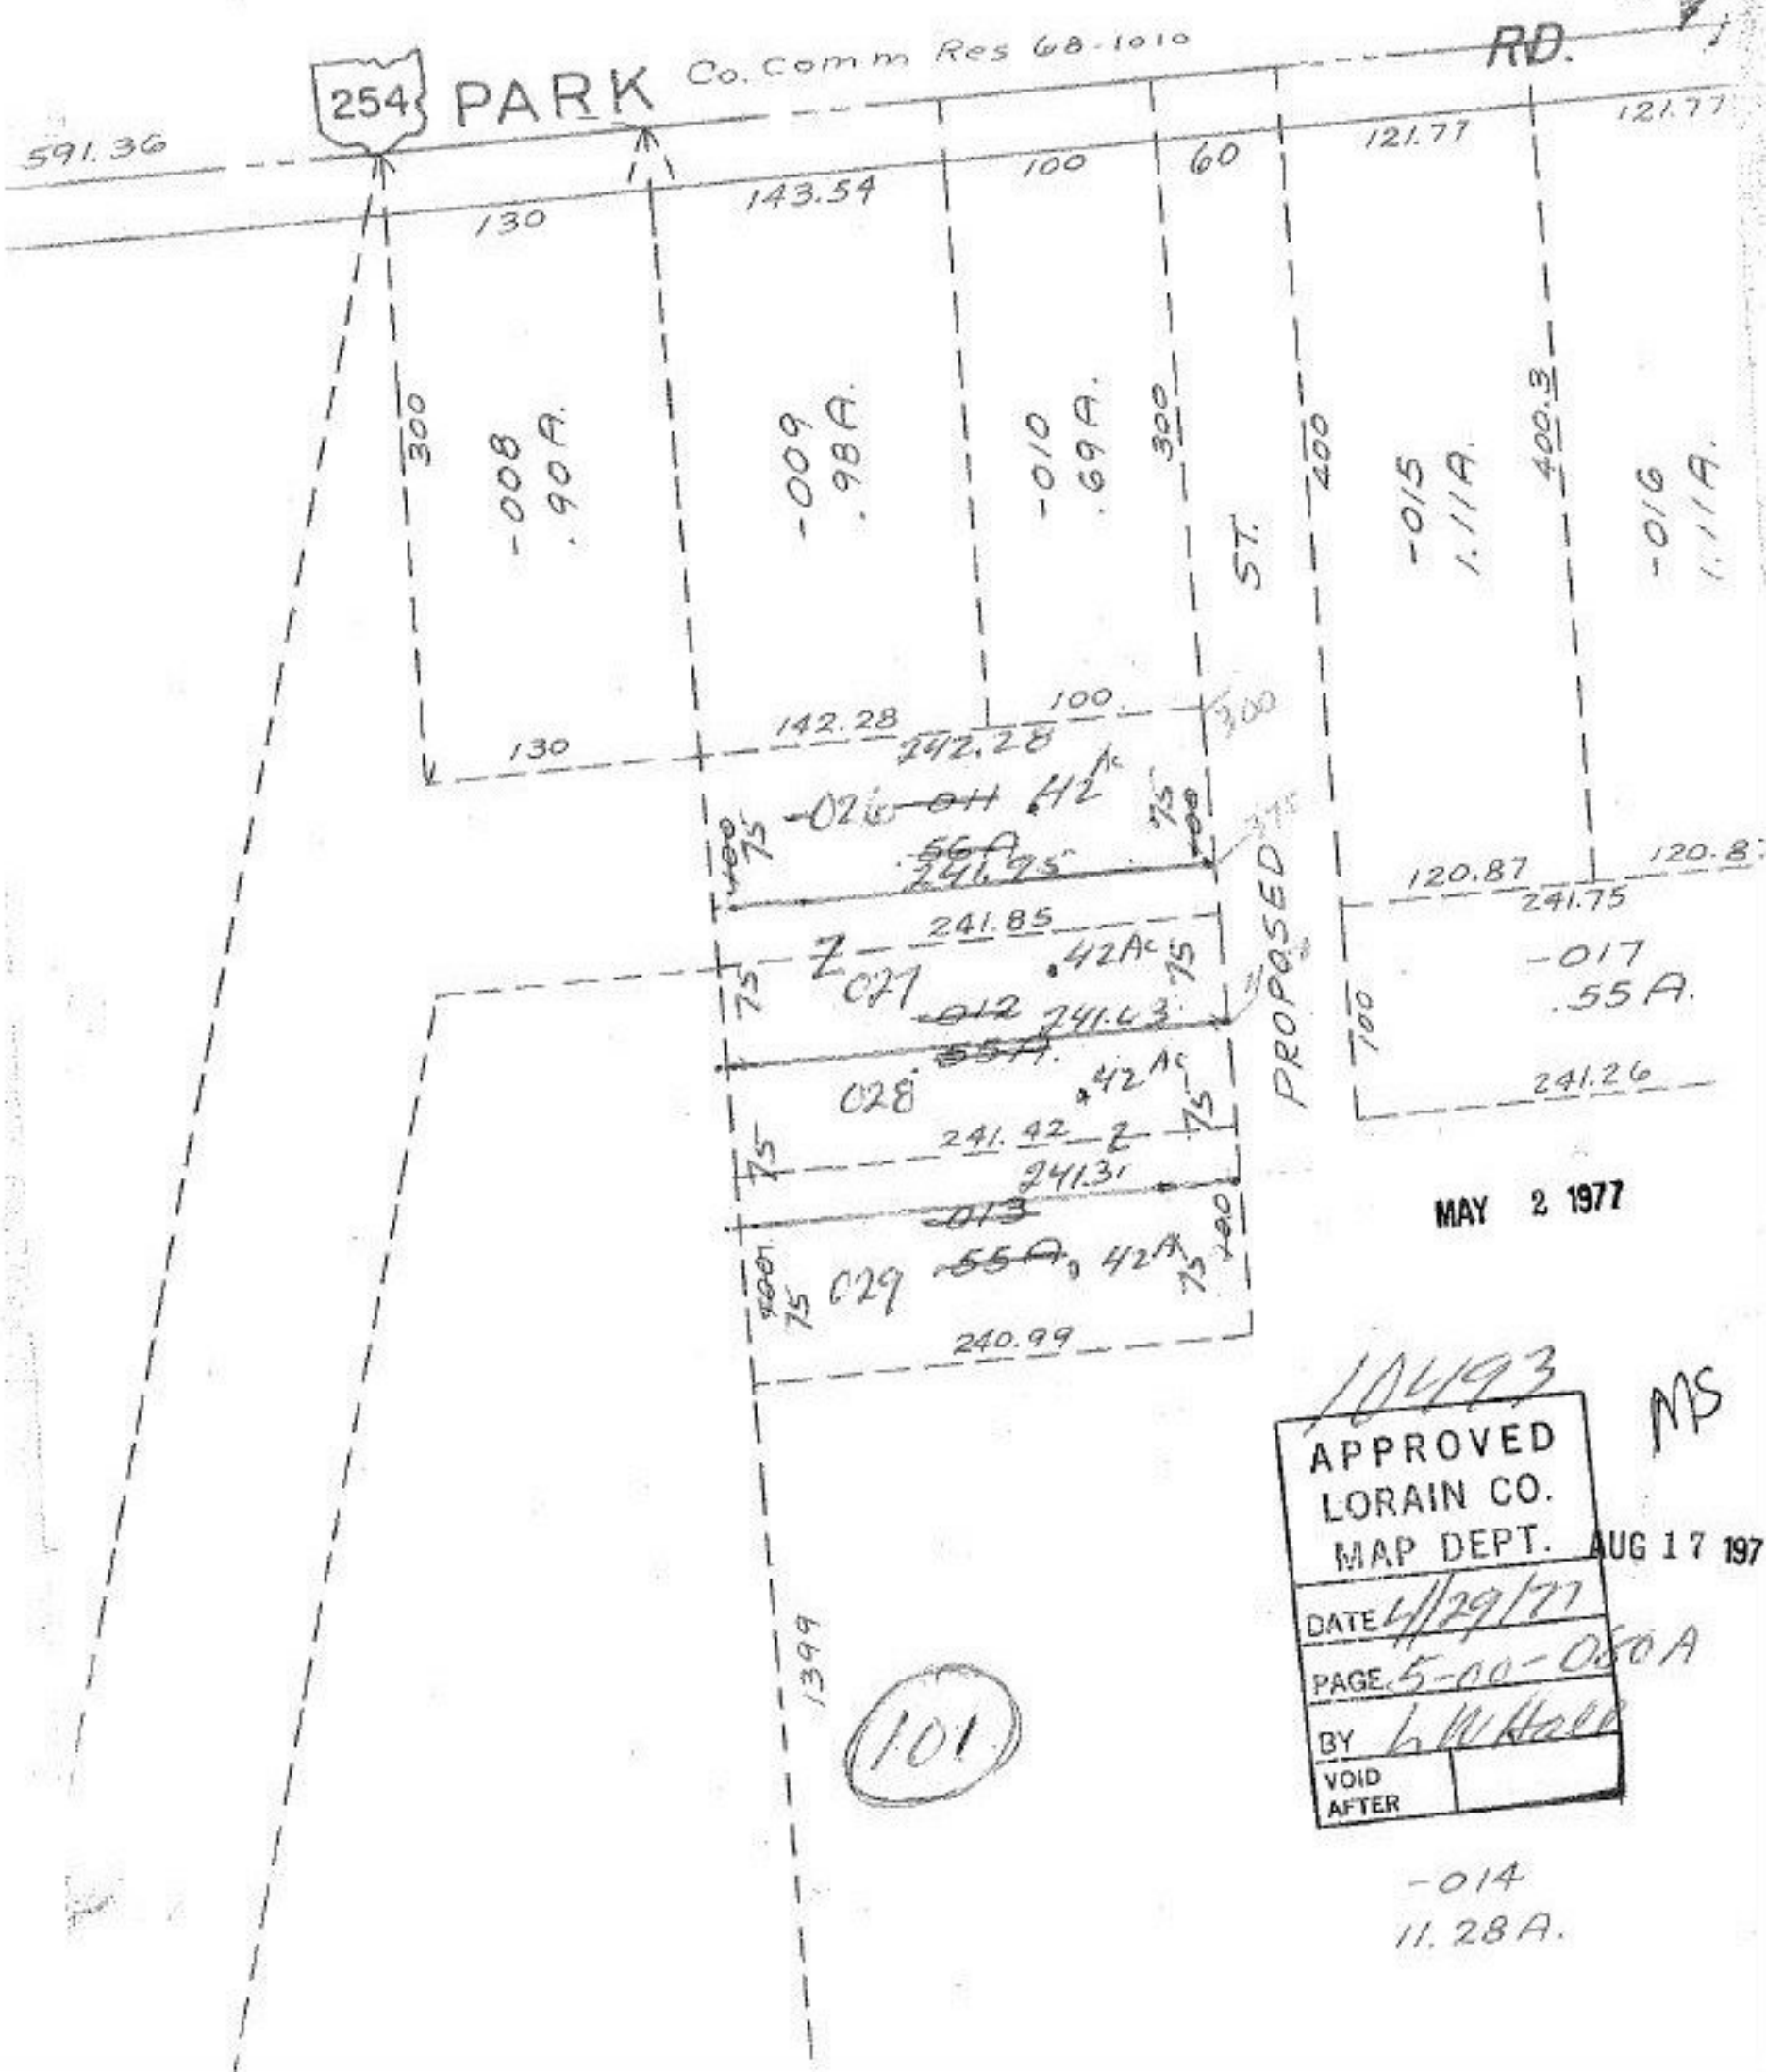

10493

MS

APPROVED
LORAIN CO.
MAP DEPT.
AUG 17 197
DATE 4/29/77
PAGE 5-00-050A
BY L W Hall
VOID AFTER