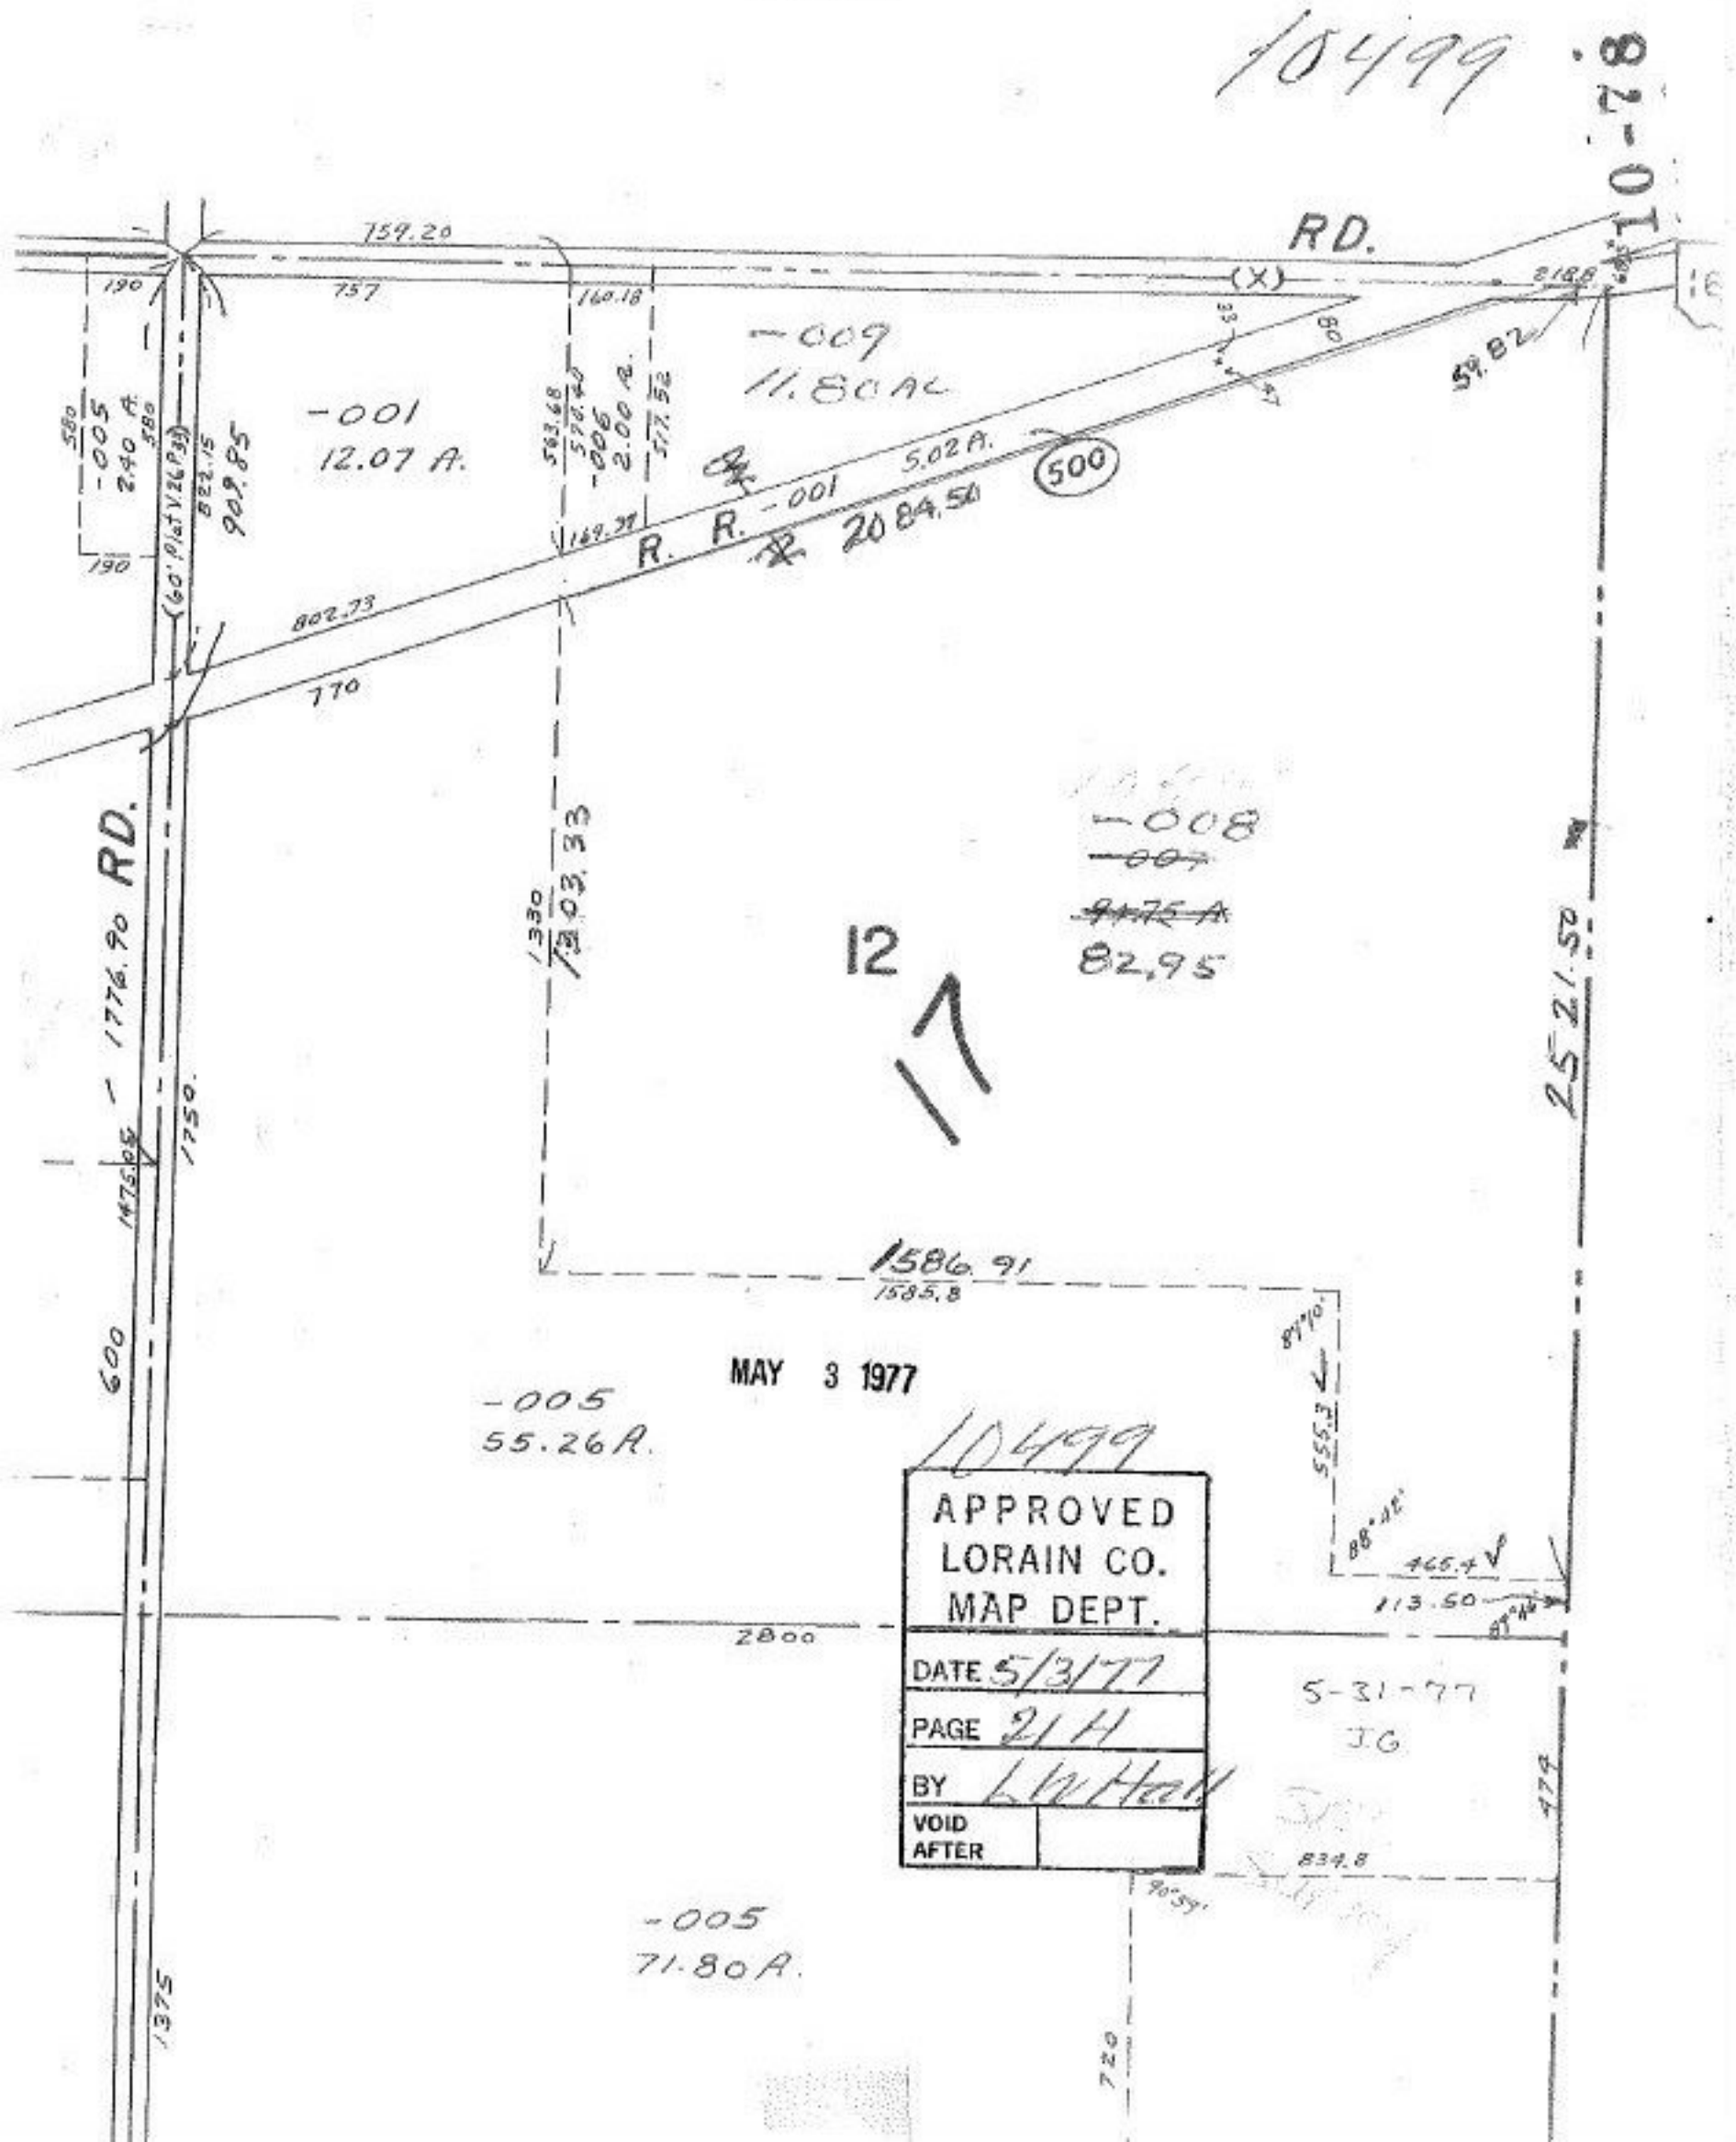
10499
10-78
RD.
759.20
757
190
160.18
-009
11.80 AC
-001
12.07 A.
-005
2.40 A.
909.85
-006
2.00 A.
5.02 A.
R. R. -001
2084.50
500
59.82
802.73
770
RD.
1776.90
1750.
1330
1303.33
-008
82.95
12
1586.91
1585.8
25 21.50
MAY 3 1977
-005
55.26 A.
10499
APPROVED
LORAIN CO.
MAP DEPT.
DATE 5/3/77
PAGE 21 H
BY L.W. Hall
VOID AFTER
2800
5-31-77
JG
465.4
113.50
834.8
-005
71.80 A.
1375
720
474