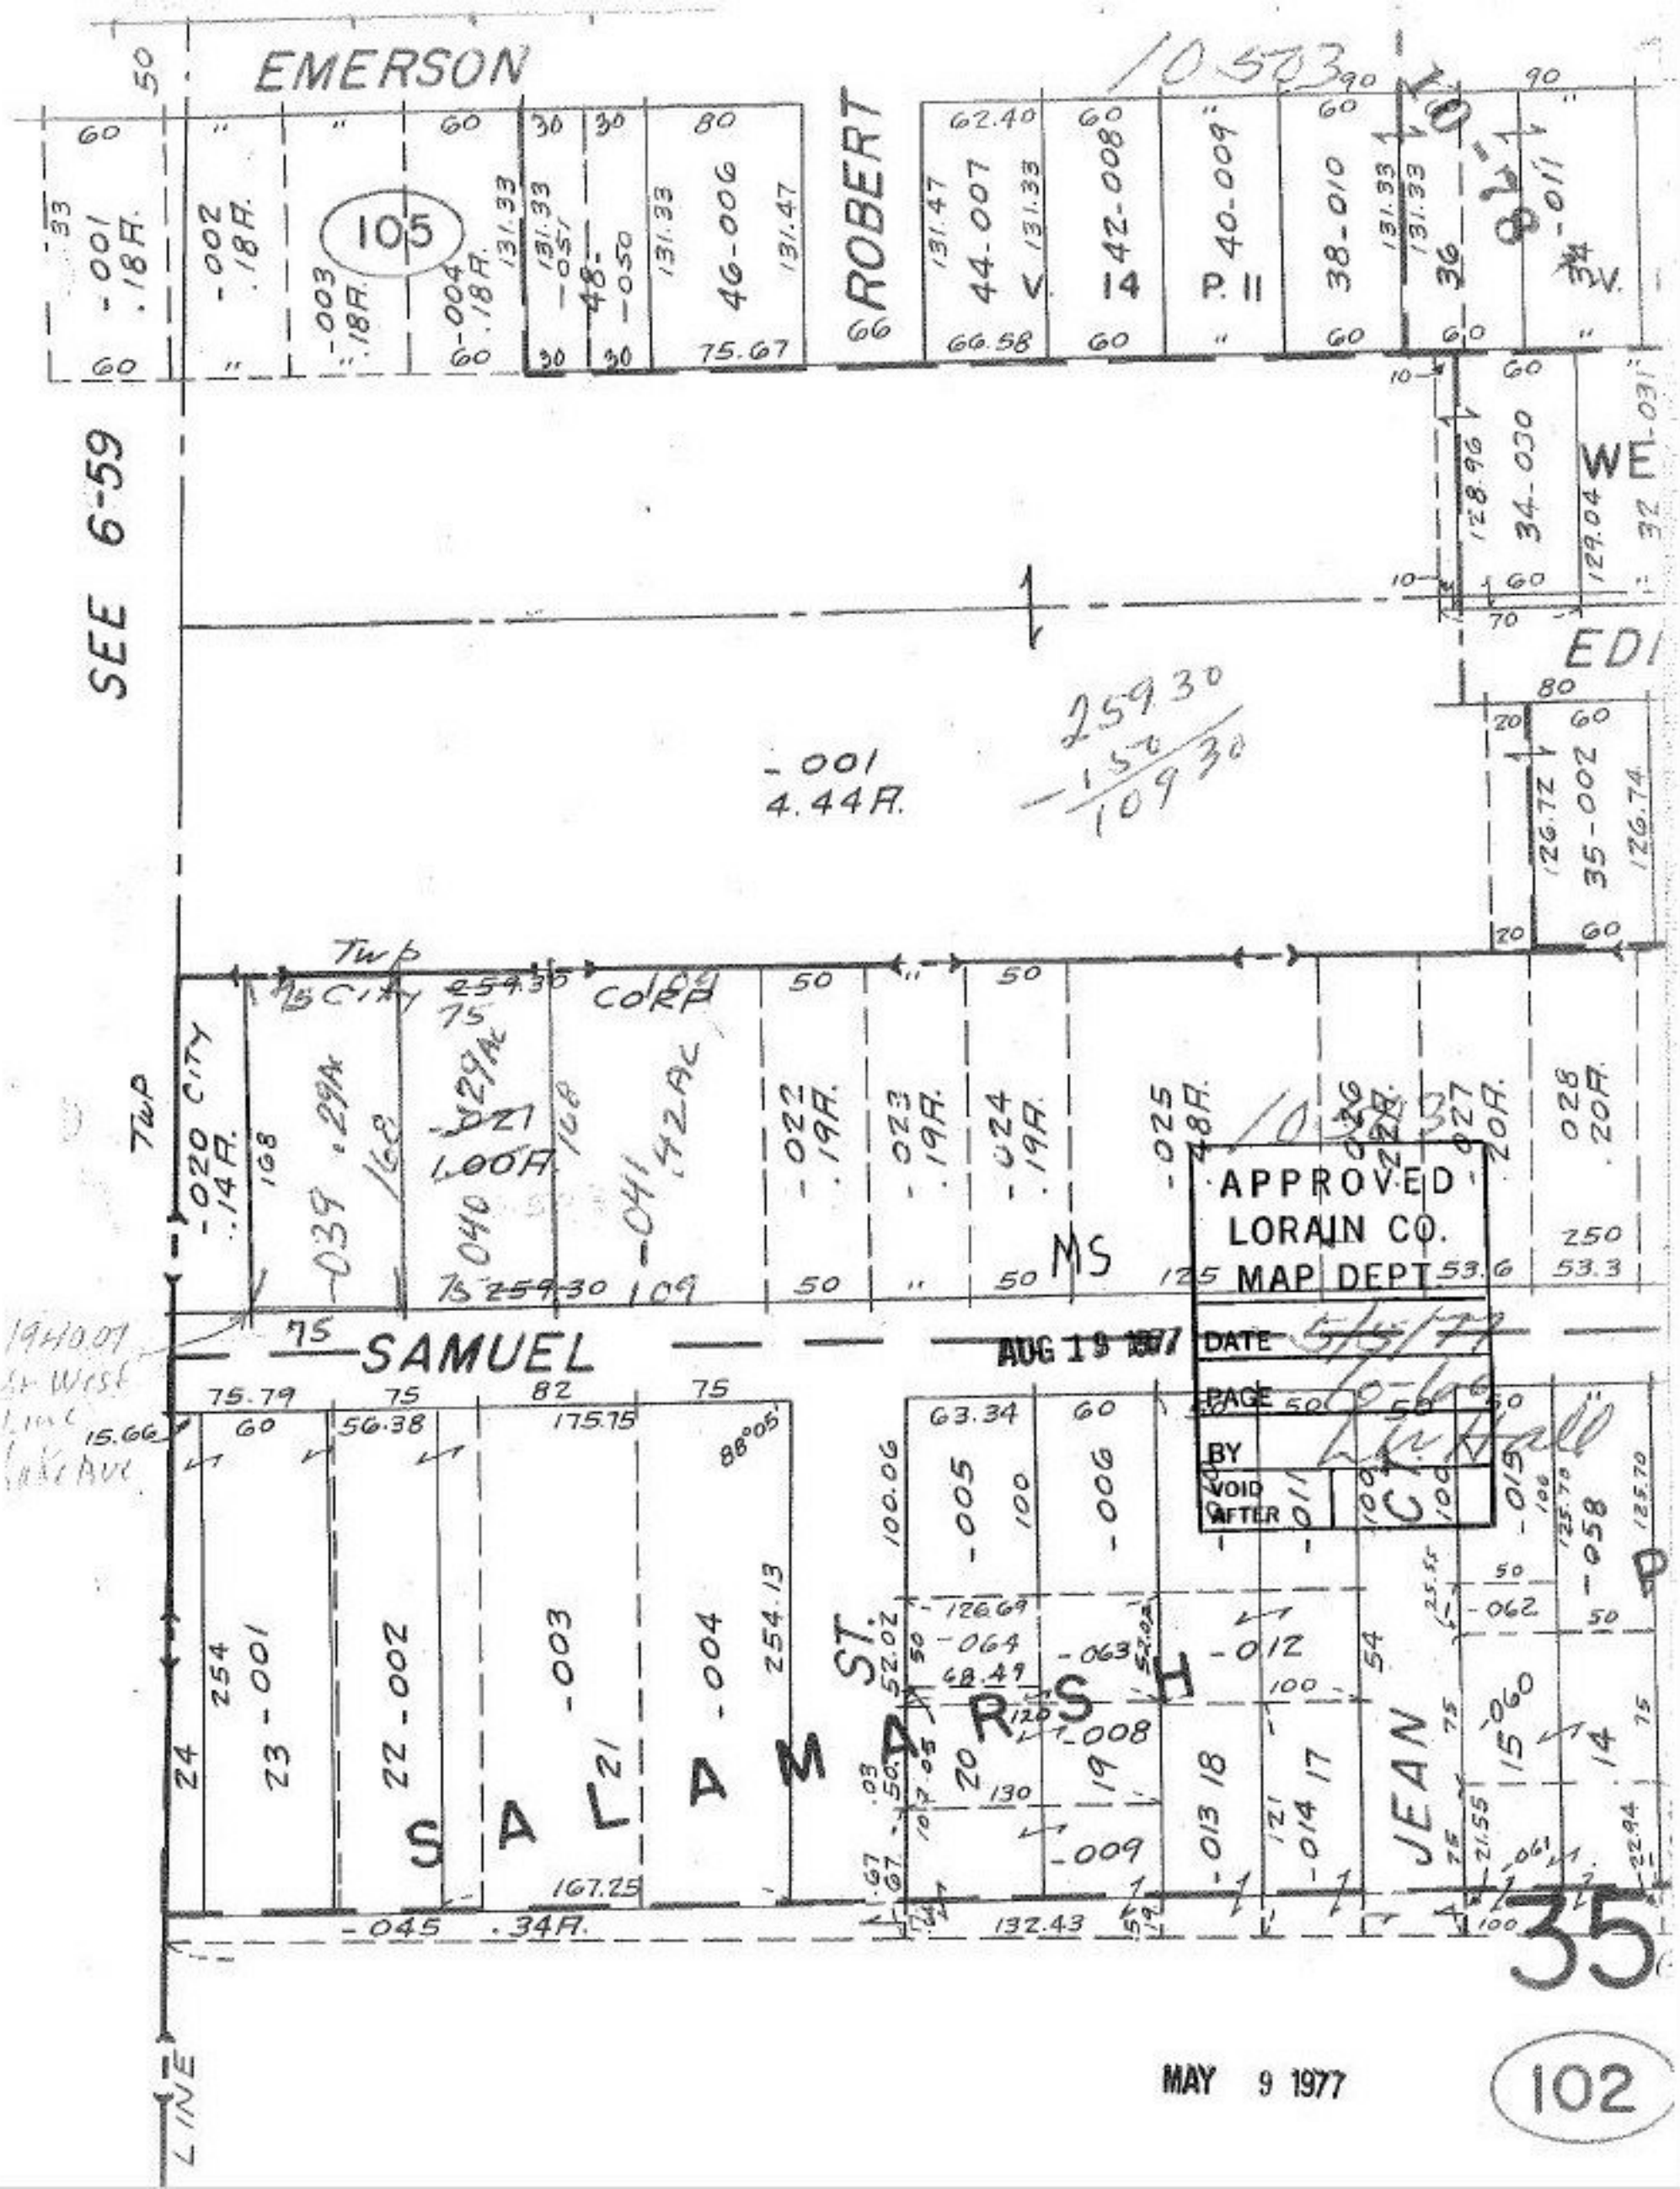
EMERSON
ROBERT
SAMUEL
SALAMARSH ST.
JEAN
SEE 6-59
105
-001 4.44A.
25930
-150
10930
10503
10-78
APPROVED
LORAIN CO.
MAP DEPT.
DATE
PAGE
BY
VOID AFTER
AUG 19 1977
MAY 9 1977
35
102