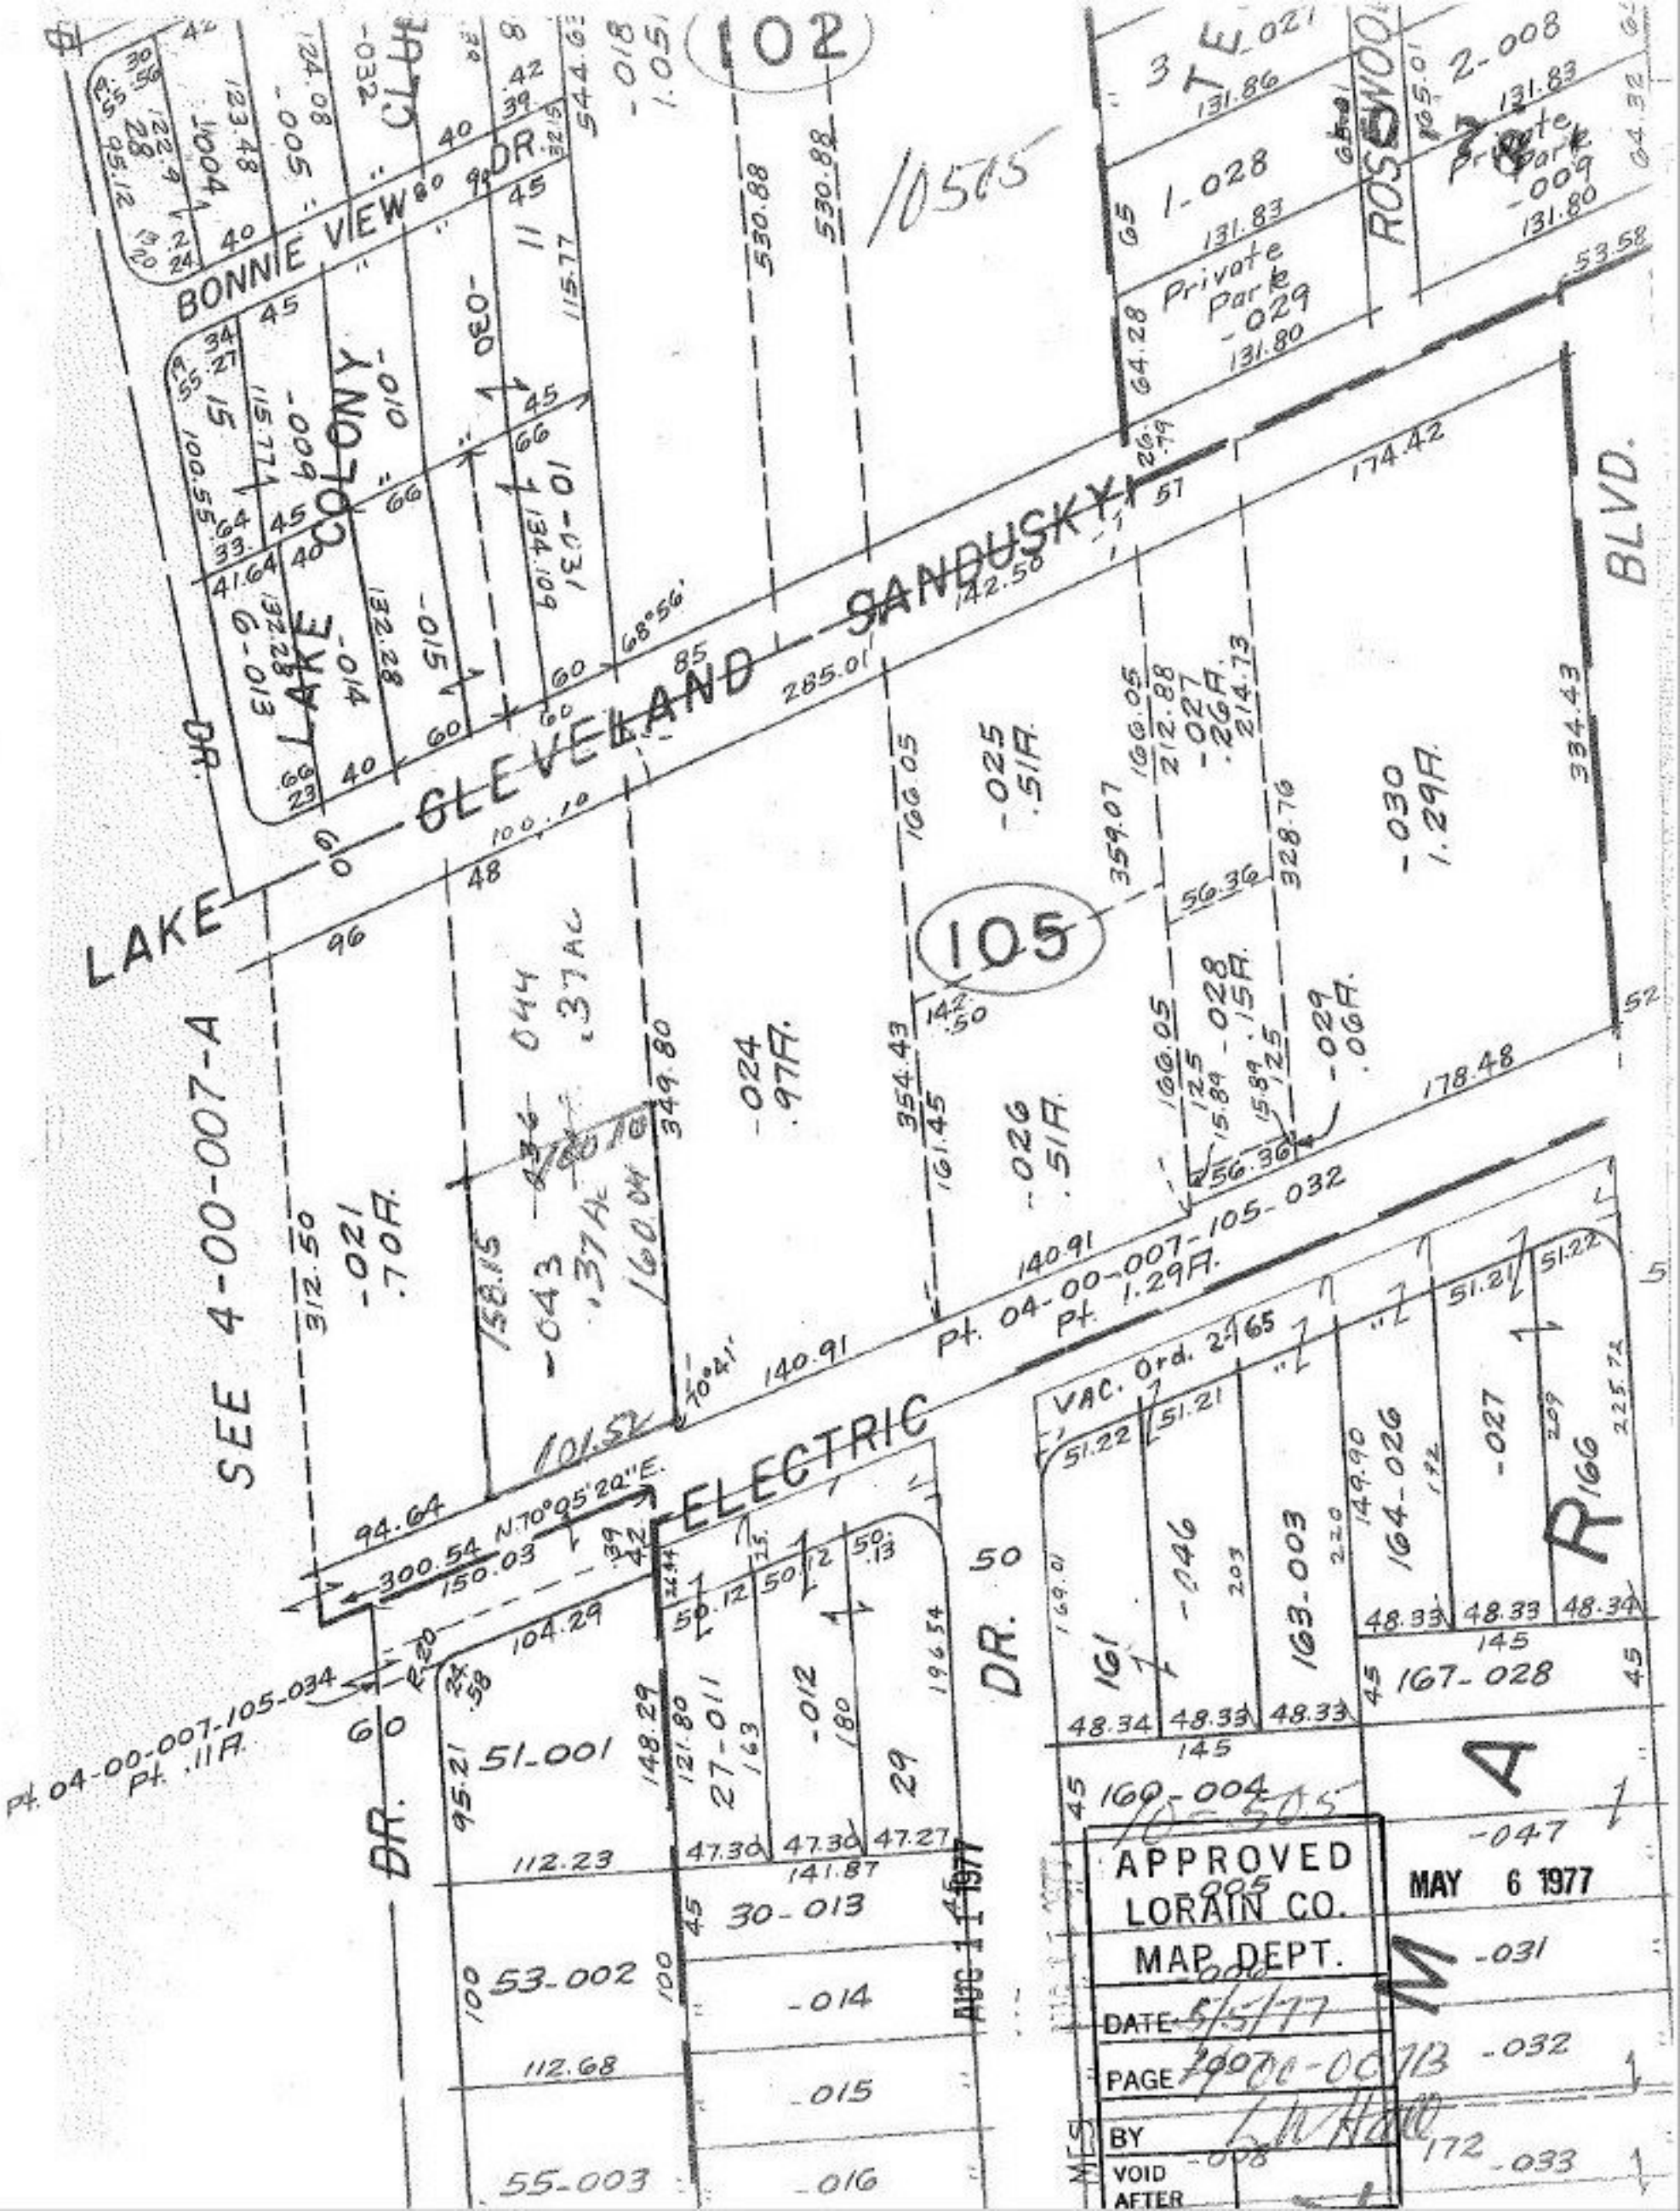

102
105
BONNIE VIEW DR.
LAKE COLONY
LAKE CLEVELAND - SANDUSKY
ROSEWOOD
BLVD.
ELECTRIC
DR.
SEE 4-00-007-A
Pt. 04-00-007-105-032
Pt. 1.29A.
Pt. 04-00-007-105-034
Pt. .11A.
VAC. Ord. 2-65
Private Park
APPROVED
LORAIN CO.
MAP DEPT.
DATE 5/5/77
PAGE 4-00-007B
BY
VOID AFTER
MAY 6 1977
AUG 11 1977