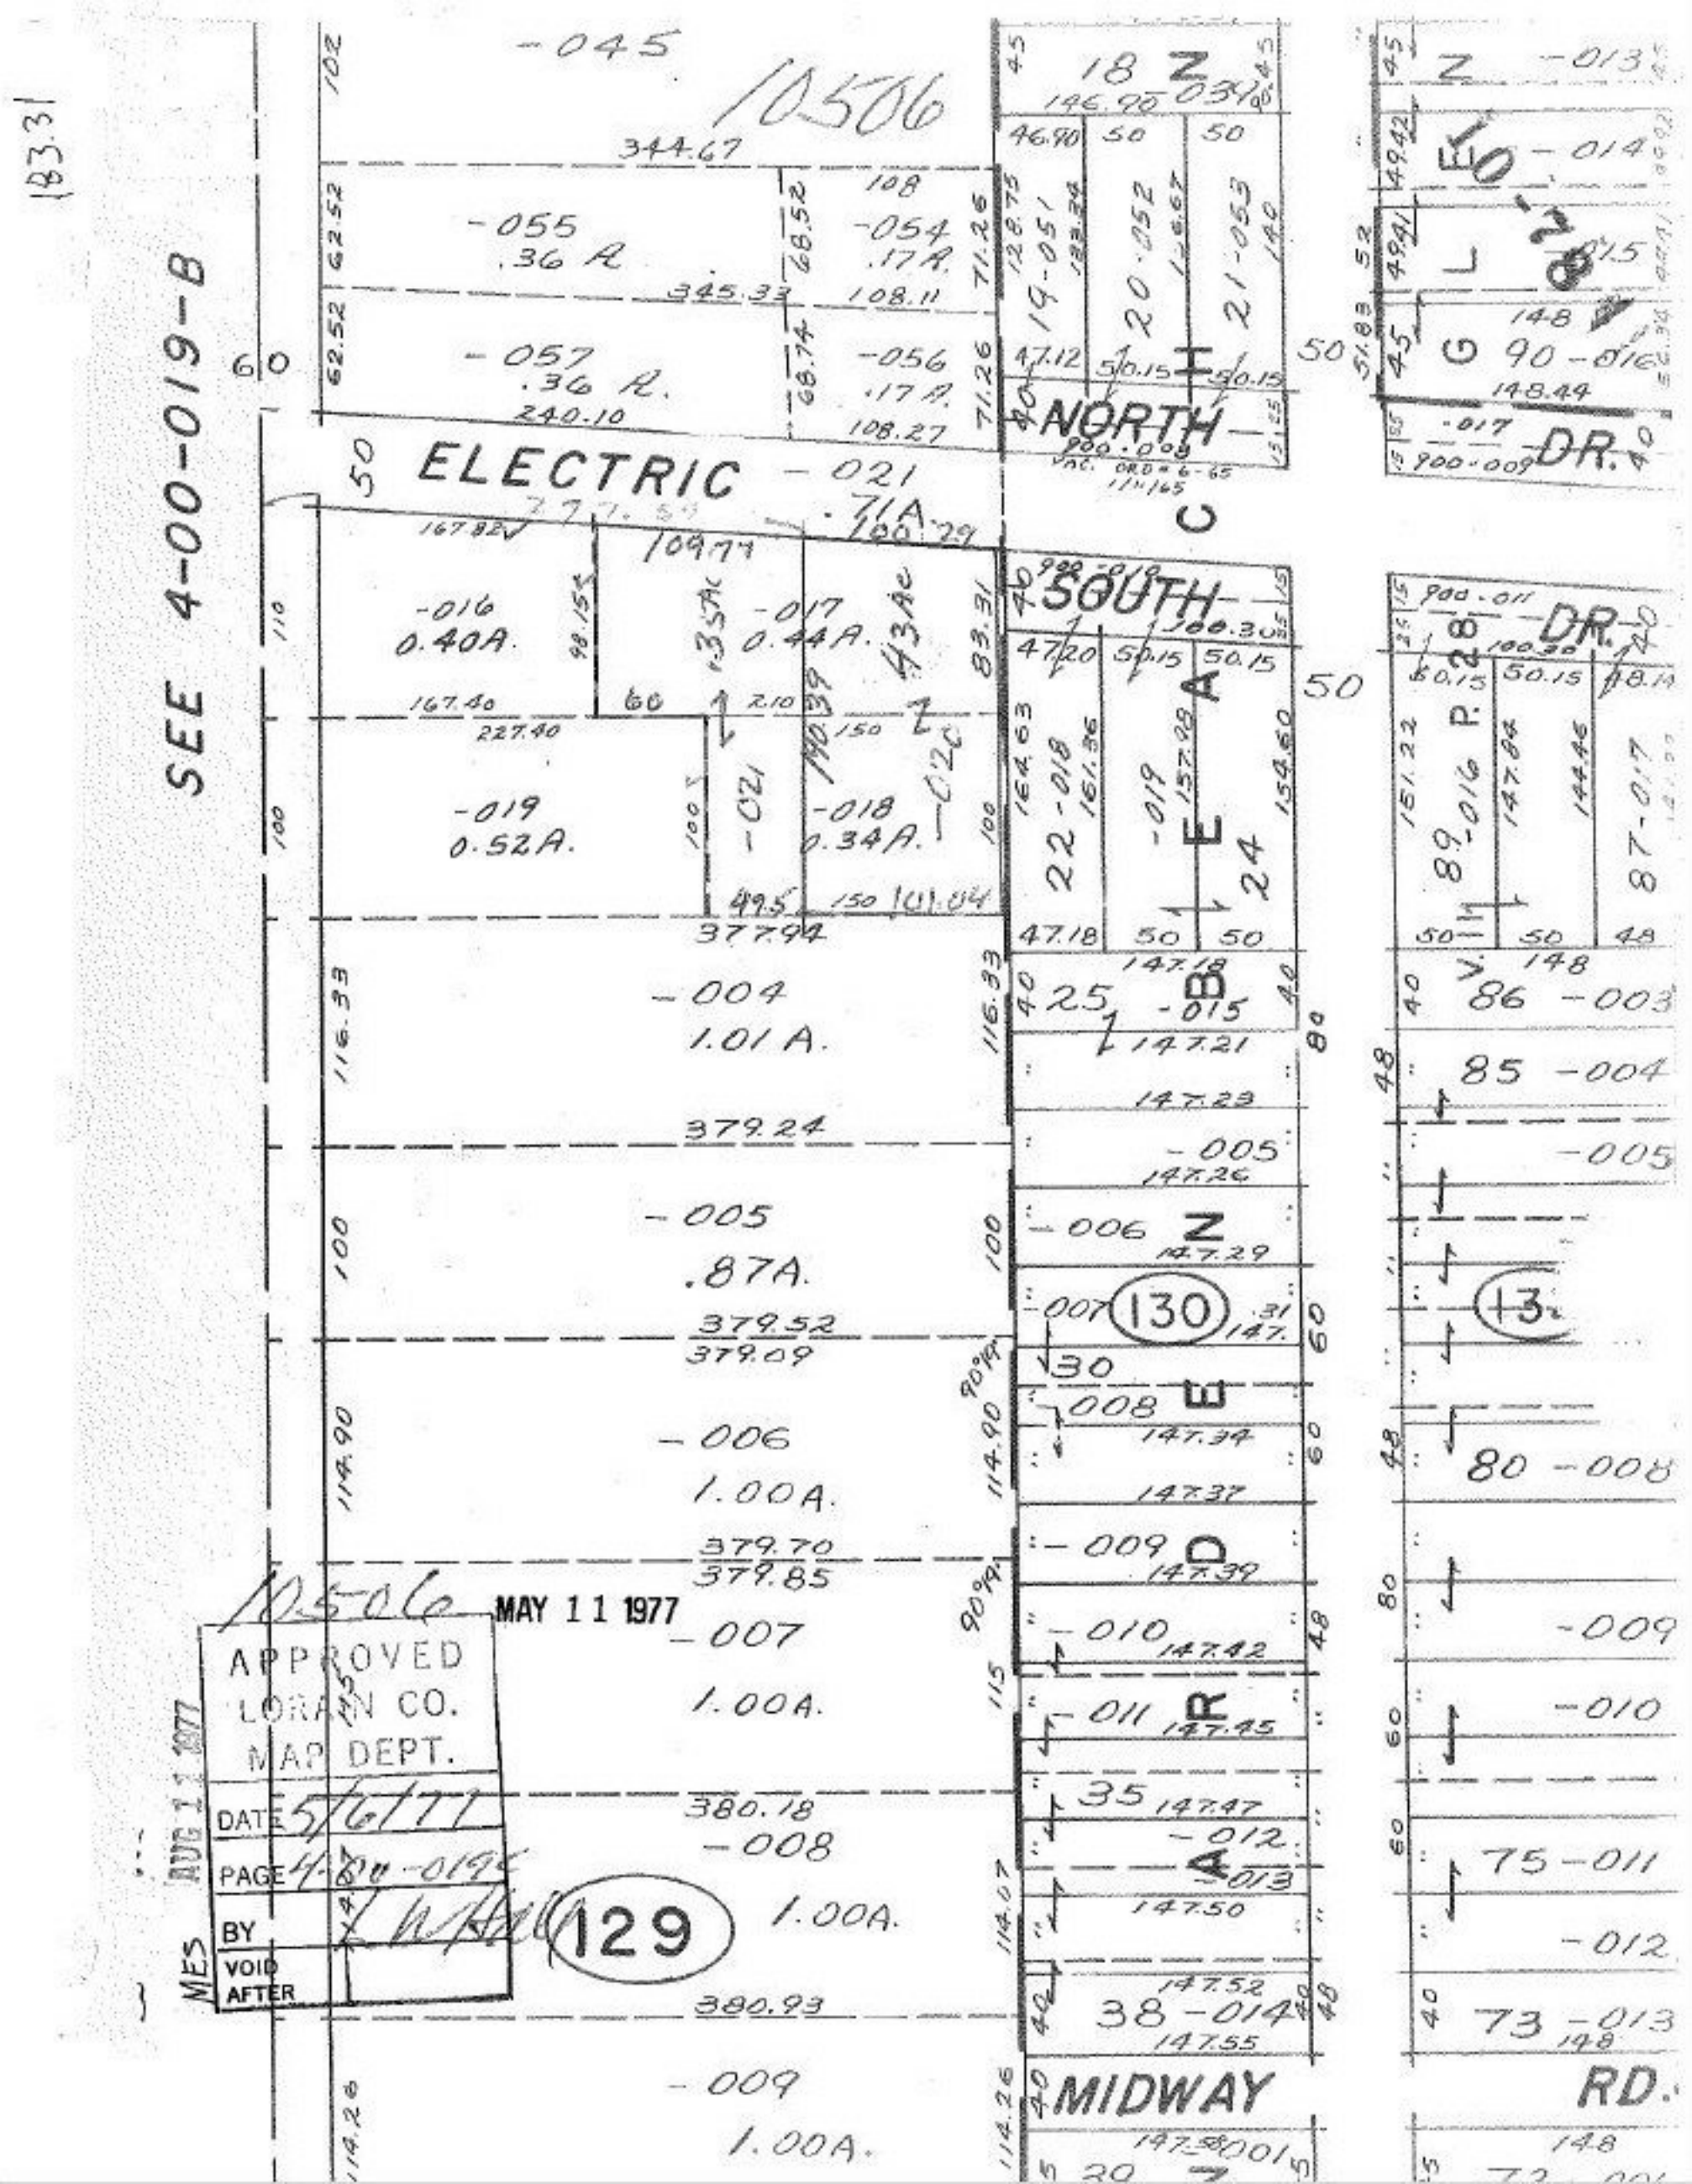

183.31
SEE 4-00-019-B
10506
-045
344.67
-055
.36 A
-054
.17 A
345.33
108.11
-057
.36 A.
-056
.17 A.
240.10
108.27
ELECTRIC
-021
.71A
-016
0.40A.
-017
0.44A.
-019
0.52A.
-018
0.34A.
-021
-020
377.94
-004
1.01 A.
379.24
-005
.87A.
379.52
379.09
-006
1.00A.
379.70
379.85
-007
1.00A.
380.18
-008
1.00A.
380.93
-009
1.00A.
NORTH
SOUTH
MIDWAY
RD.
DR.
DR.
18
19-051
20-052
21-053
22-018
24
25
-015
-006
-007
130
30
-008
-009
-010
-011
35
-012
-013
38-014
-013
-014
-015
90-016
-017
-016
89-016
87-017
86-003
85-004
-005
80-008
-009
-010
75-011
-012
73-013
10506
MAY 11 1977
APPROVED
LORAIN CO.
MAP DEPT.
DATE 5/6/77
PAGE 4-00-019
BY
VOID AFTER
AUG 11 1977
MES
129