10-78

10577

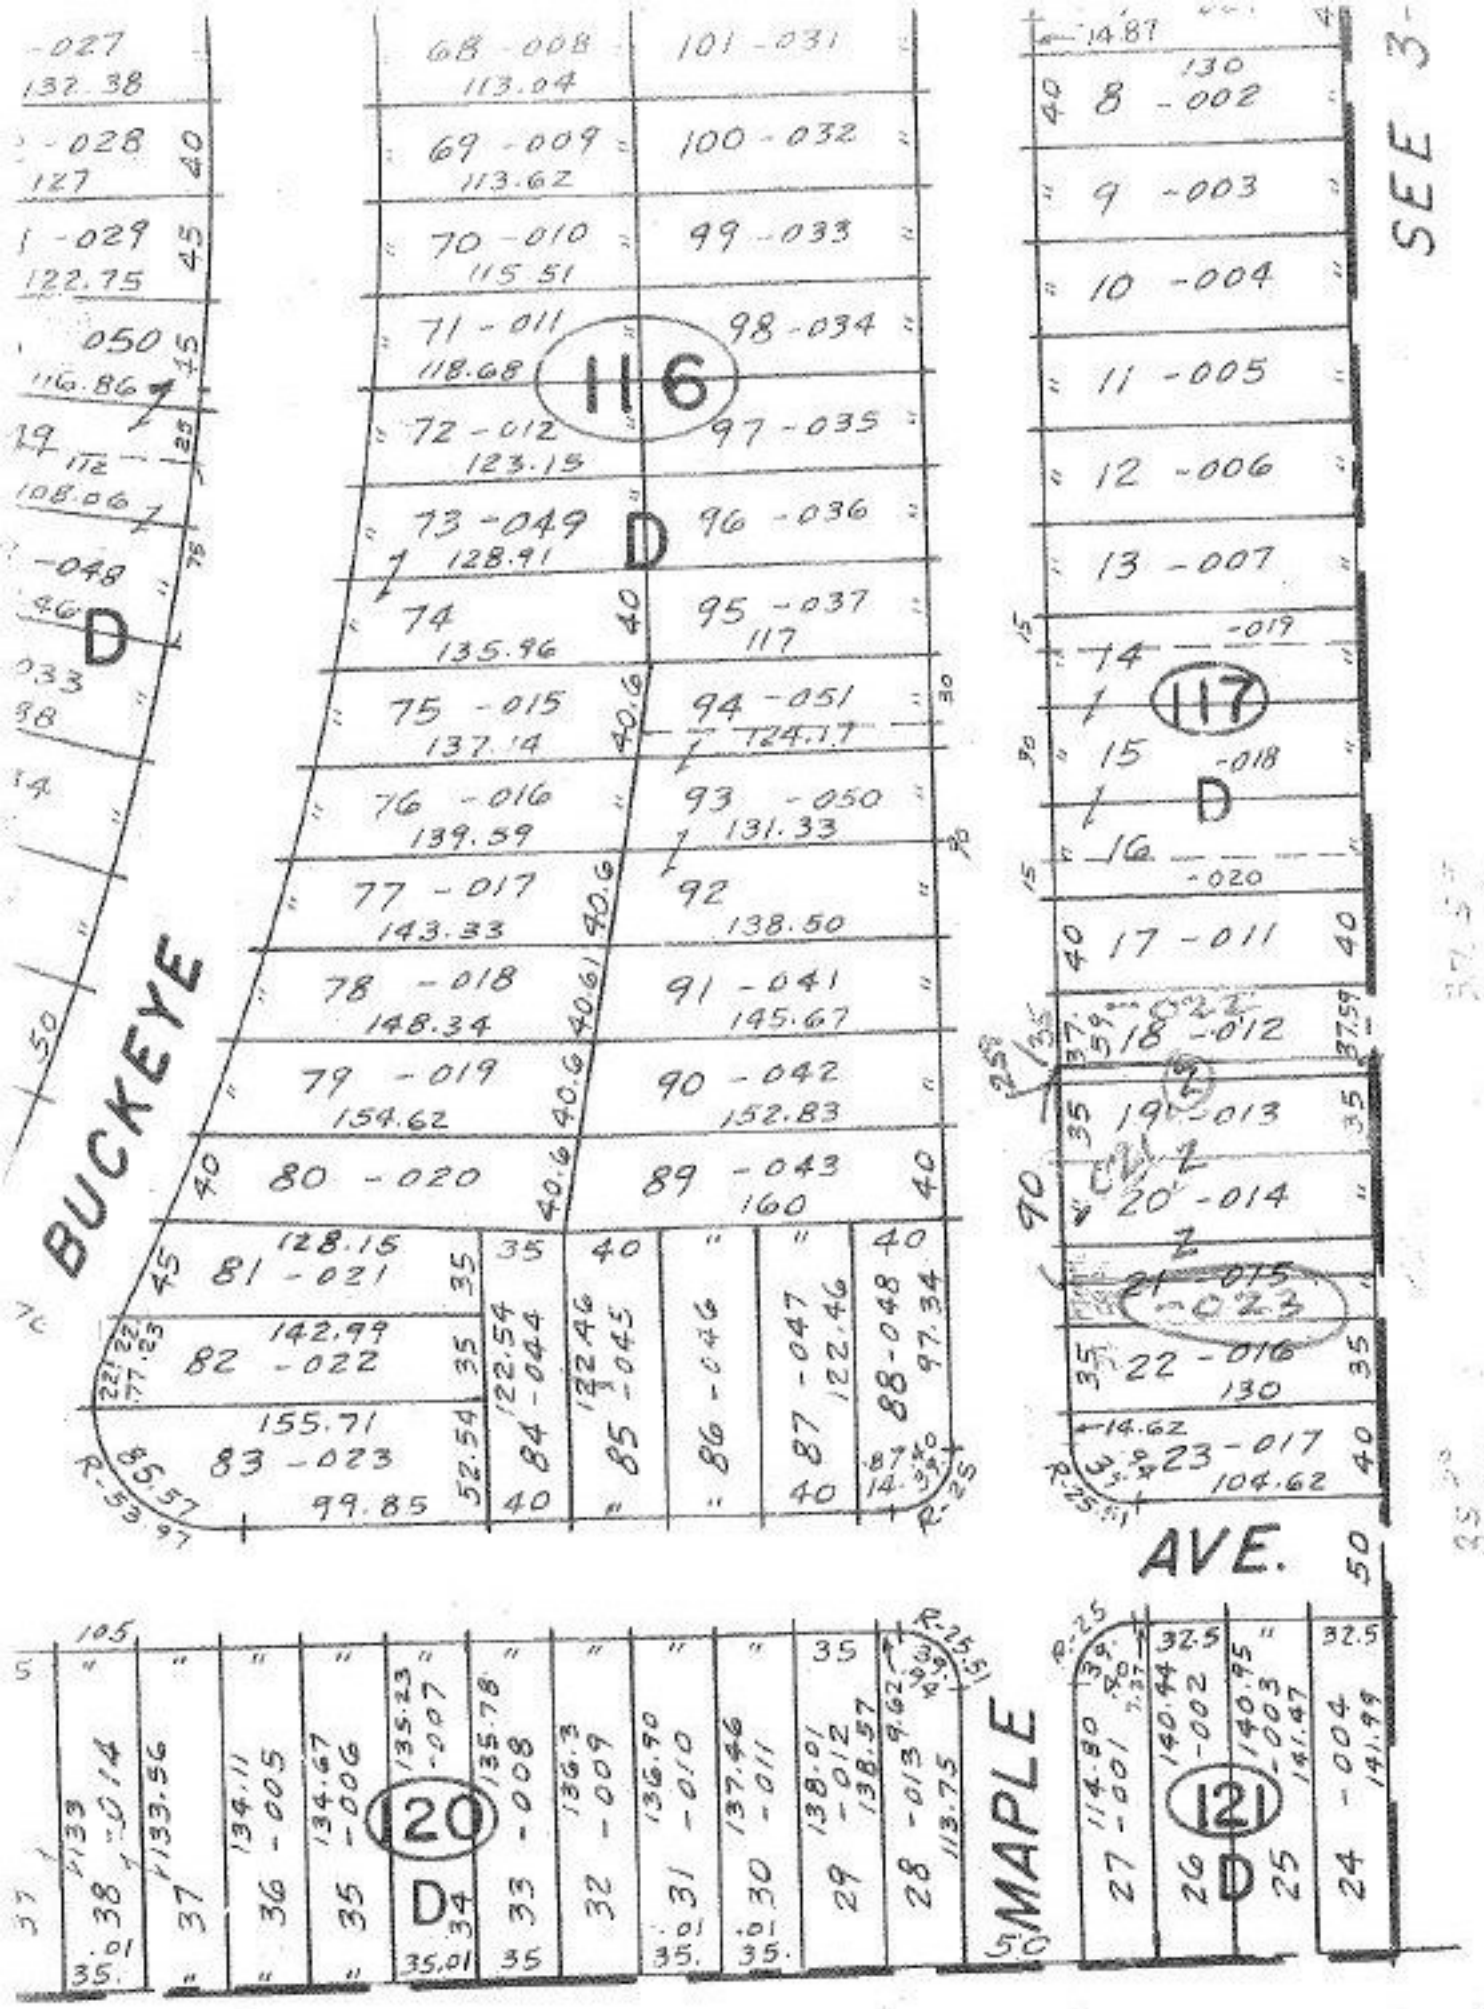

2.59
35
35
72.59
17.41
90.00
90.00
72.59
17.41

10577

MAY 27 1977
AUG 11, 1977 J.B.

APPROVED
LORAIN CO.
MAP DEPT.
DATE 5/26/77
PAGE 3-00-035
BY LW Hall
VOID AFTER

LOT 35