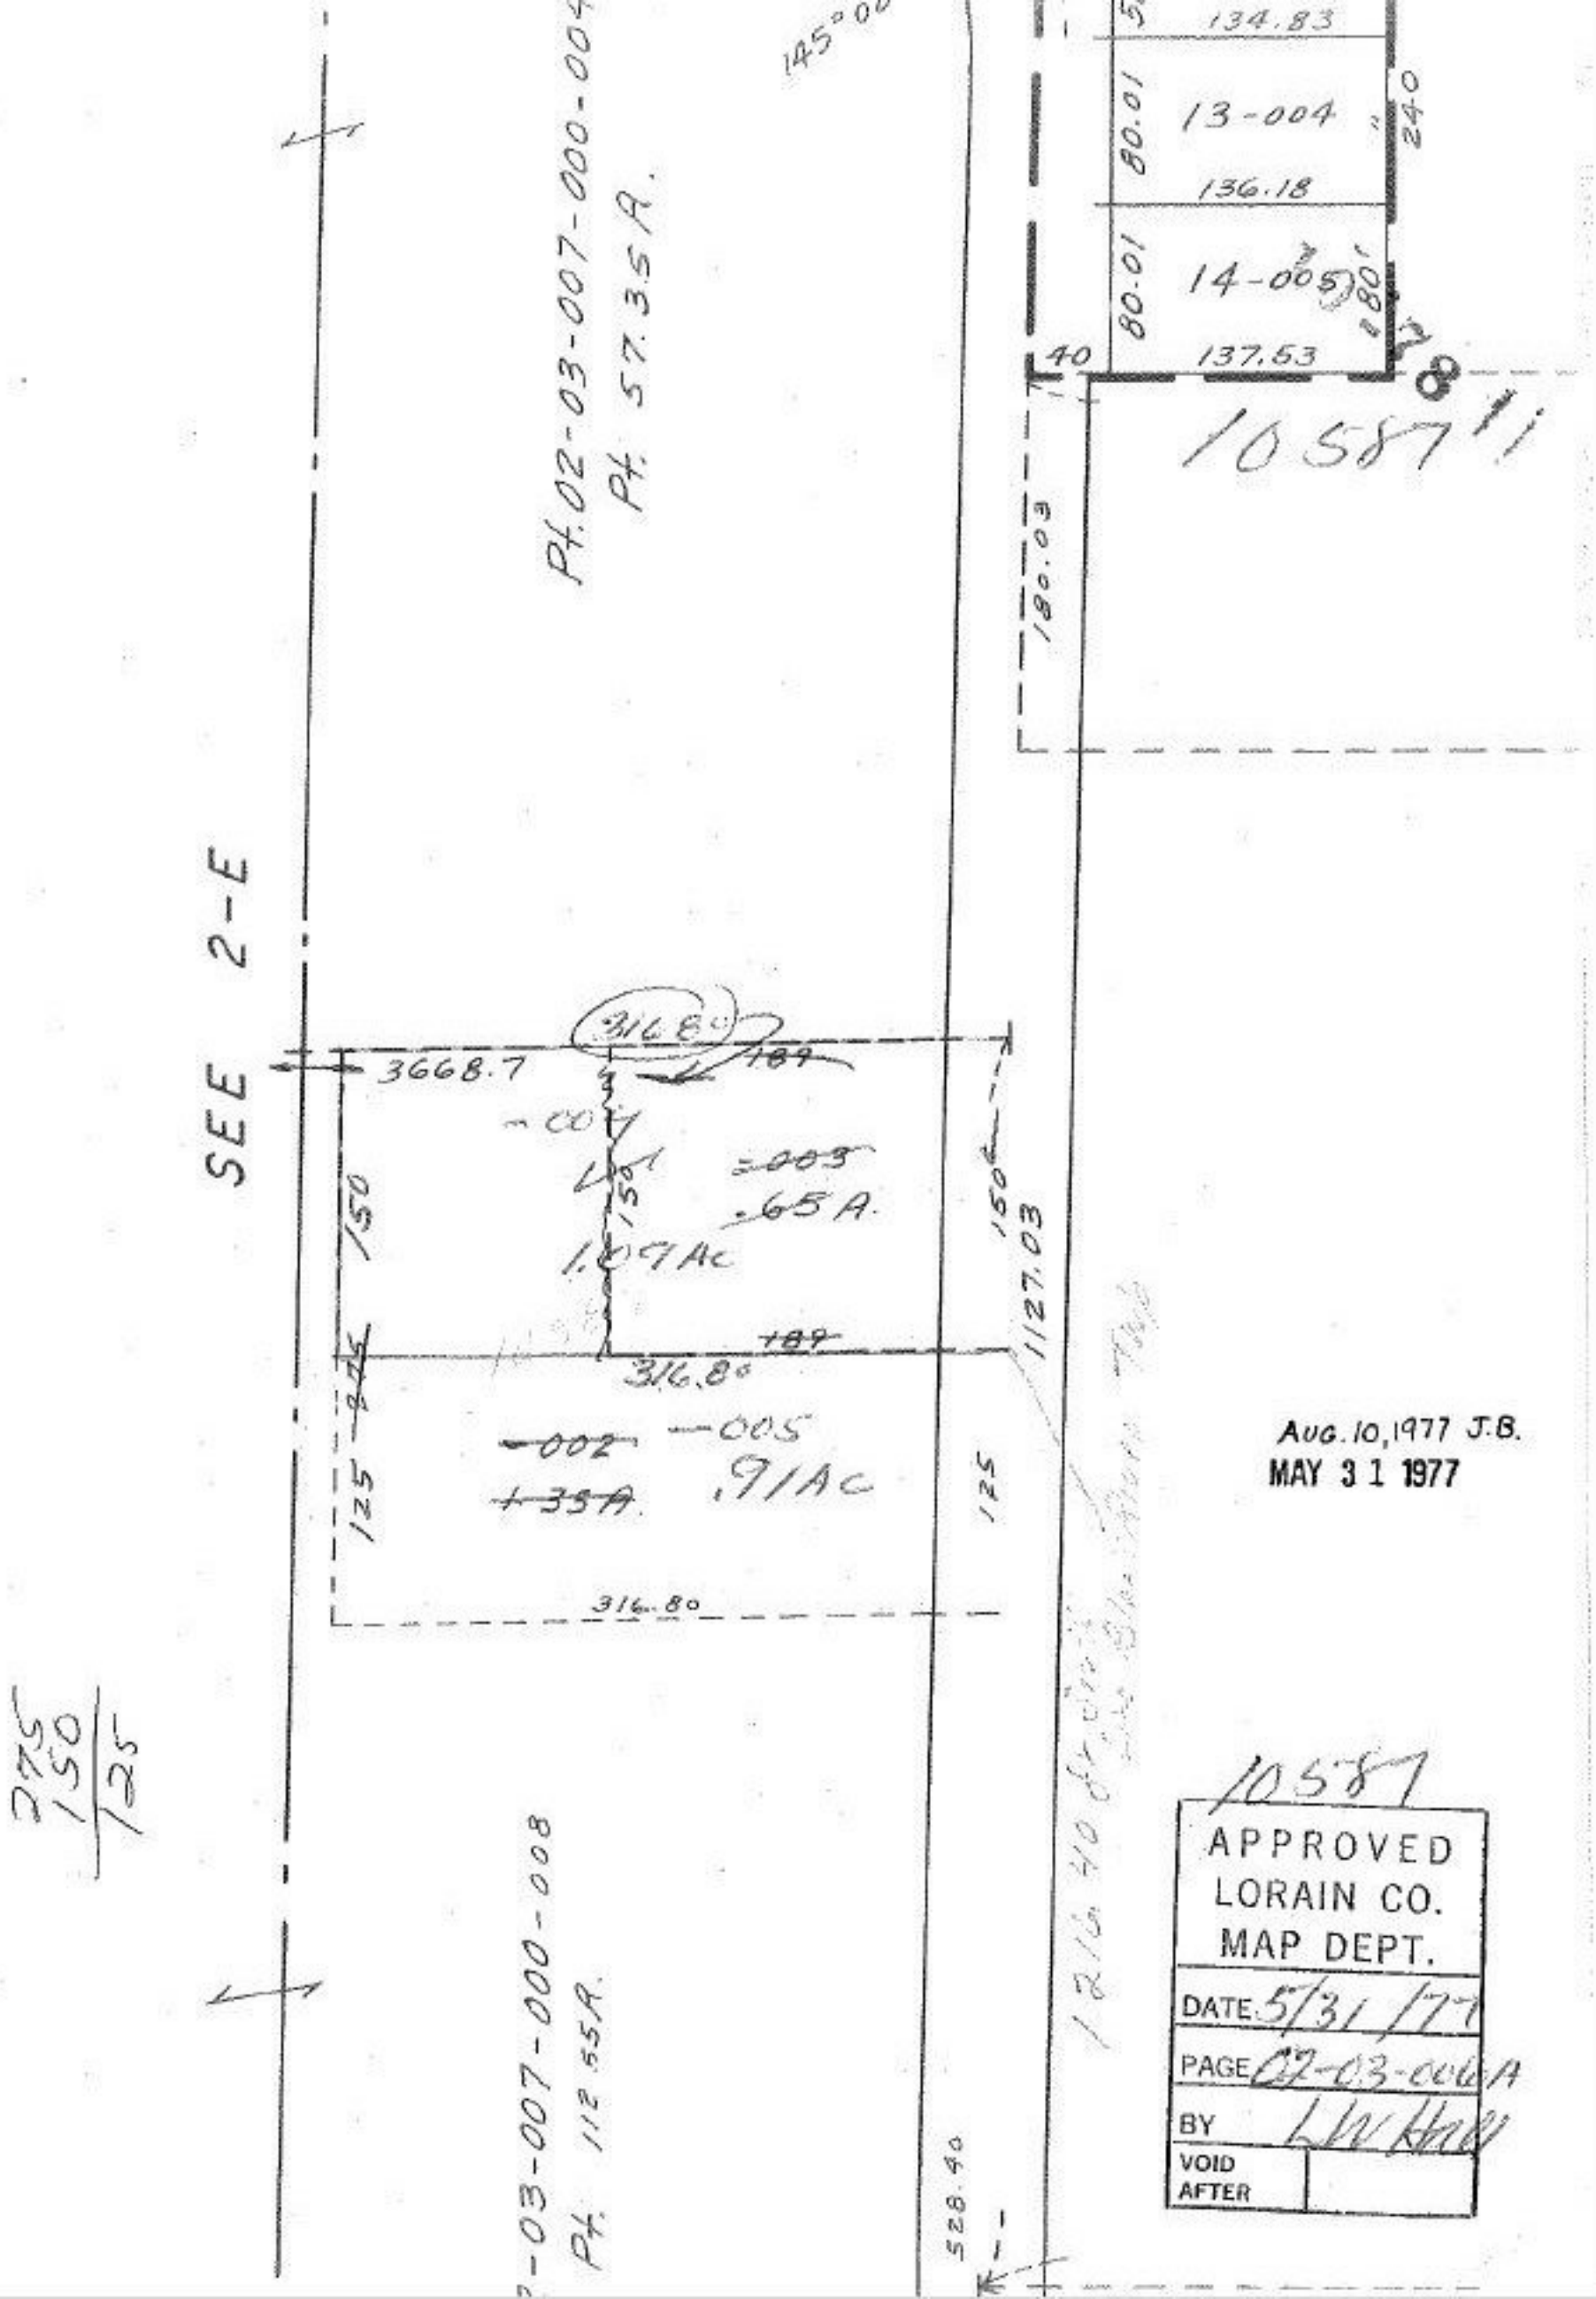

AUG. 10, 1977 J.B.
MAY 31 1977

10587

APPROVED
LORAIN CO.
MAP DEPT.

DATE 5/31/77
PAGE 02-03-006A
BY LW Hall
VOID AFTER