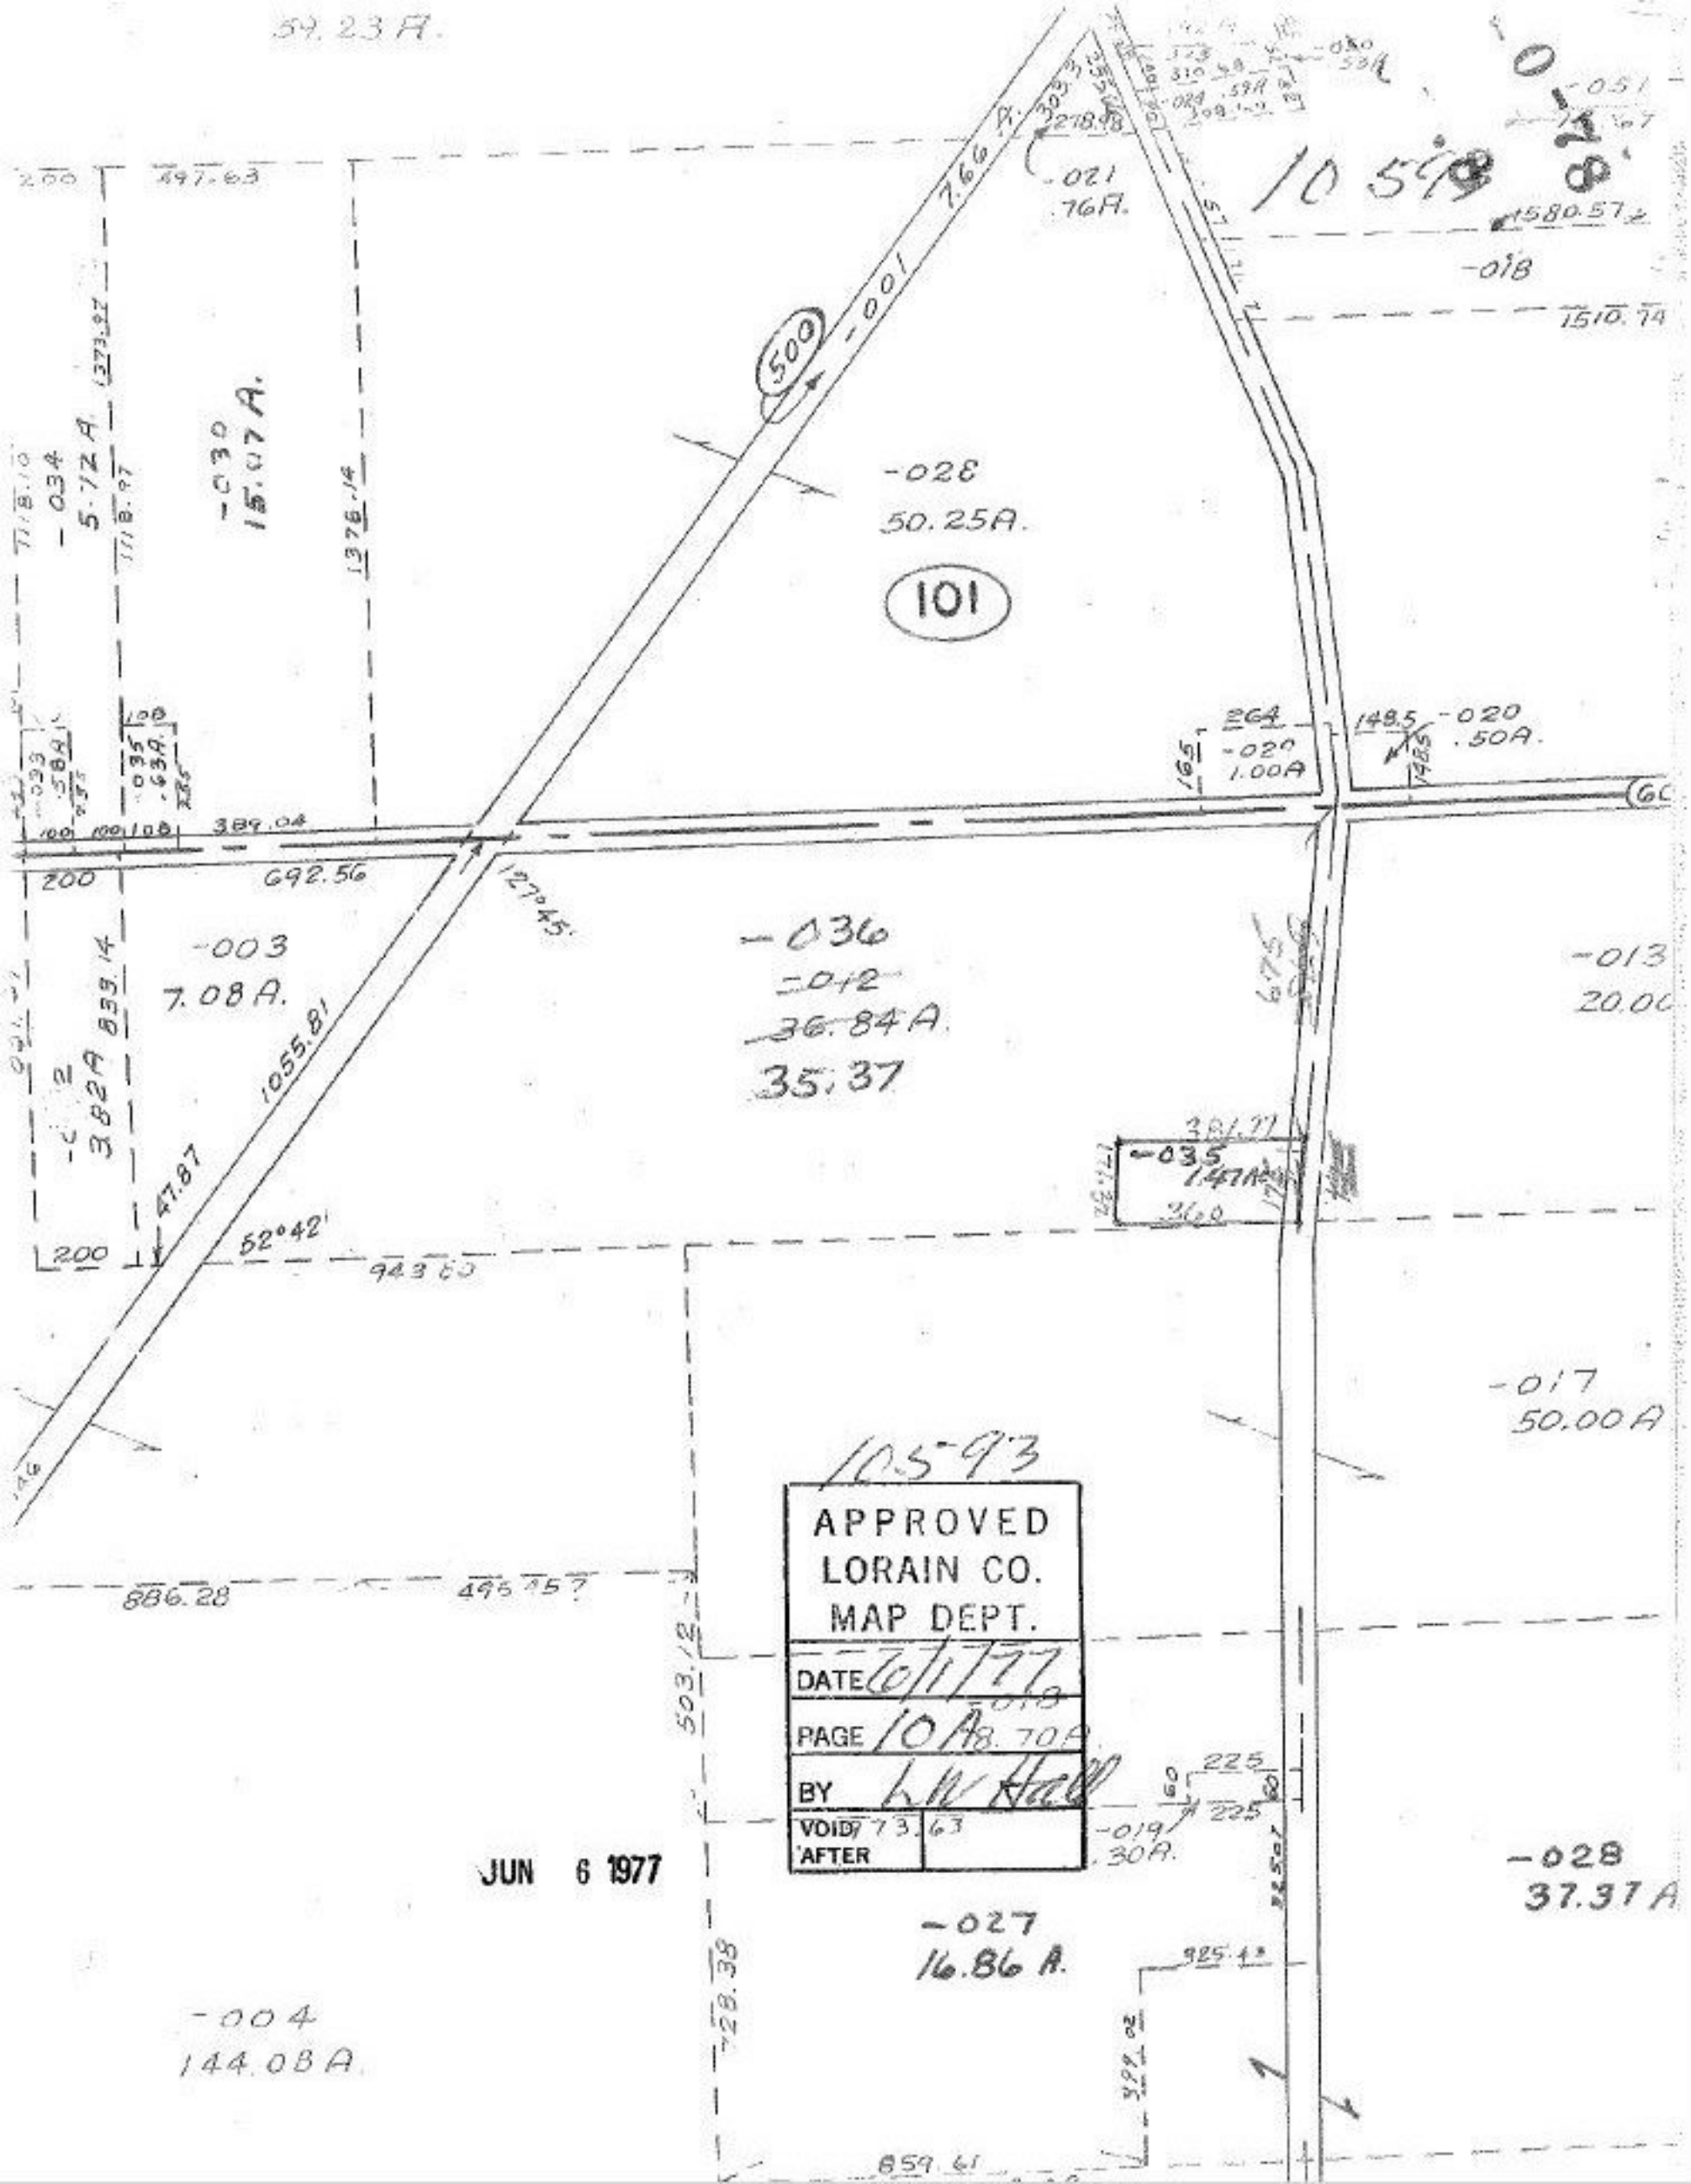

59.23 A.
10 59
-051
-018
1510.74
-021
.76A.
-001
7.66 A.
500
-028
50.25A.
101
-030
15.07 A.
-034
5.72 A.
1376.14
389.04
692.56
127°45'
-003
7.08 A.
-036
-012
36.84 A.
35.37
-013
20.00
-035
1.47A
-017
50.00 A
-020
.50A.
-020
1.00A
-019
.30A.
-028
37.37 A
-027
16.86 A.
-004
144.08 A.
1055.81
47.87
52°42'
943.60
886.28
495.457
503.12
728.38
859.61
10593
APPROVED
LORAIN CO.
MAP DEPT.
DATE 6/1/77
PAGE 10A
BY LW Hall
VOID AFTER
JUN 6 1977