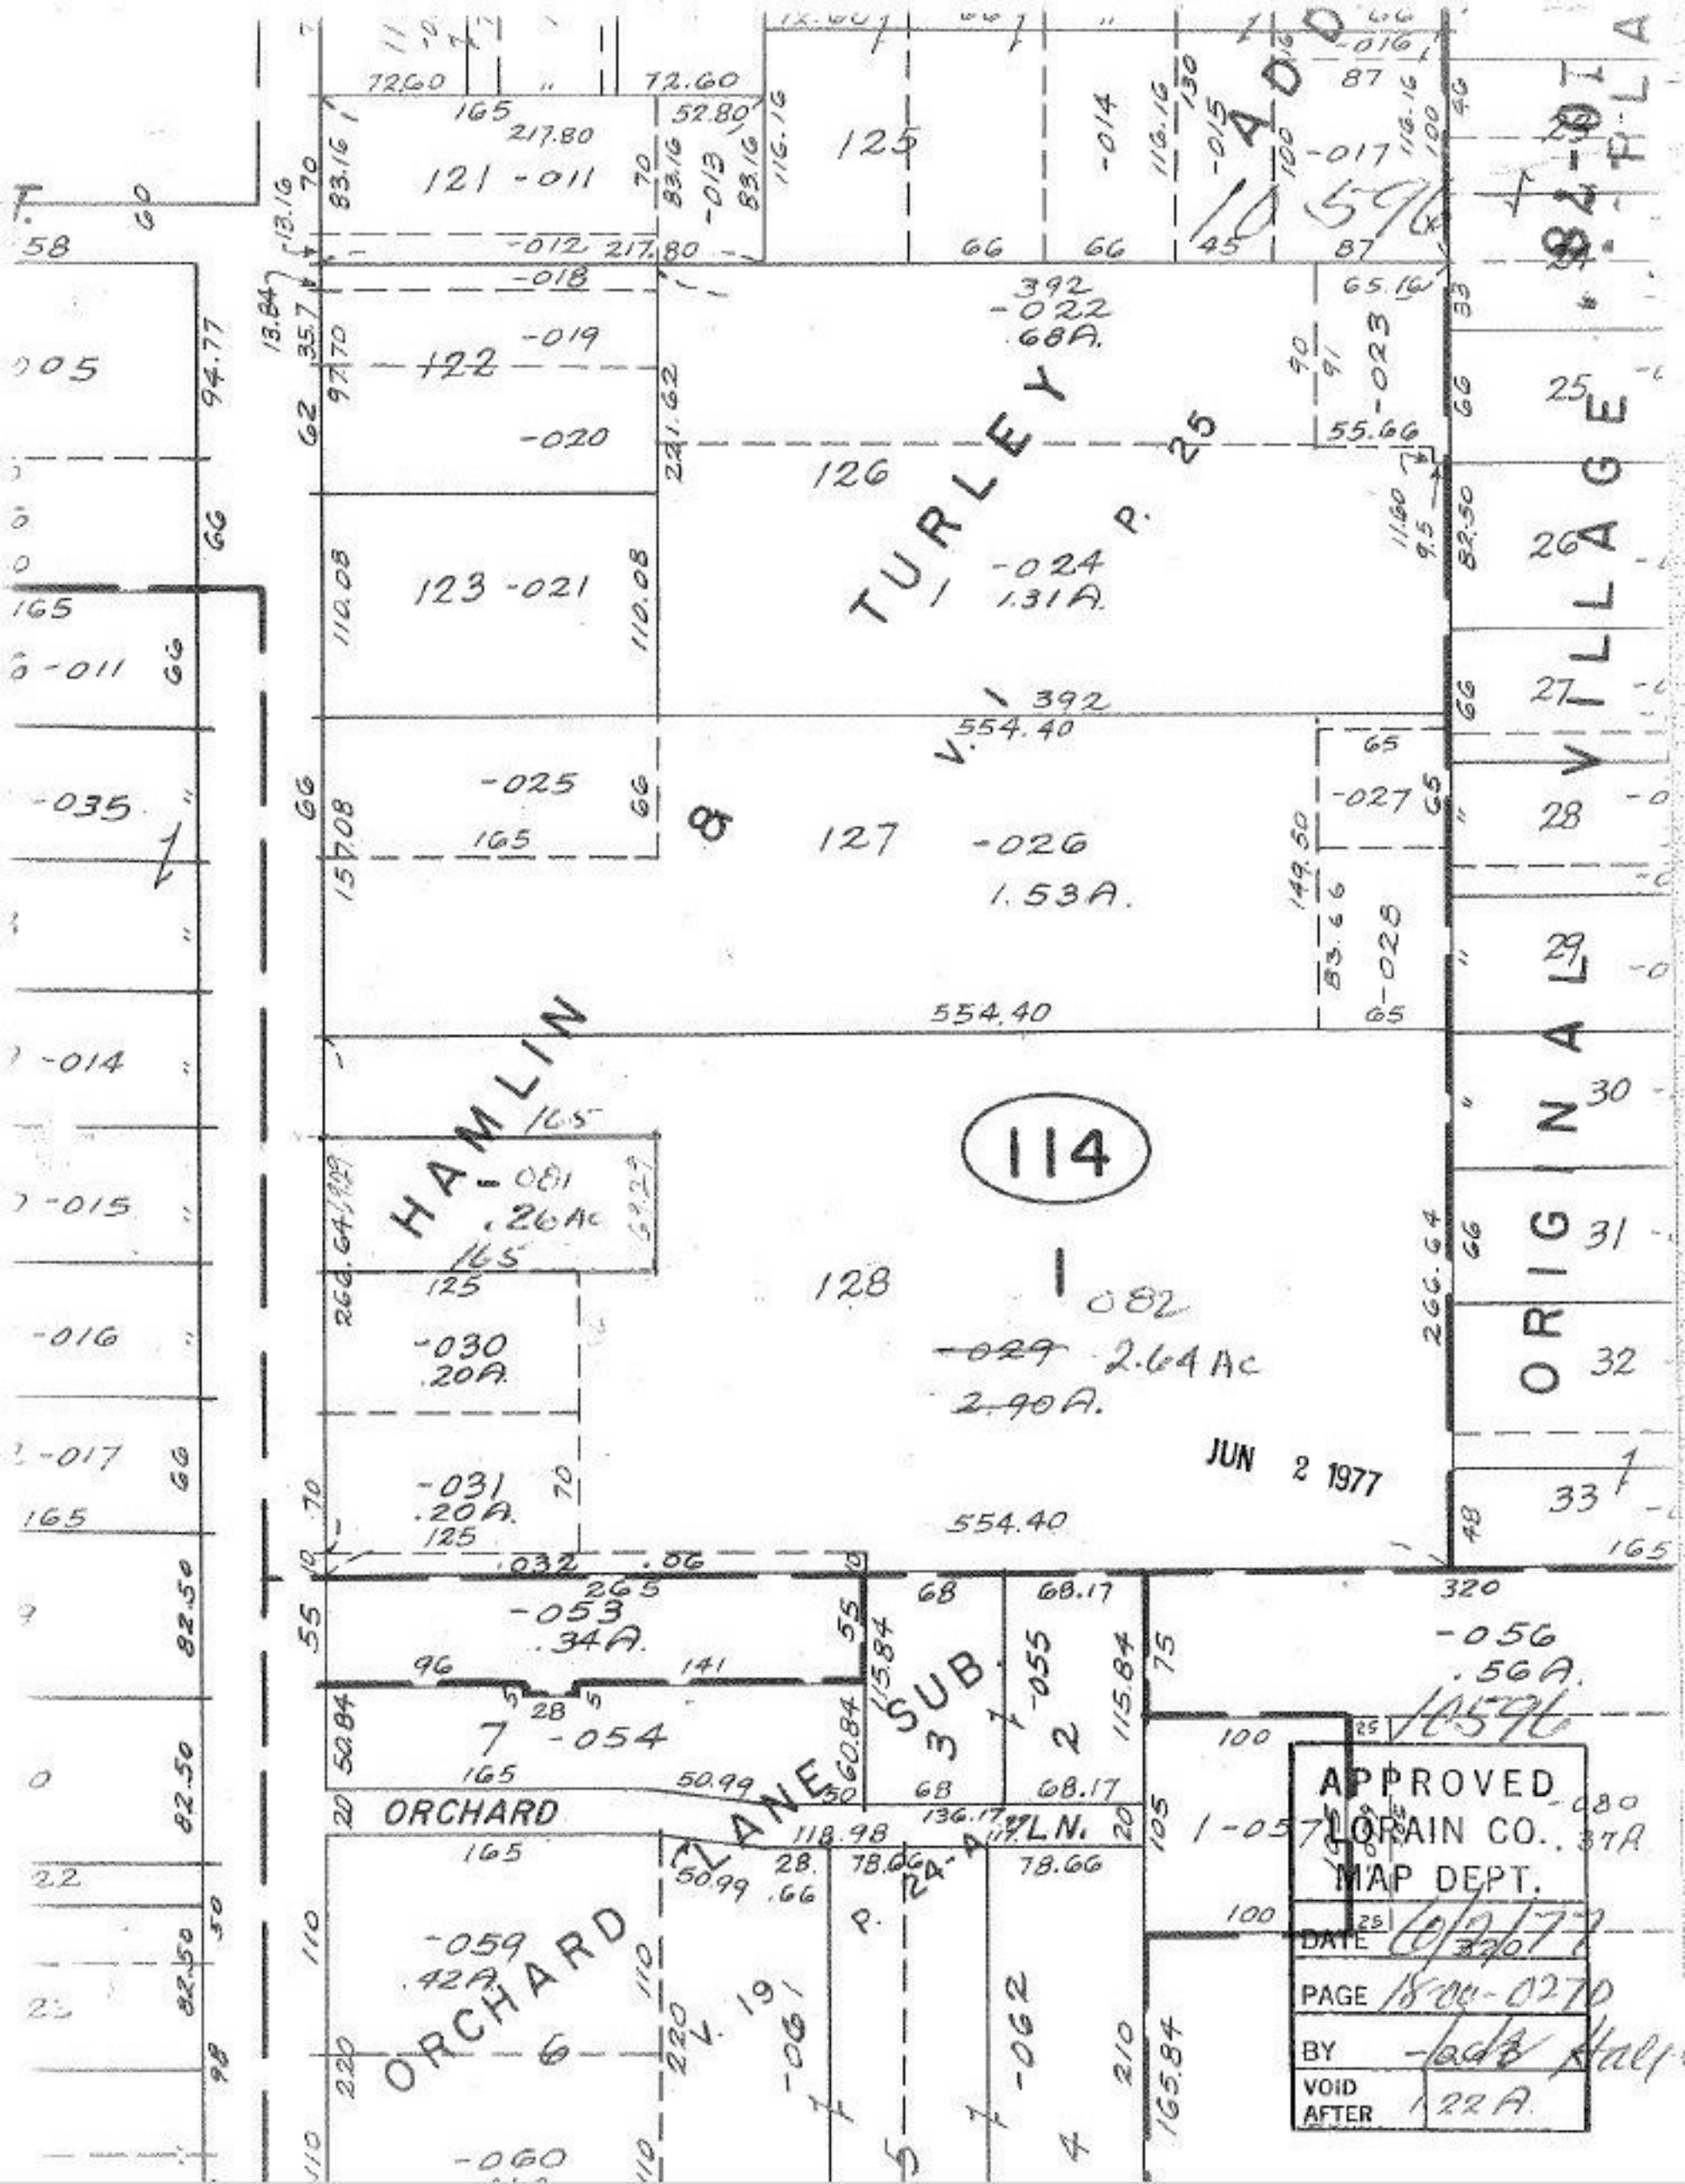

ORIGINAL VILLAGE
TURLEY
HAMLIN
ORCHARD LANE SUB.
ORCHARD
114
JUN 2 1977
APPROVED
LORAIN CO.
MAP DEPT.
DATE
PAGE
BY
VOID AFTER