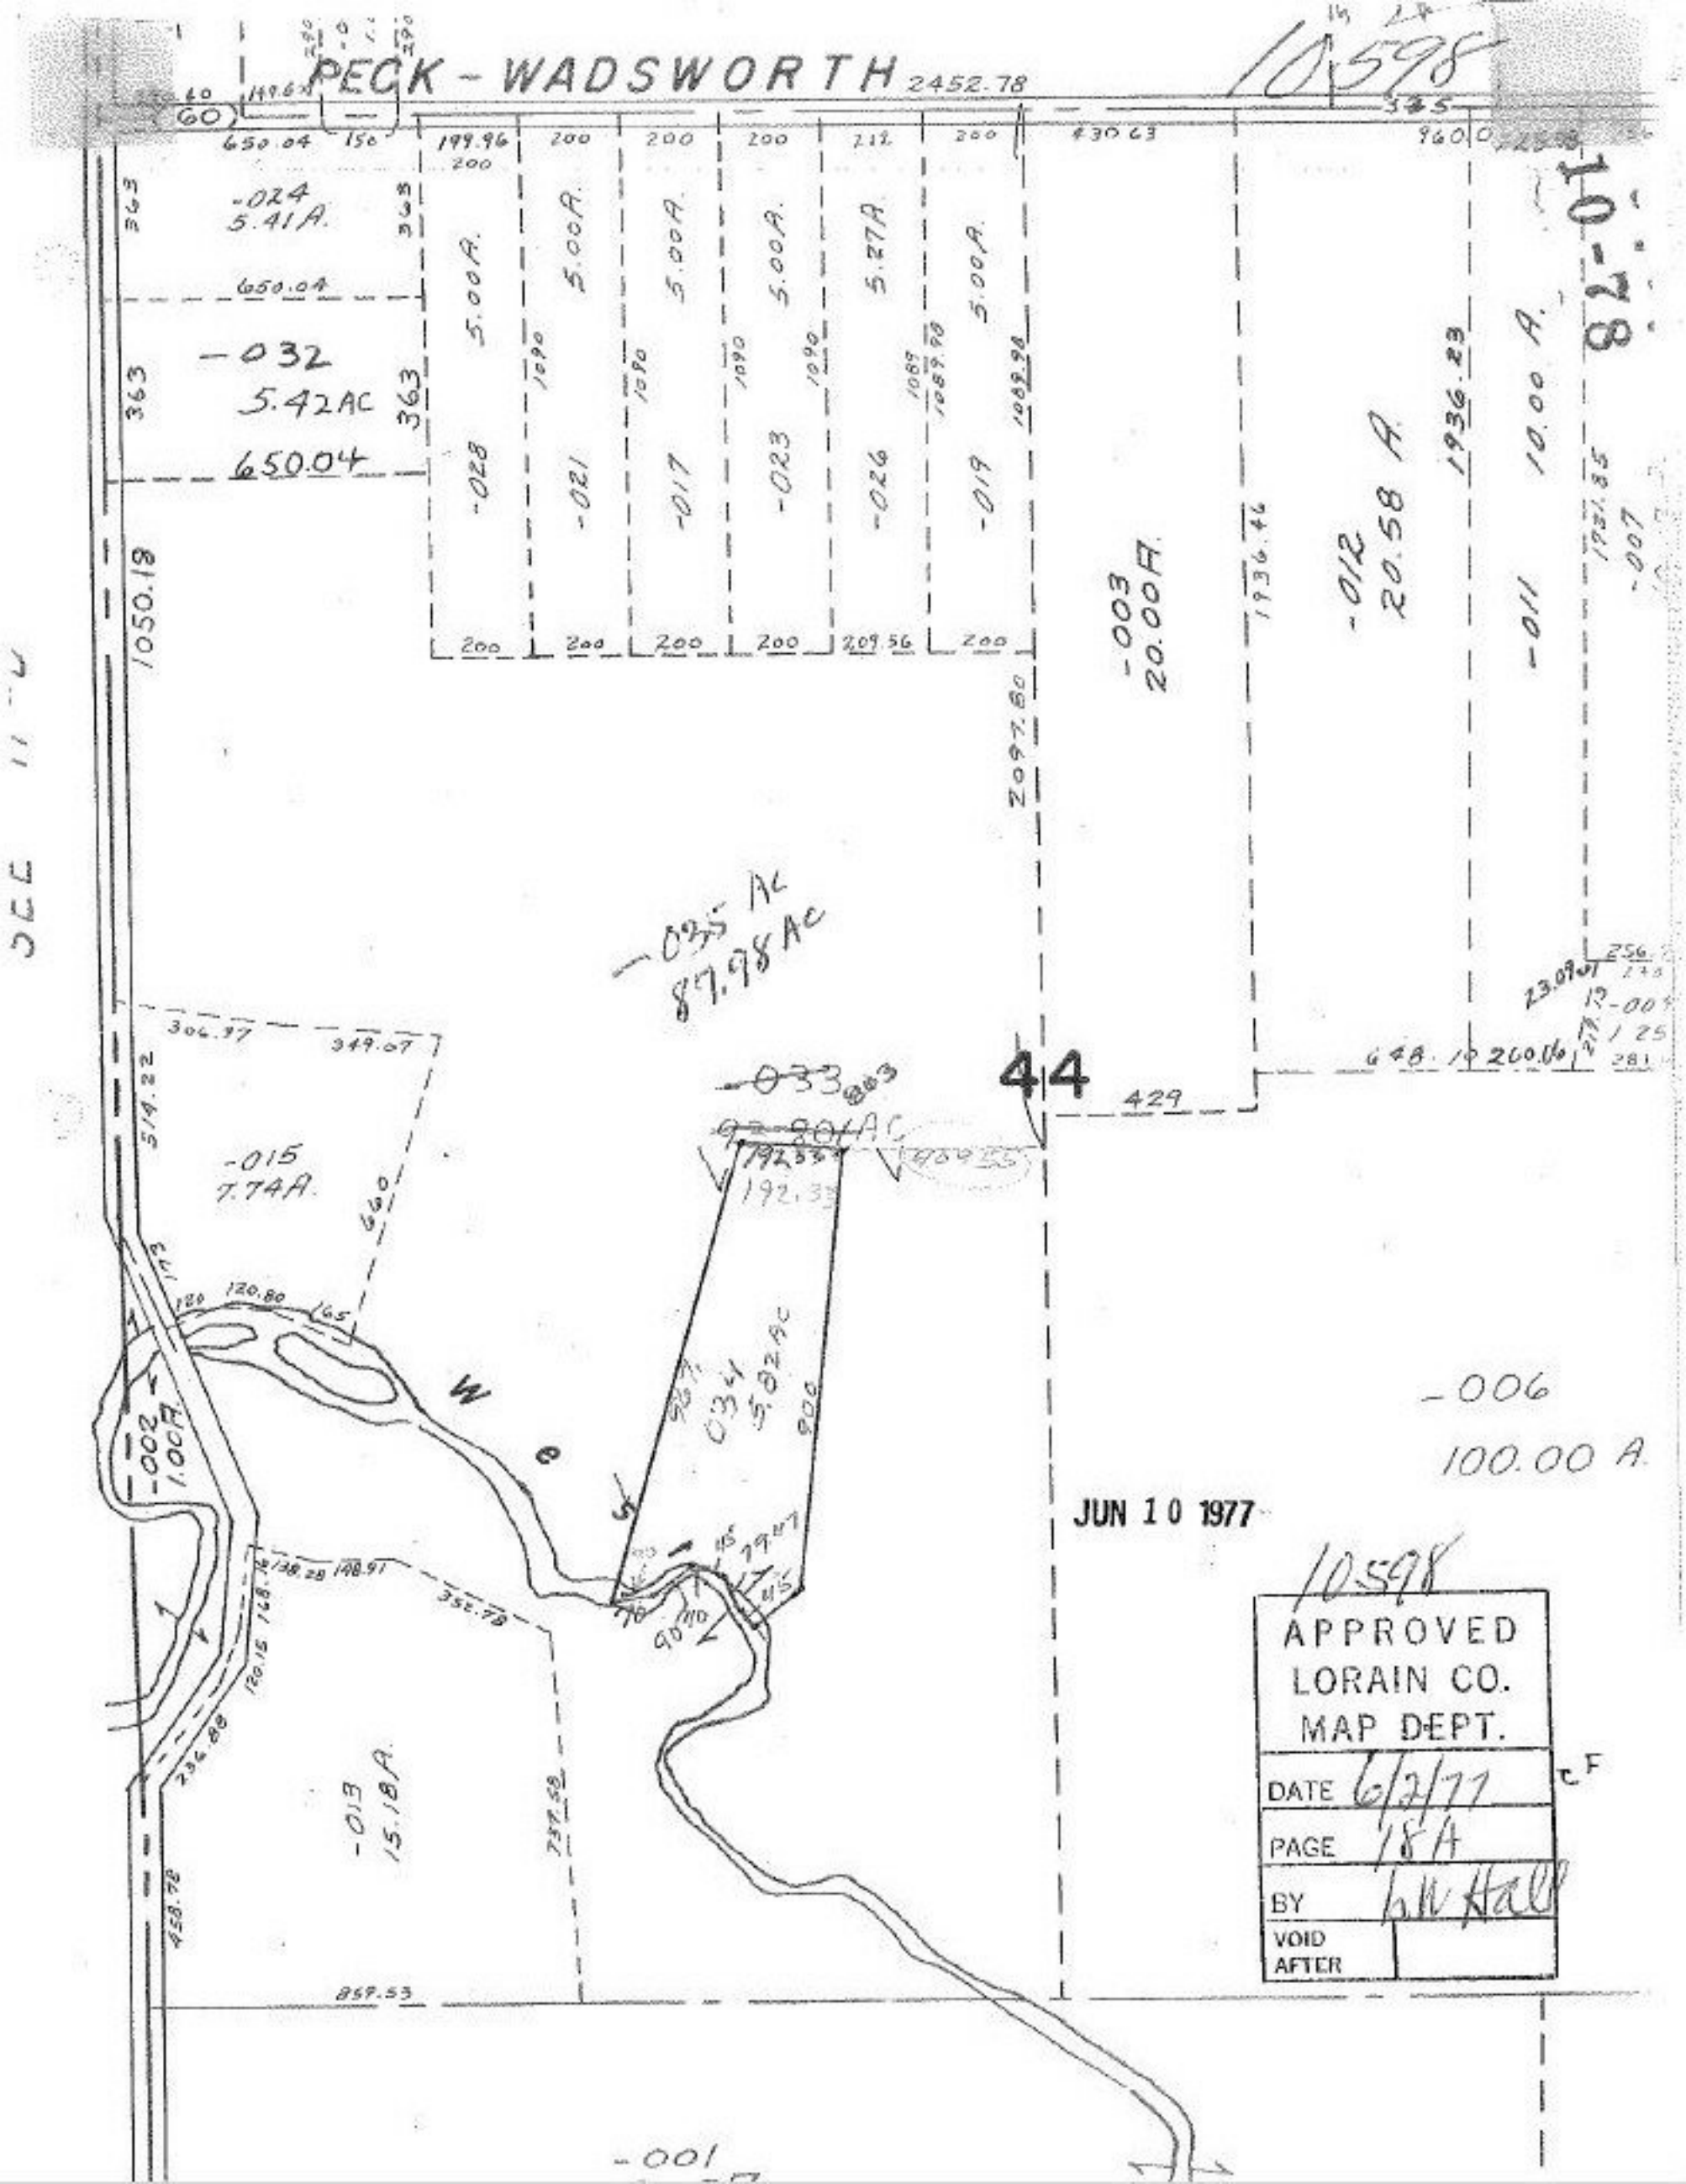
PECK - WADSWORTH 2452.78
10598
10-78
-024
5.41A.
-032
5.42AC
650.04
-028
-021
-017
-023
-026
-019
5.00A.
5.27A
-003
20.00A.
-012
20.58 A.
-011
10.00 A.
1050.18
-035 AC
87.98 AC
-033
44
-015
7.74A.
-002
1.00A.
-034
5.82AC
-006
100.00 A.
-013
15.18A.
-001
JUN 10 1977
10598
APPROVED
LORAIN CO.
MAP DEPT.
DATE 6/2/77
PAGE 18A
BY
VOID AFTER