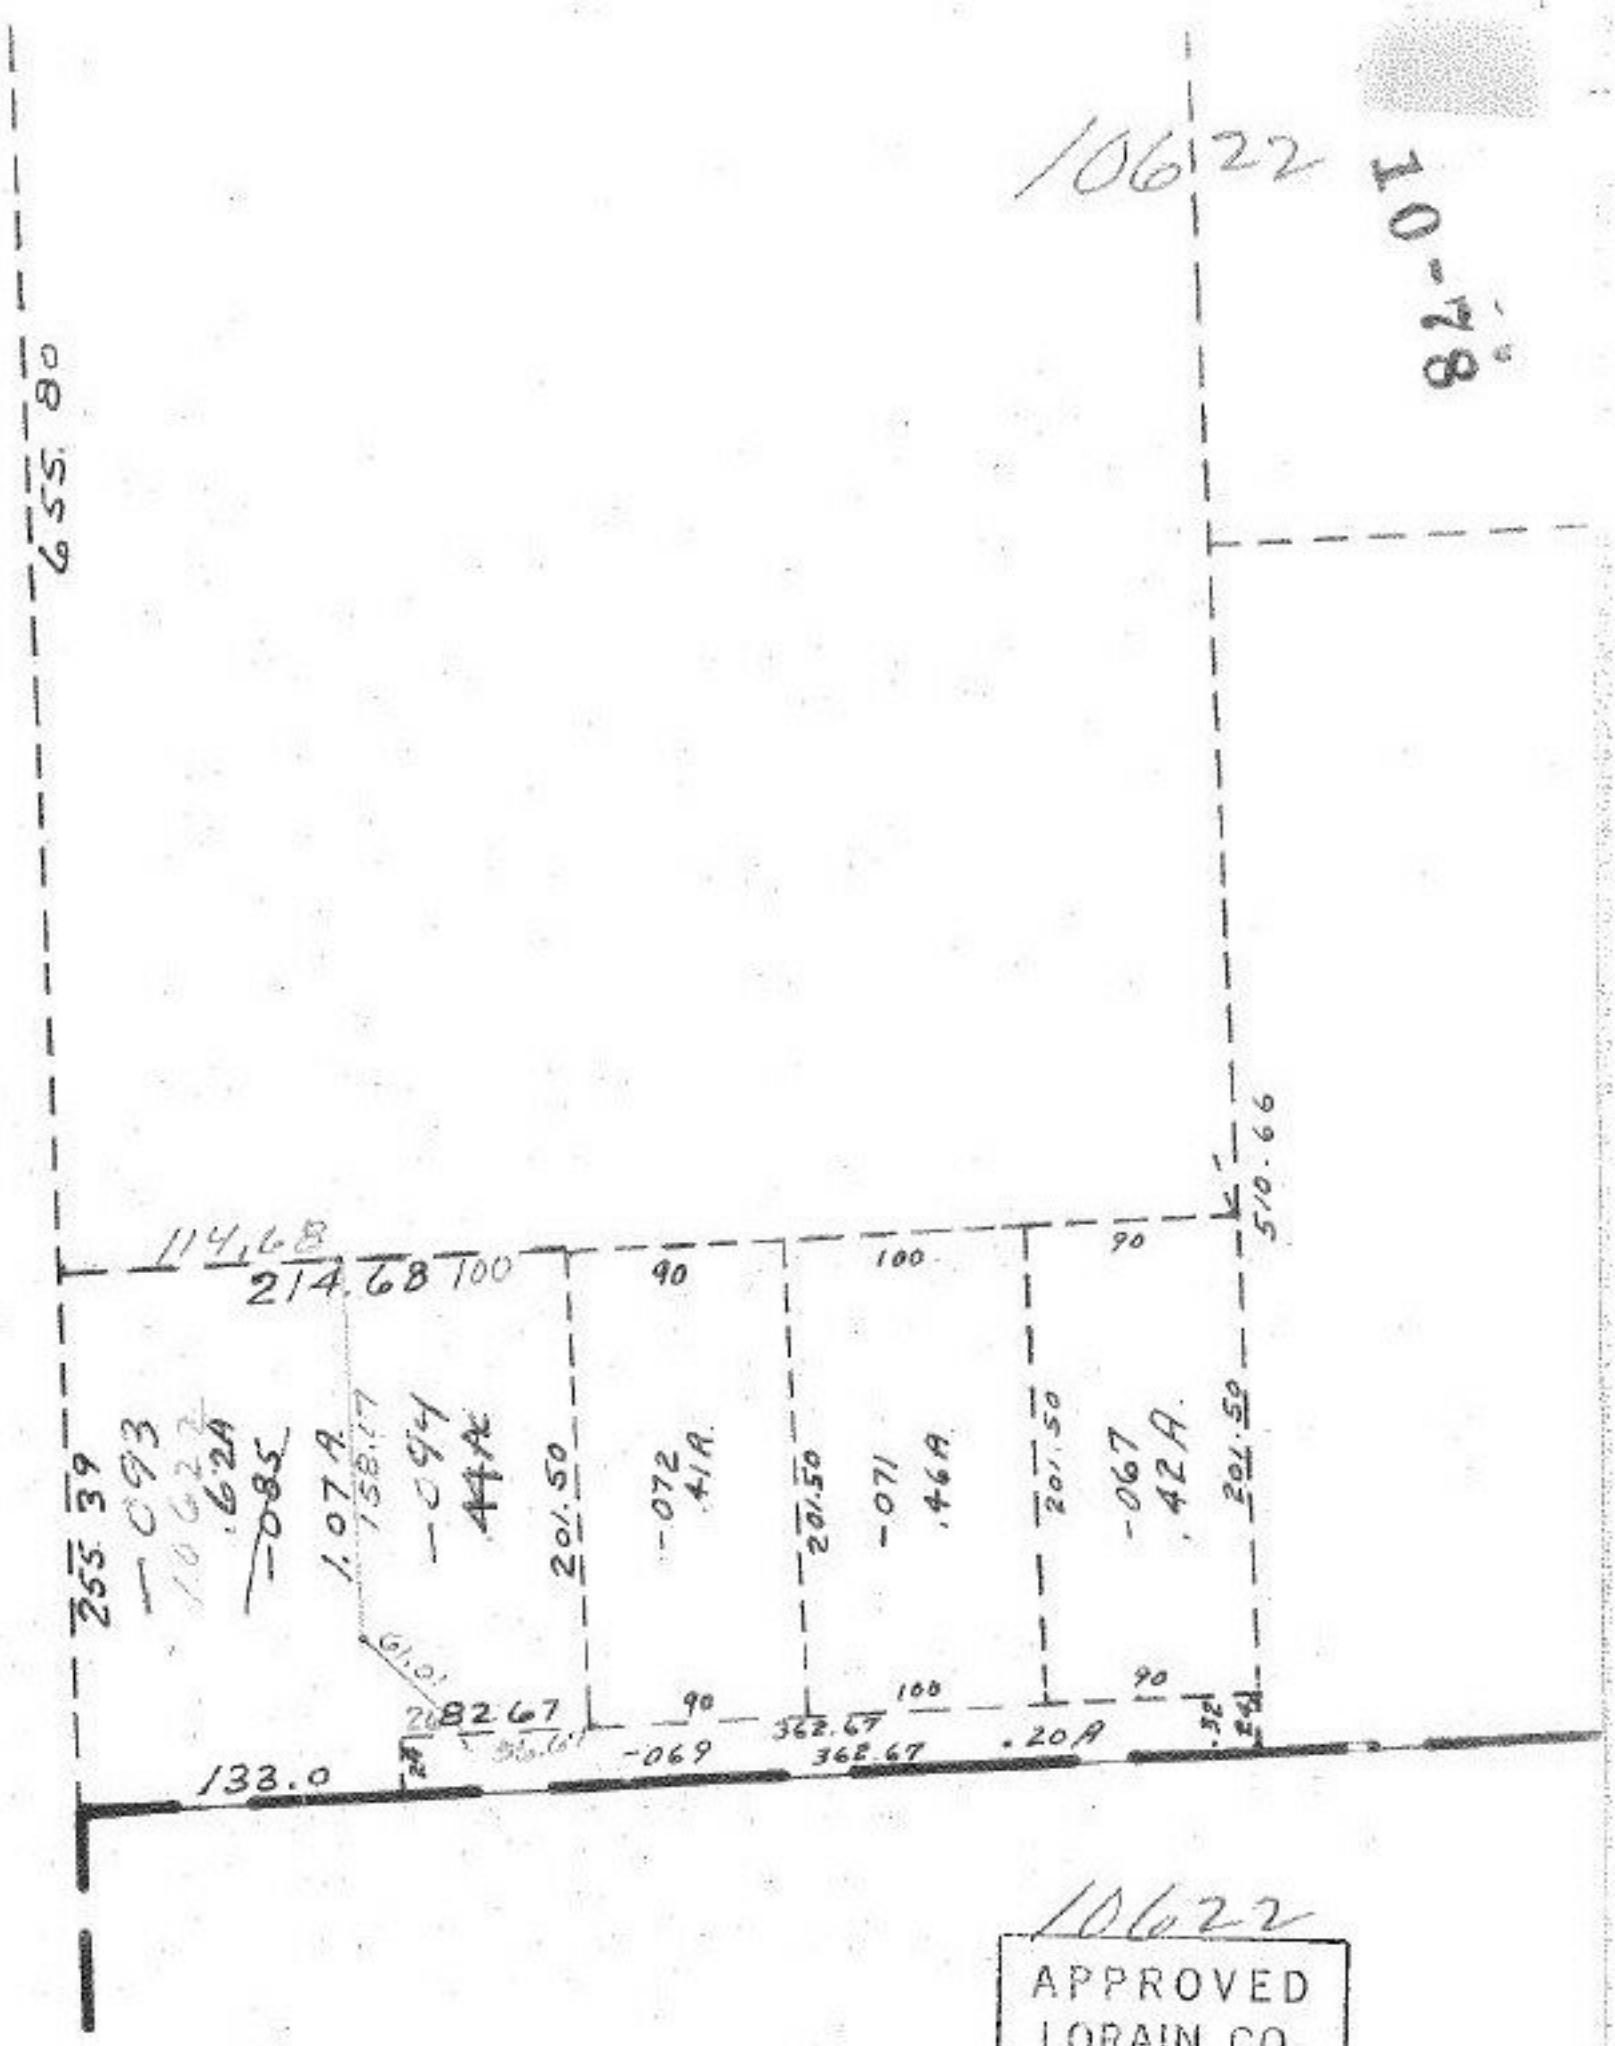

10622

APPROVED
LORAIN CO.
MAP DEPT.

DATE 6/9/77

PAGE 7-00-018B

BY LKH

VOID AFTER

JUN 15 1977

NE ¼ LOT 18