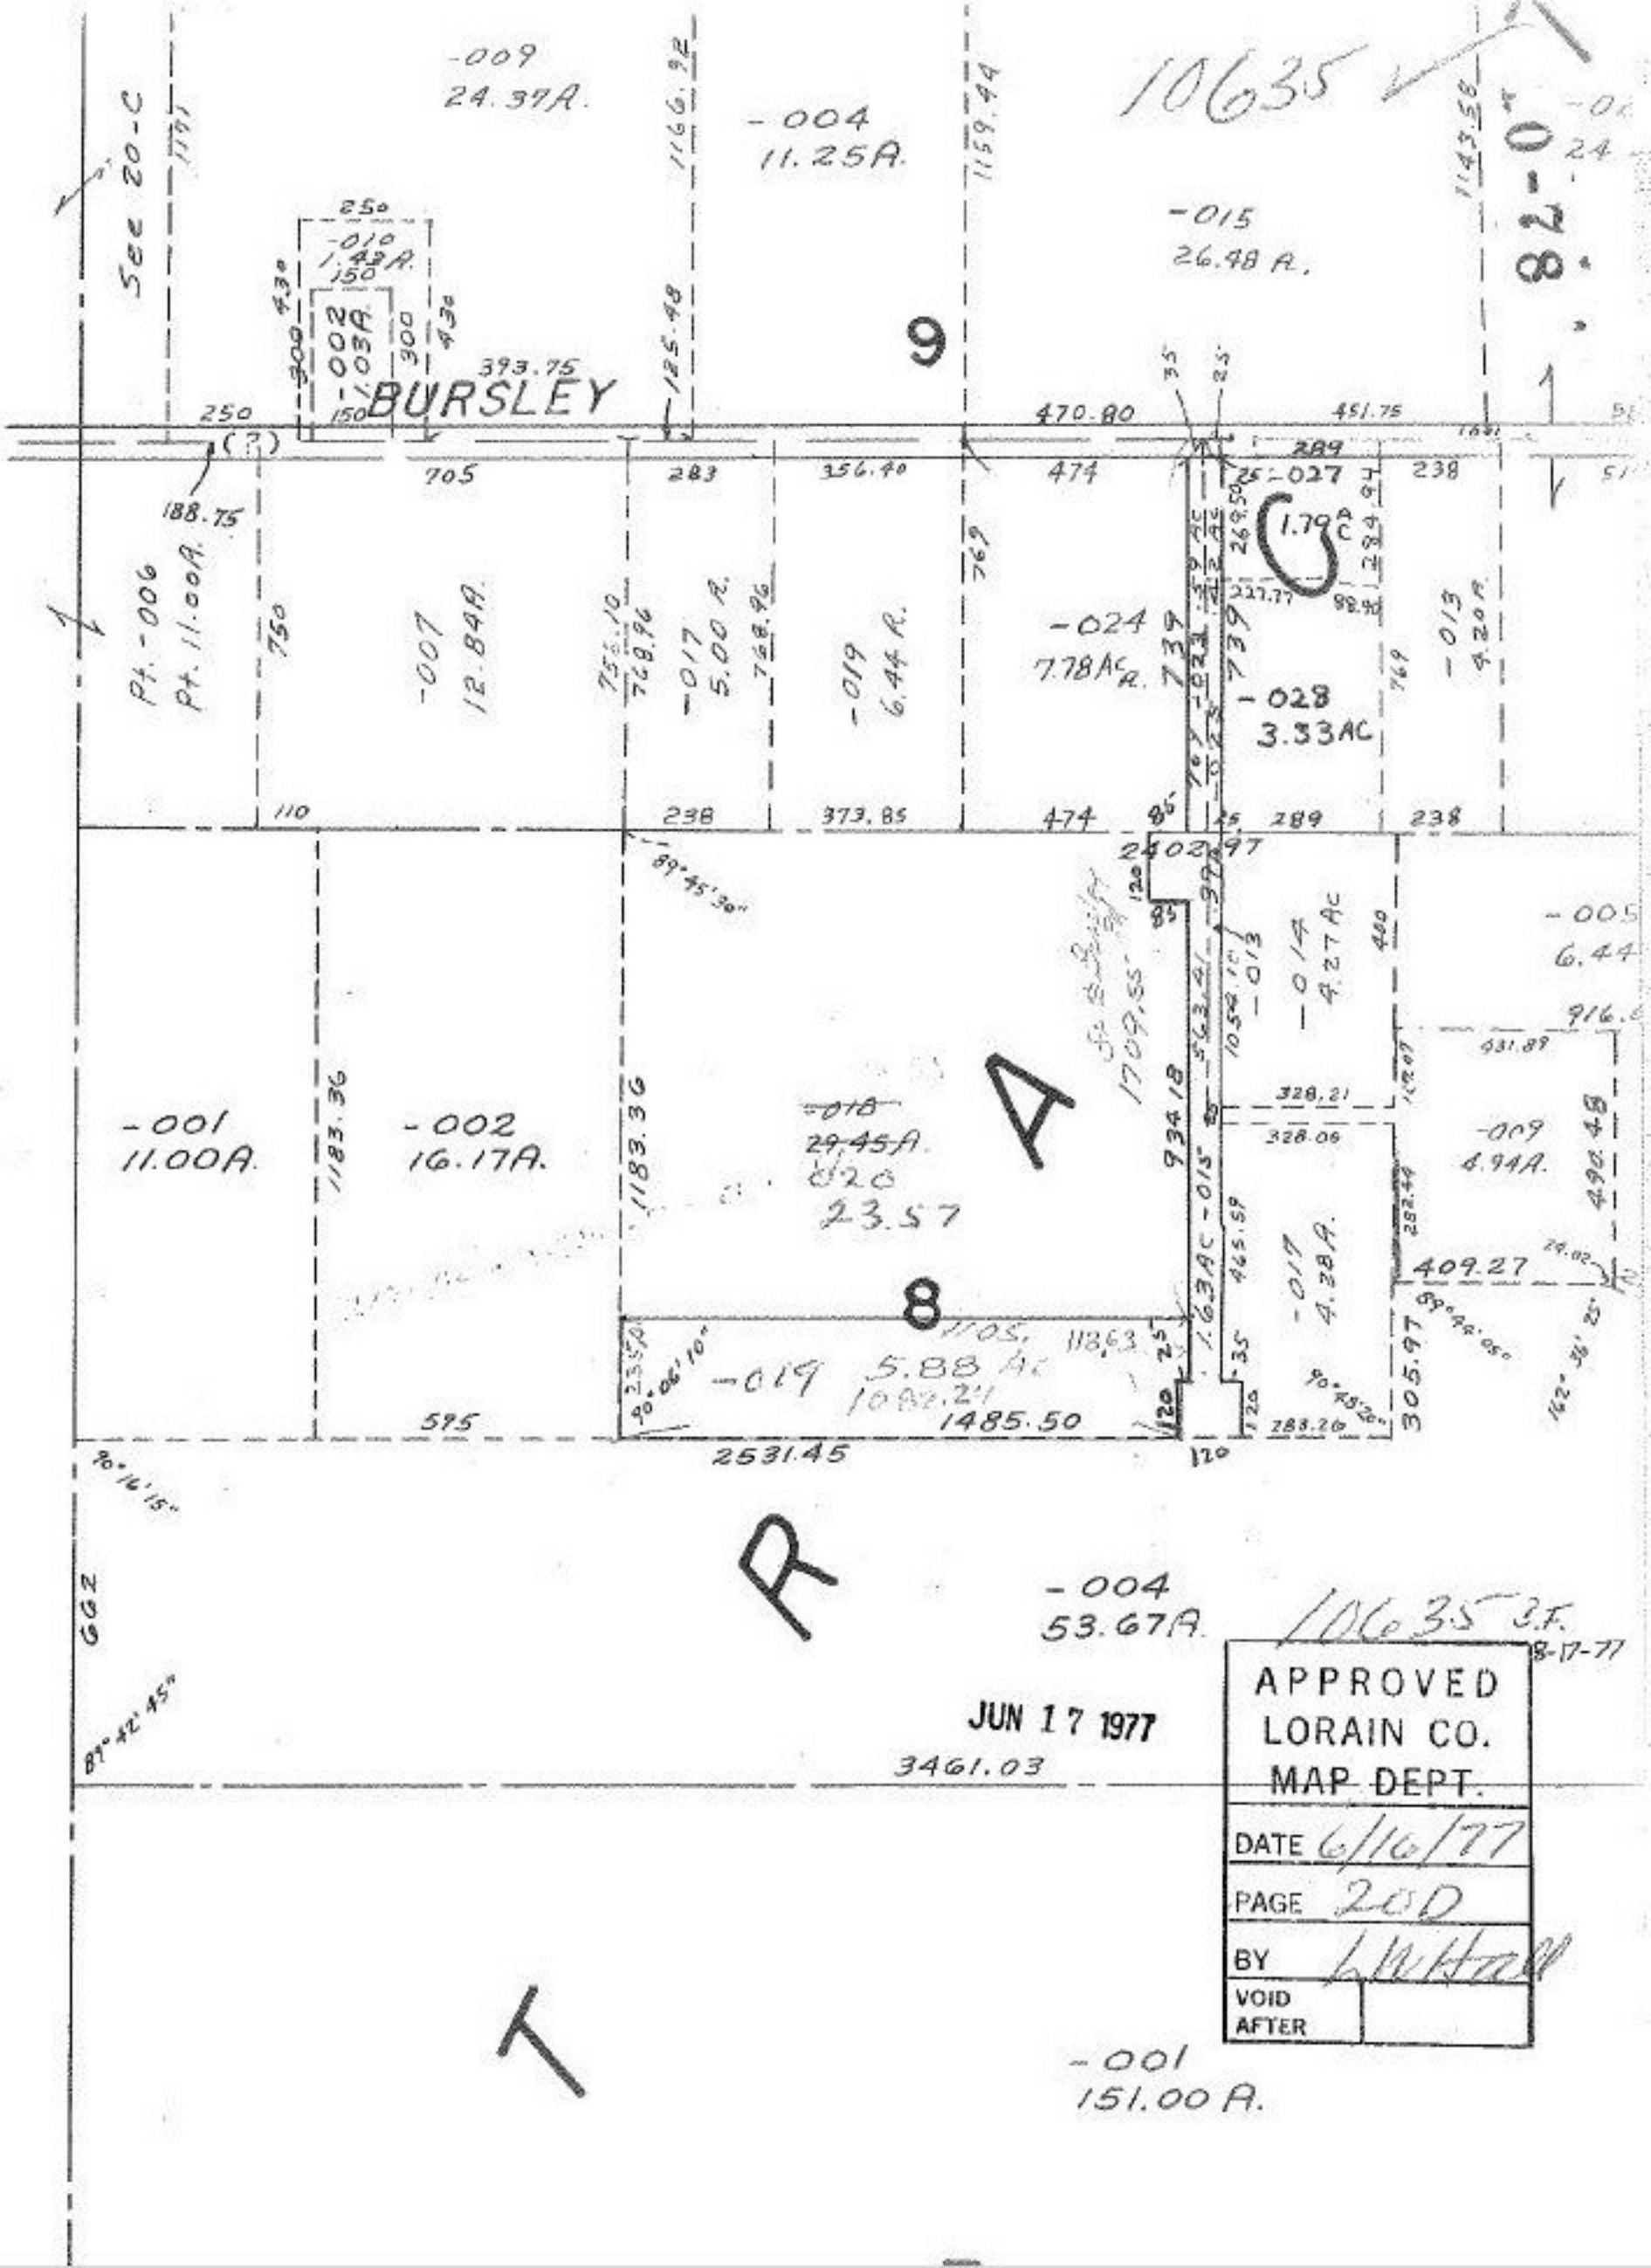
10635
-009
24.37A.
-004
11.25A.
-015
26.48 A.
See 20-C
-010
1.43A.
-002
1.03A.
BURSLEY
9
-027
1.79 AC
-024
7.78 AC A.
-028
3.33AC
-013
4.20 A.
Pt. -006
Pt. 11.00A.
-007
12.84A.
-017
5.00 A.
-019
6.44 A.
-001
11.00A.
-002
16.17A.
-018
29.45A.
020
23.57
-014
4.27 AC
-005
6.44
-009
4.94A.
-017
4.38A.
8
-019
5.88 AC
1485.50
2531.45
-004
53.67A.
10635 S.F.
8-17-77
JUN 17 1977
3461.03
APPROVED
LORAIN CO.
MAP DEPT.
DATE 6/16/77
PAGE 20D
BY L.W. Hall
VOID AFTER
-001
151.00 A.
T
R
A