#10642
10-781

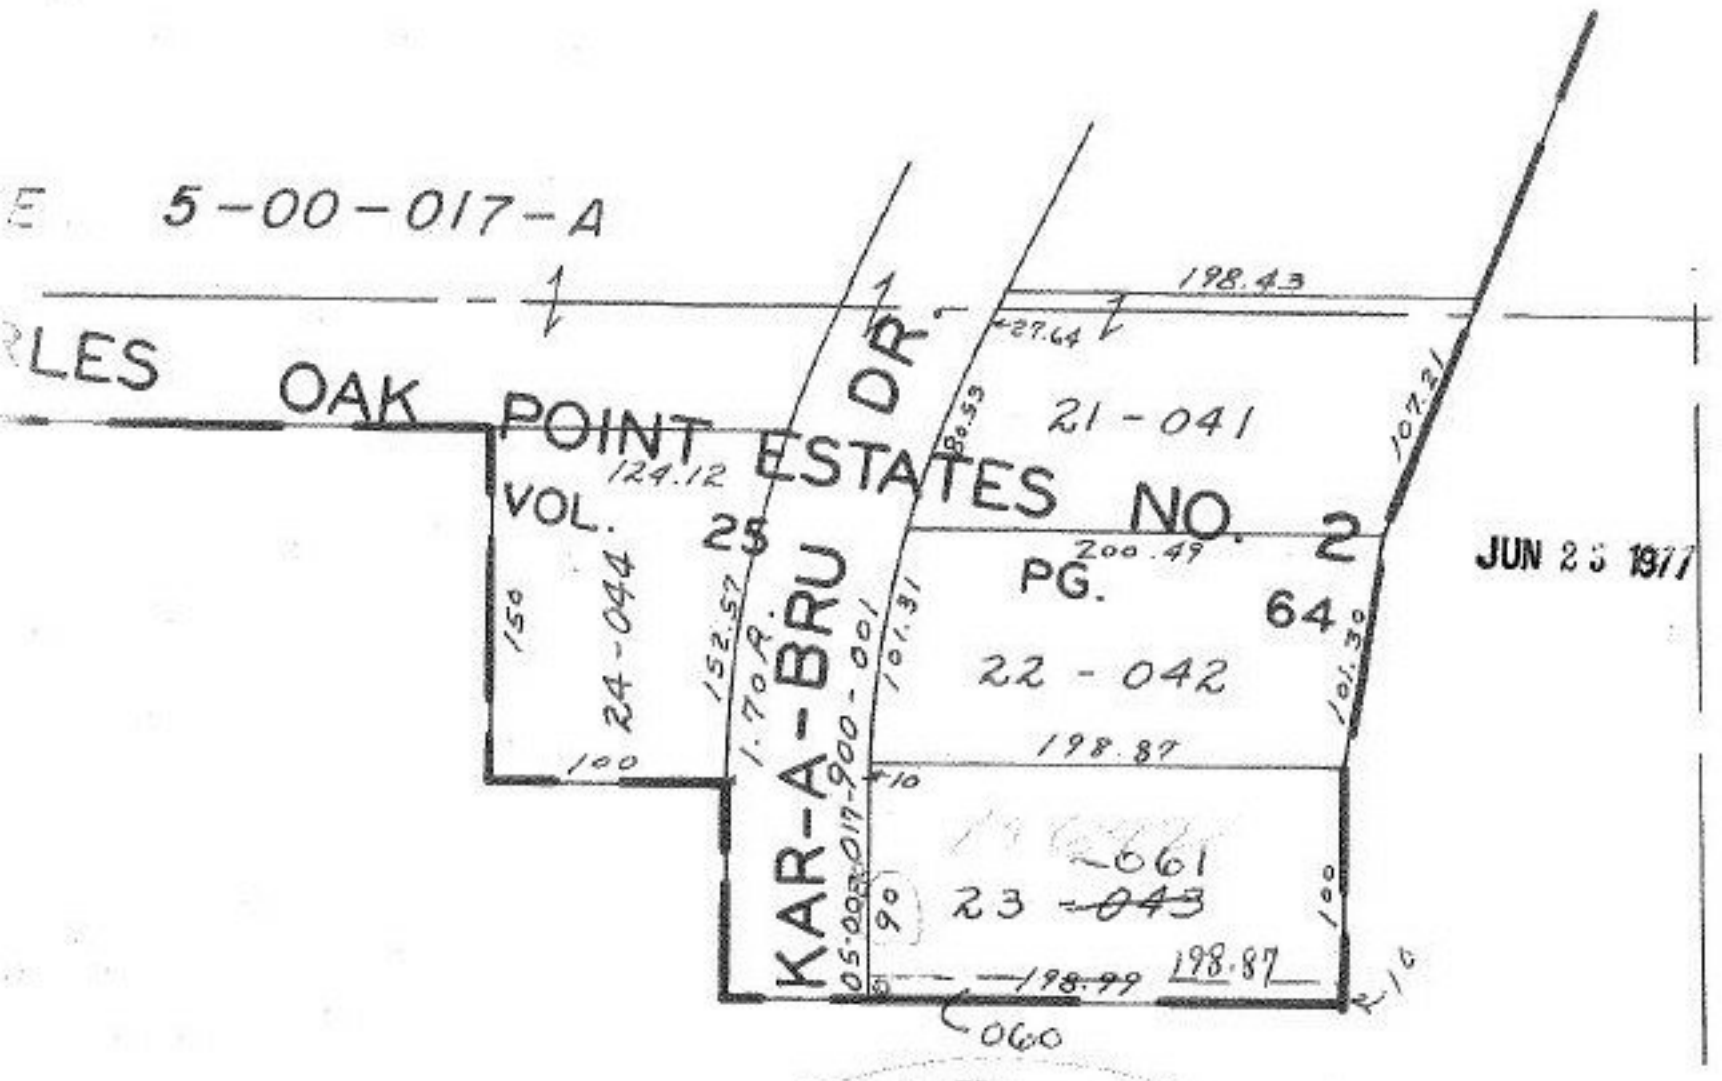

#10642

APPROVED
LORAIN CO.
MAP DEPT.
DATE 6-17-77
PAGE 5-00-016A
BY
VOID AFTER

MS

AUG 16 1977

Pt. -045
Pt. 48.87 A.

10230