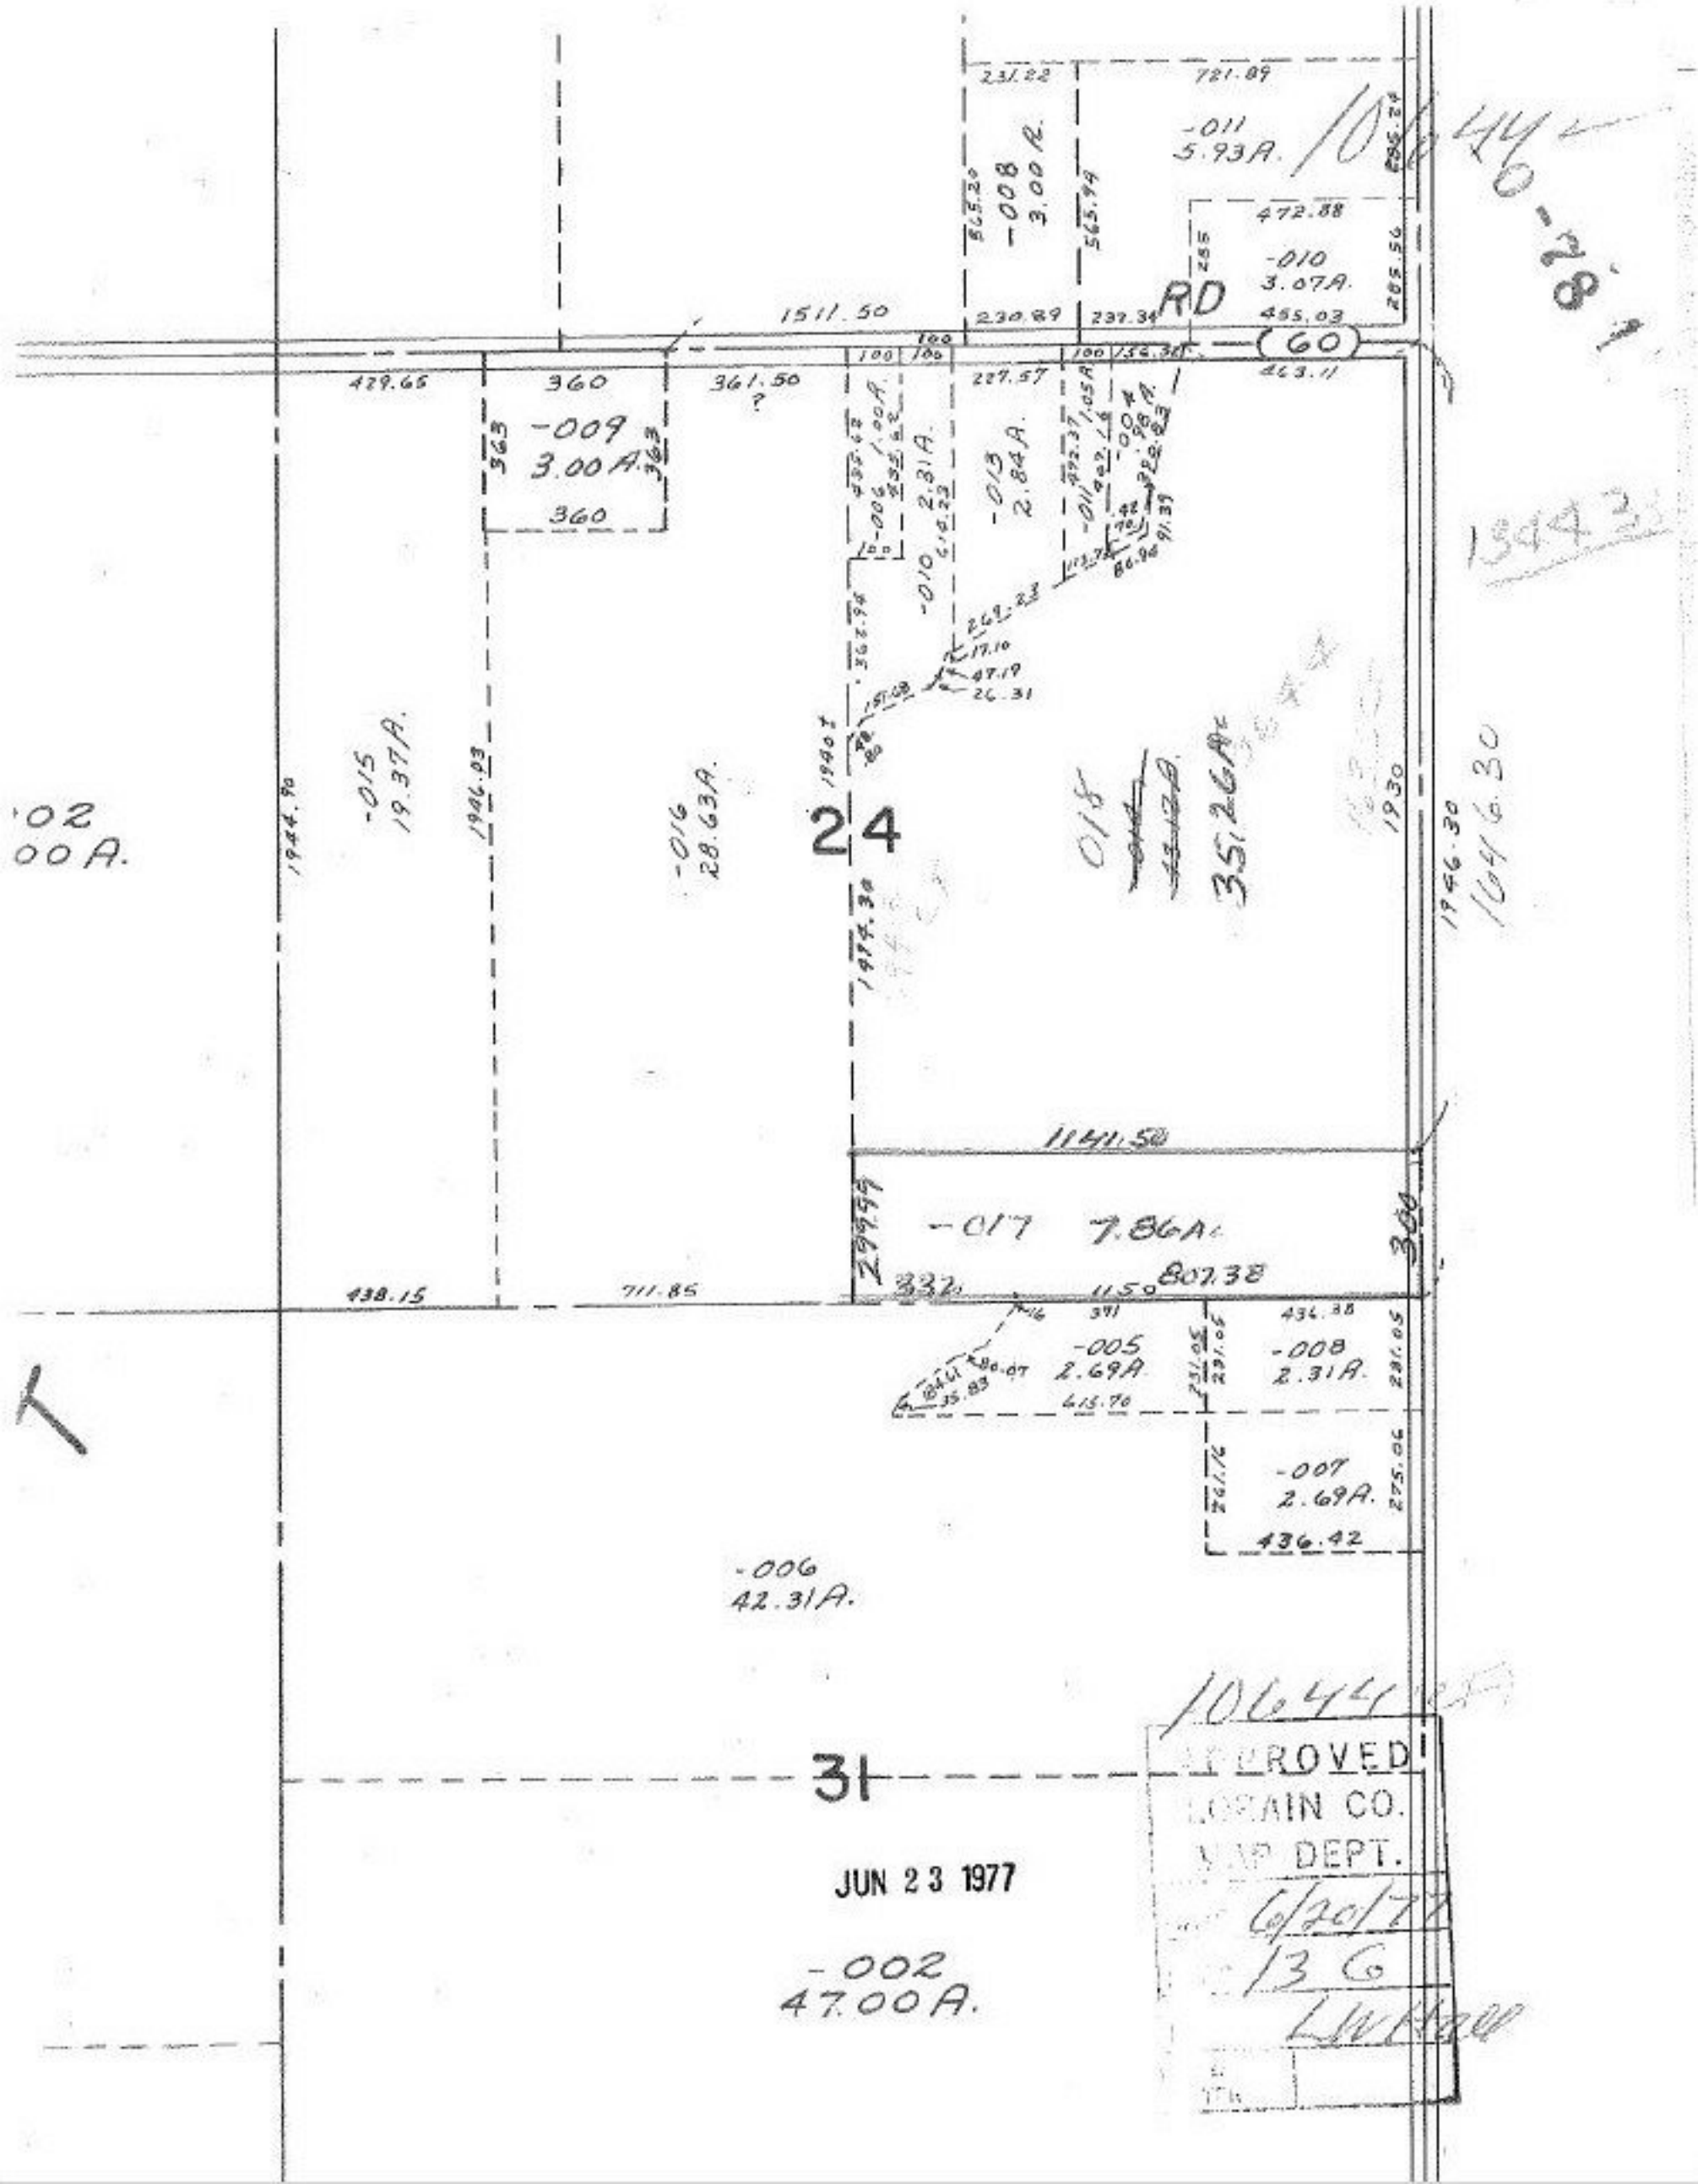



APPROVED
LORAIN CO.
MAP DEPT.
6/20/77
13 G
LWHall
JUN 23 1977