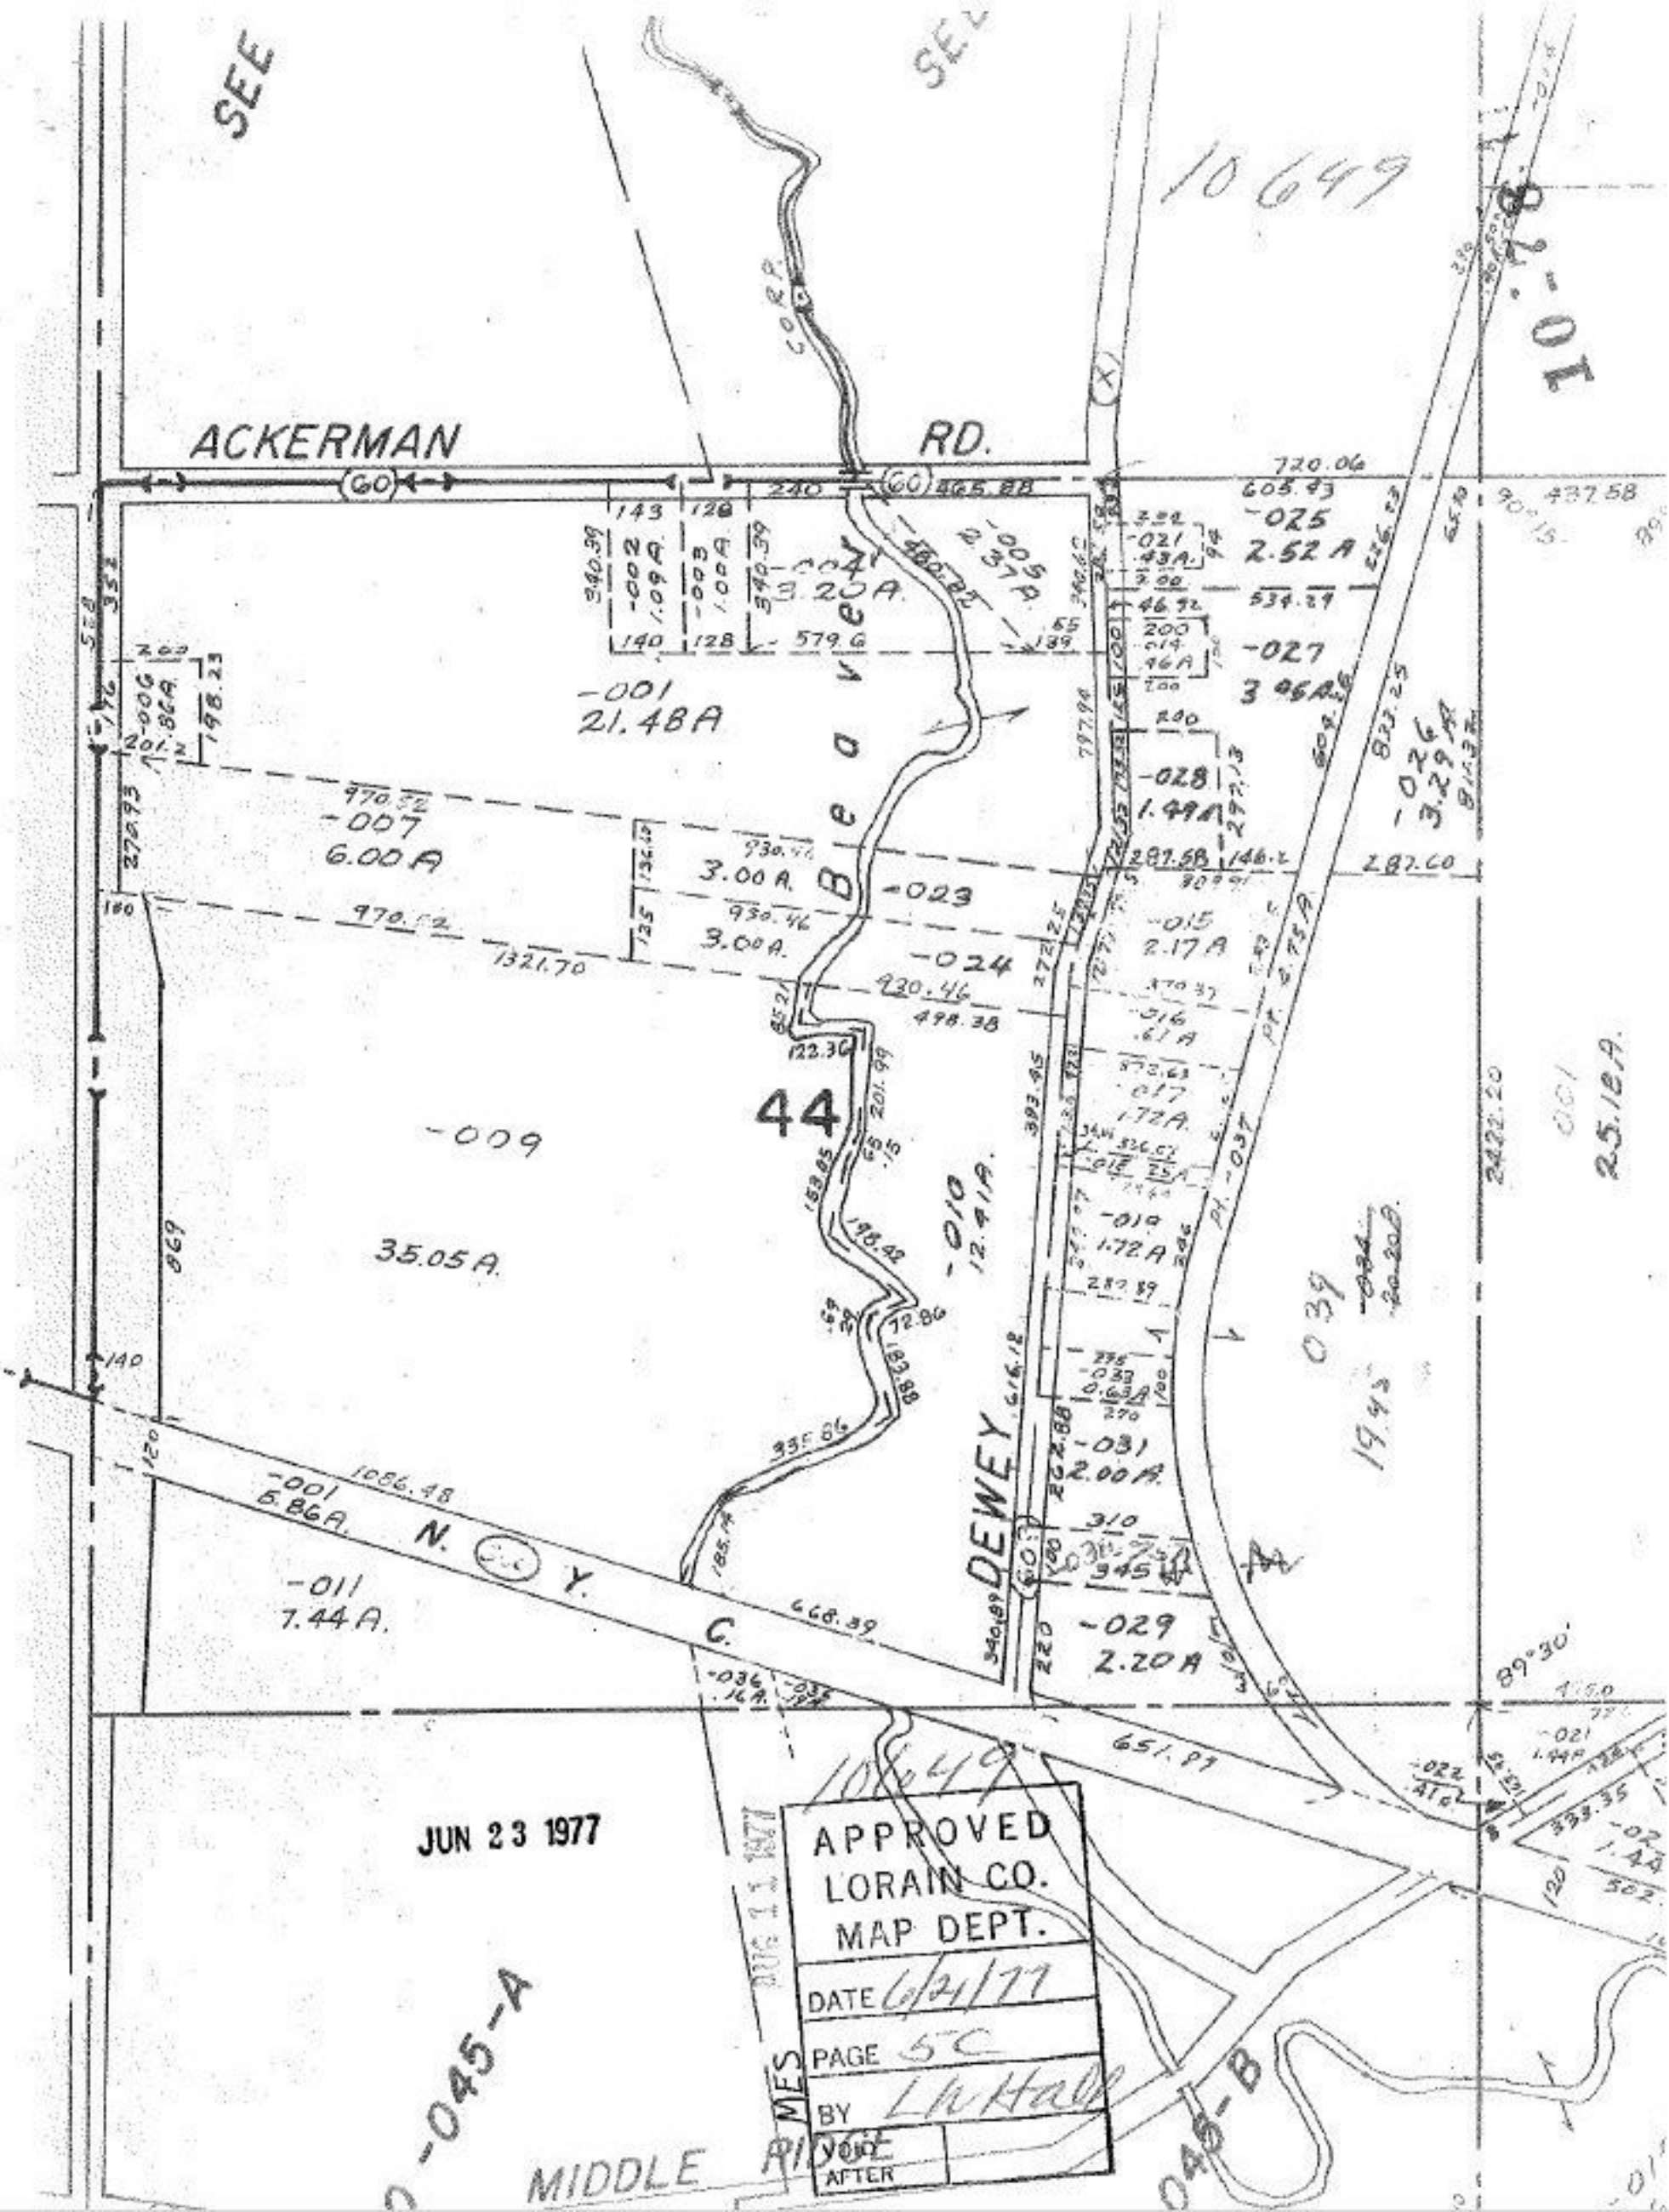

JUN 23 1977

APPROVED
LORAIN CO.
MAP DEPT.
DATE 6/21/77
PAGE 5C
BY LH Hall
VOID
AFTER