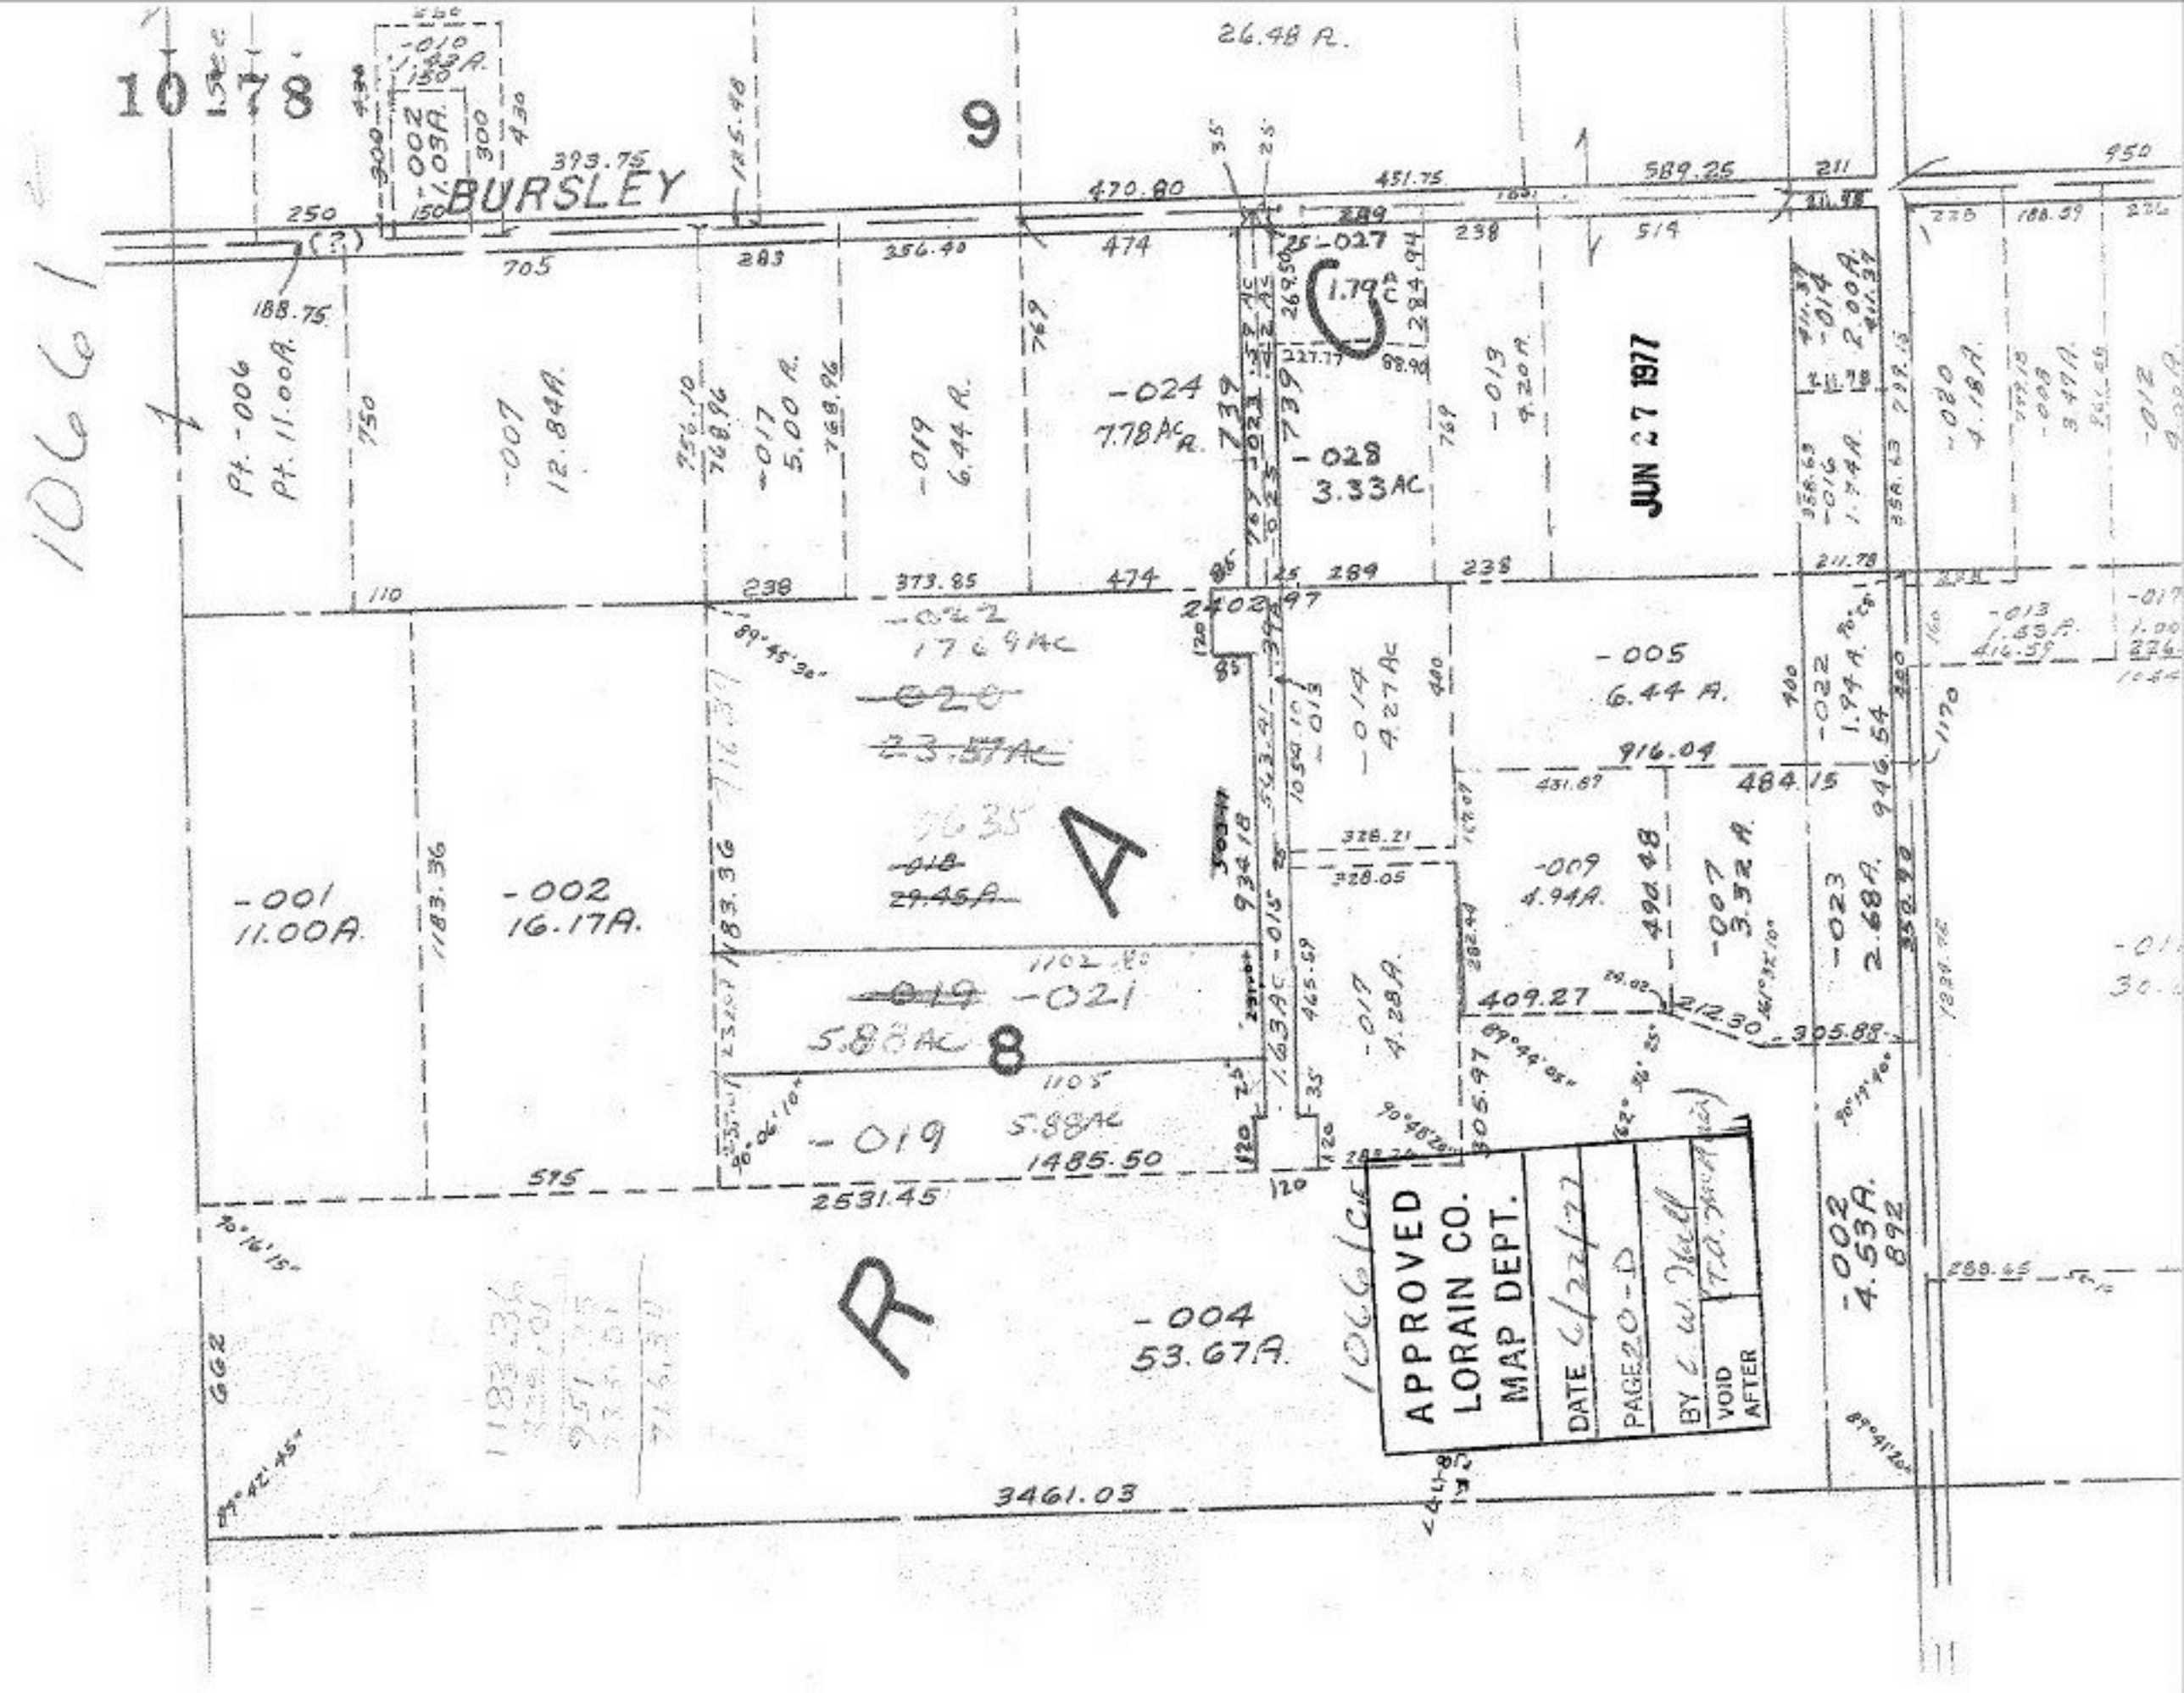
10178
9
BURSLEY
26.48 A.
JUN 27 1977
-001
11.00A.
-002
16.17A.
-004
53.67A.
-005
6.44 A.
-007
12.84A.
-009
4.94A.
-017
5.00 A.
-019
6.44 A.
-021
5.88AC
-024
7.78AC
-028
3.33AC
-027
1.79AC
-022
1.94 A.
-023
2.68A.
-002
4.53A.
-014
4.27AC
-017
4.28A.
-020
4.18A.
-019
5.88AC
-018
29.45A.
-020
23.57AC
-022
1.69AC
-010
1.42A.
-002
1.03A.
-006
Pt. 11.00A.
Pt.
A
R
8
APPROVED
LORAIN CO.
MAP DEPT.
DATE 6/22/77
PAGE 20-D
BY C. W. Hall
VOID AFTER
3461.03
2531.45
1485.50
916.04
484.15
409.27
212.30
305.88
1066 C