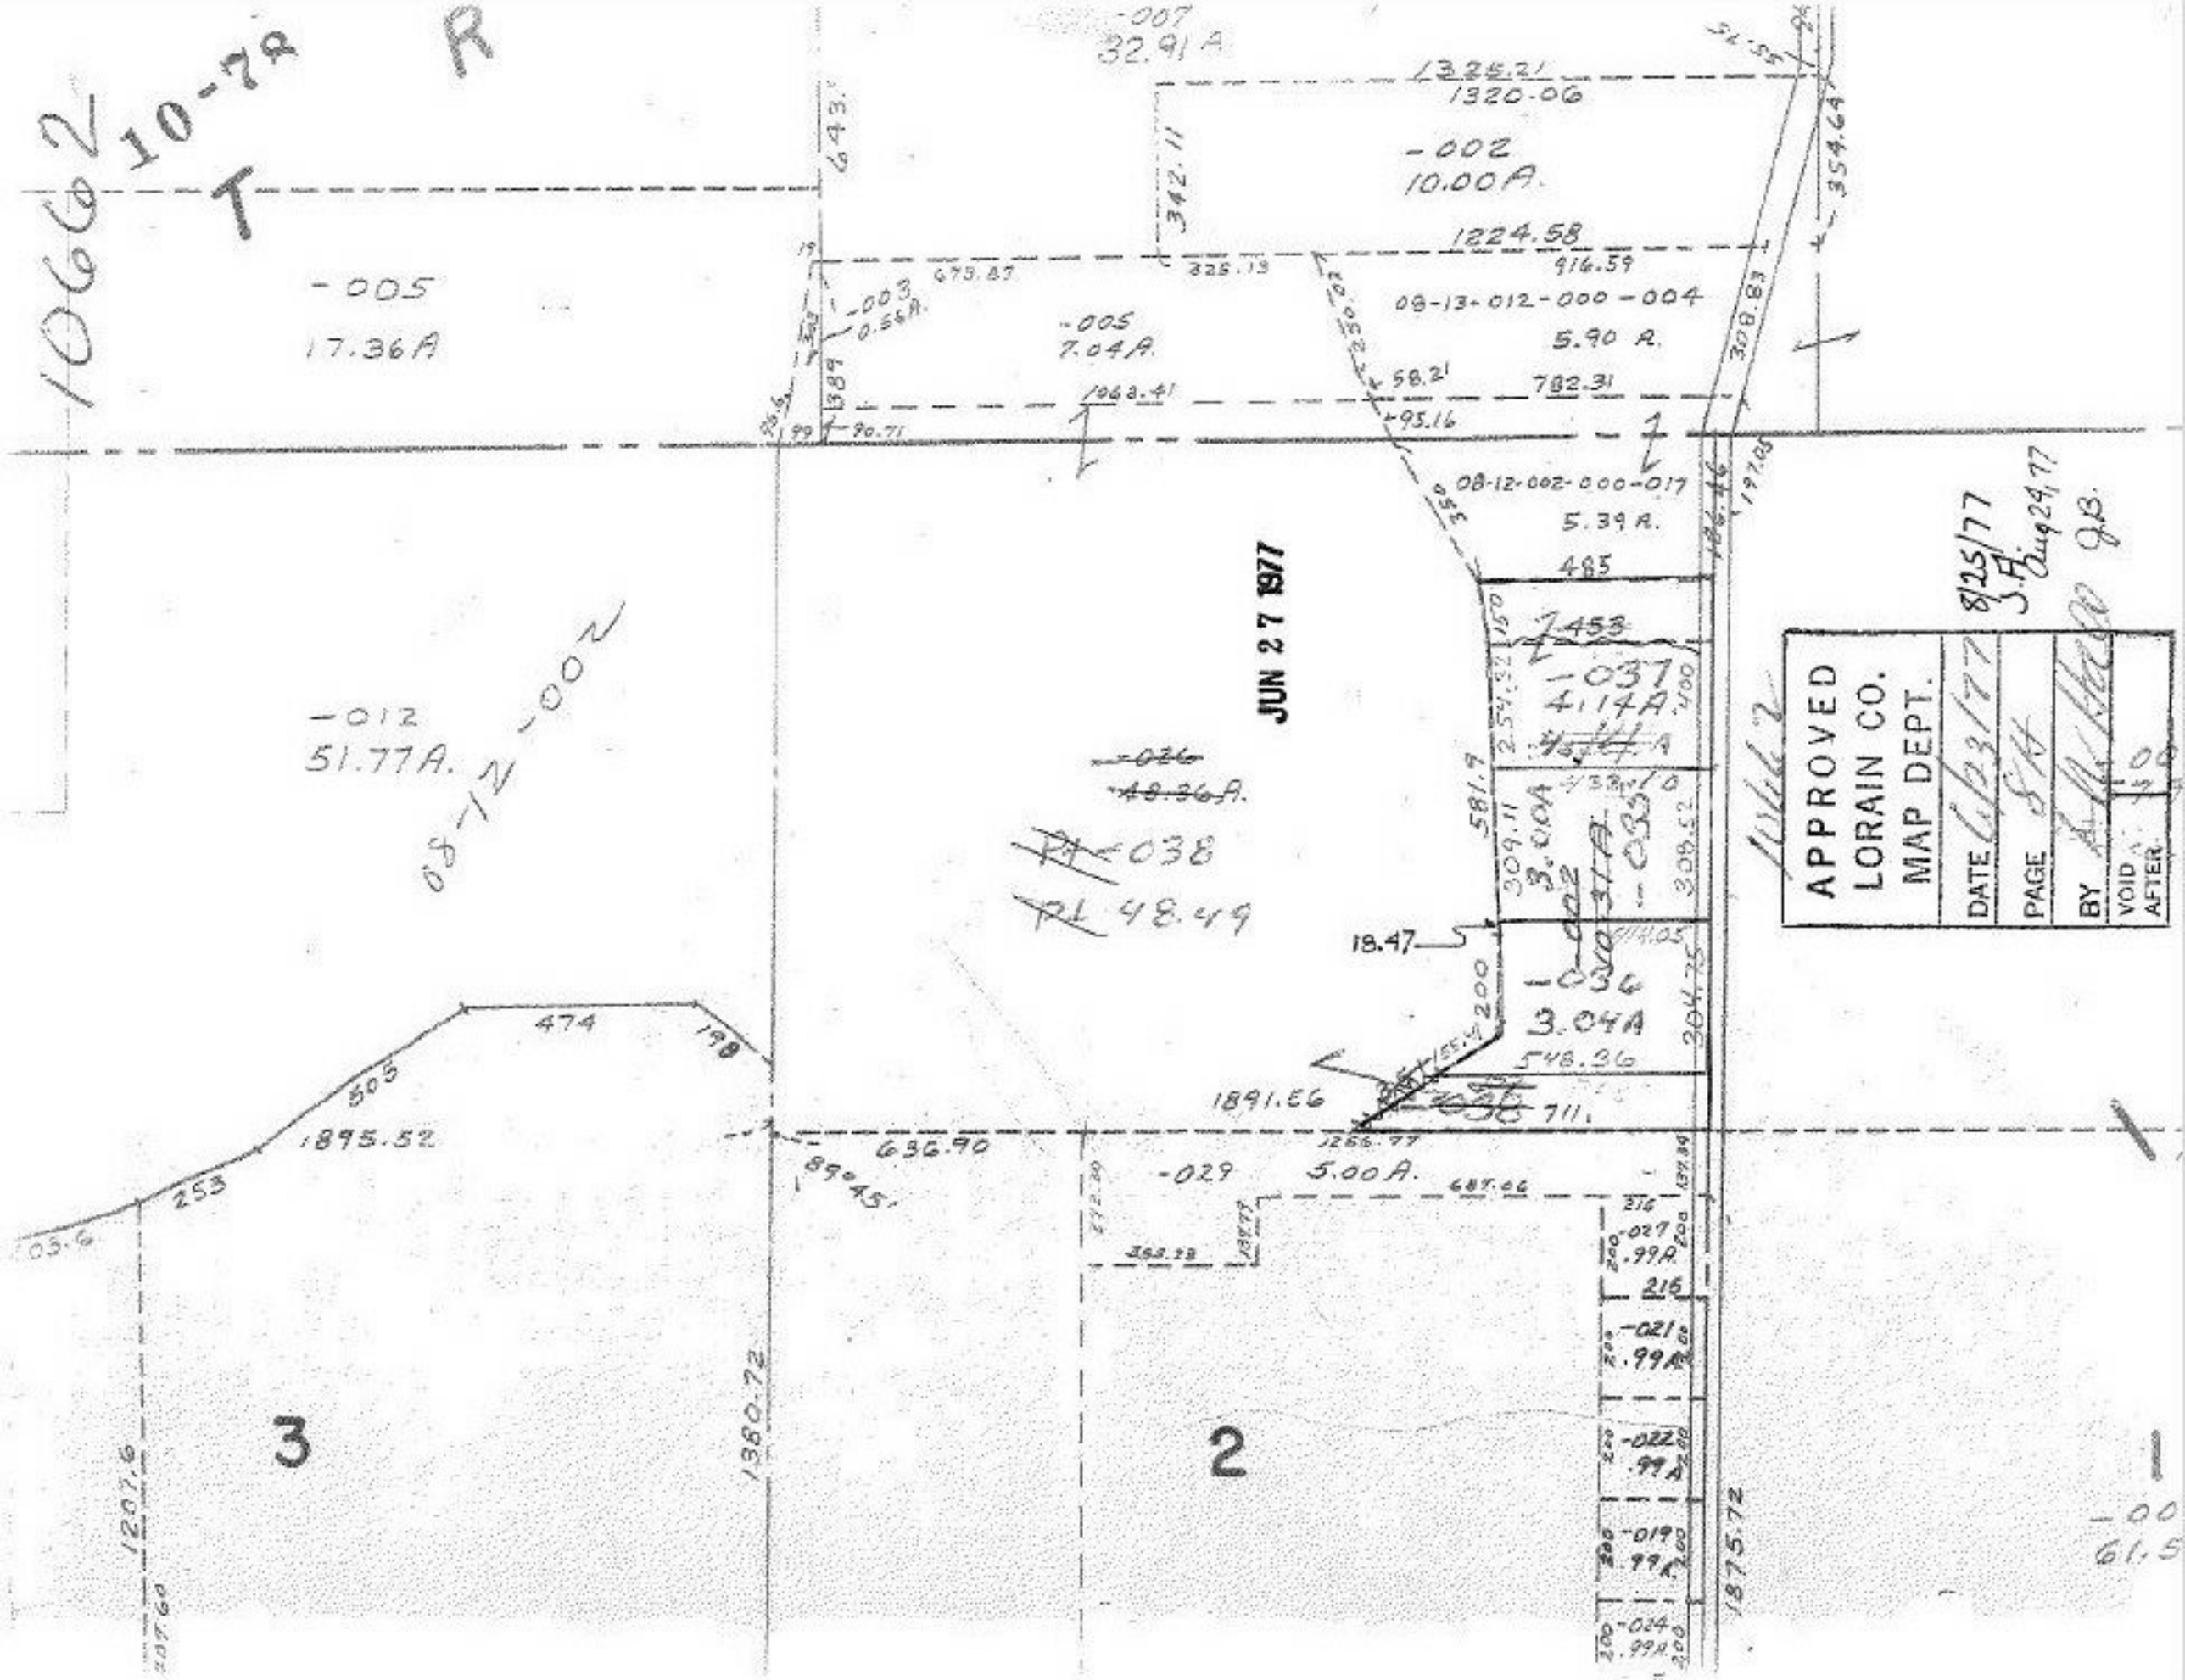

10662
10-78
T
R
-007
32.91 A
1325.21
1320.06
-002
10.00 A.
1224.58
916.59
08-13-012-000-004
5.90 A.
782.31
-005
17.36 A
-003
0.56 A.
-005
7.04 A.
1068.41
08-12-002-000-017
5.39 A.
485
-012
51.77 A.
08-12-002
-026
48.36 A.
PL 038
PL 48.49
JUN 27 1977
-037
4.14 A.
-036
3.04 A
548.36
18.47
1891.56
711.
636.90
89°45'
-029
5.00 A.
687.06
474
198
505
1895.52
253
1380.72
1207.6
1875.72
3
2
1
APPROVED
LORAIN CO.
MAP DEPT.
DATE 6/23/77
PAGE 8H
BY
VOID AFTER
8/25/77
S.A.
Aug 24, 77
J.B.