10672

10:78

APPROVED
LORAIN CO.
MAP DEPT.

JUN 29 1977

DATE 6/27/77 8/24/77

PAGE 10-00-004 H

BY L.W. Hall (T.W. McNair)
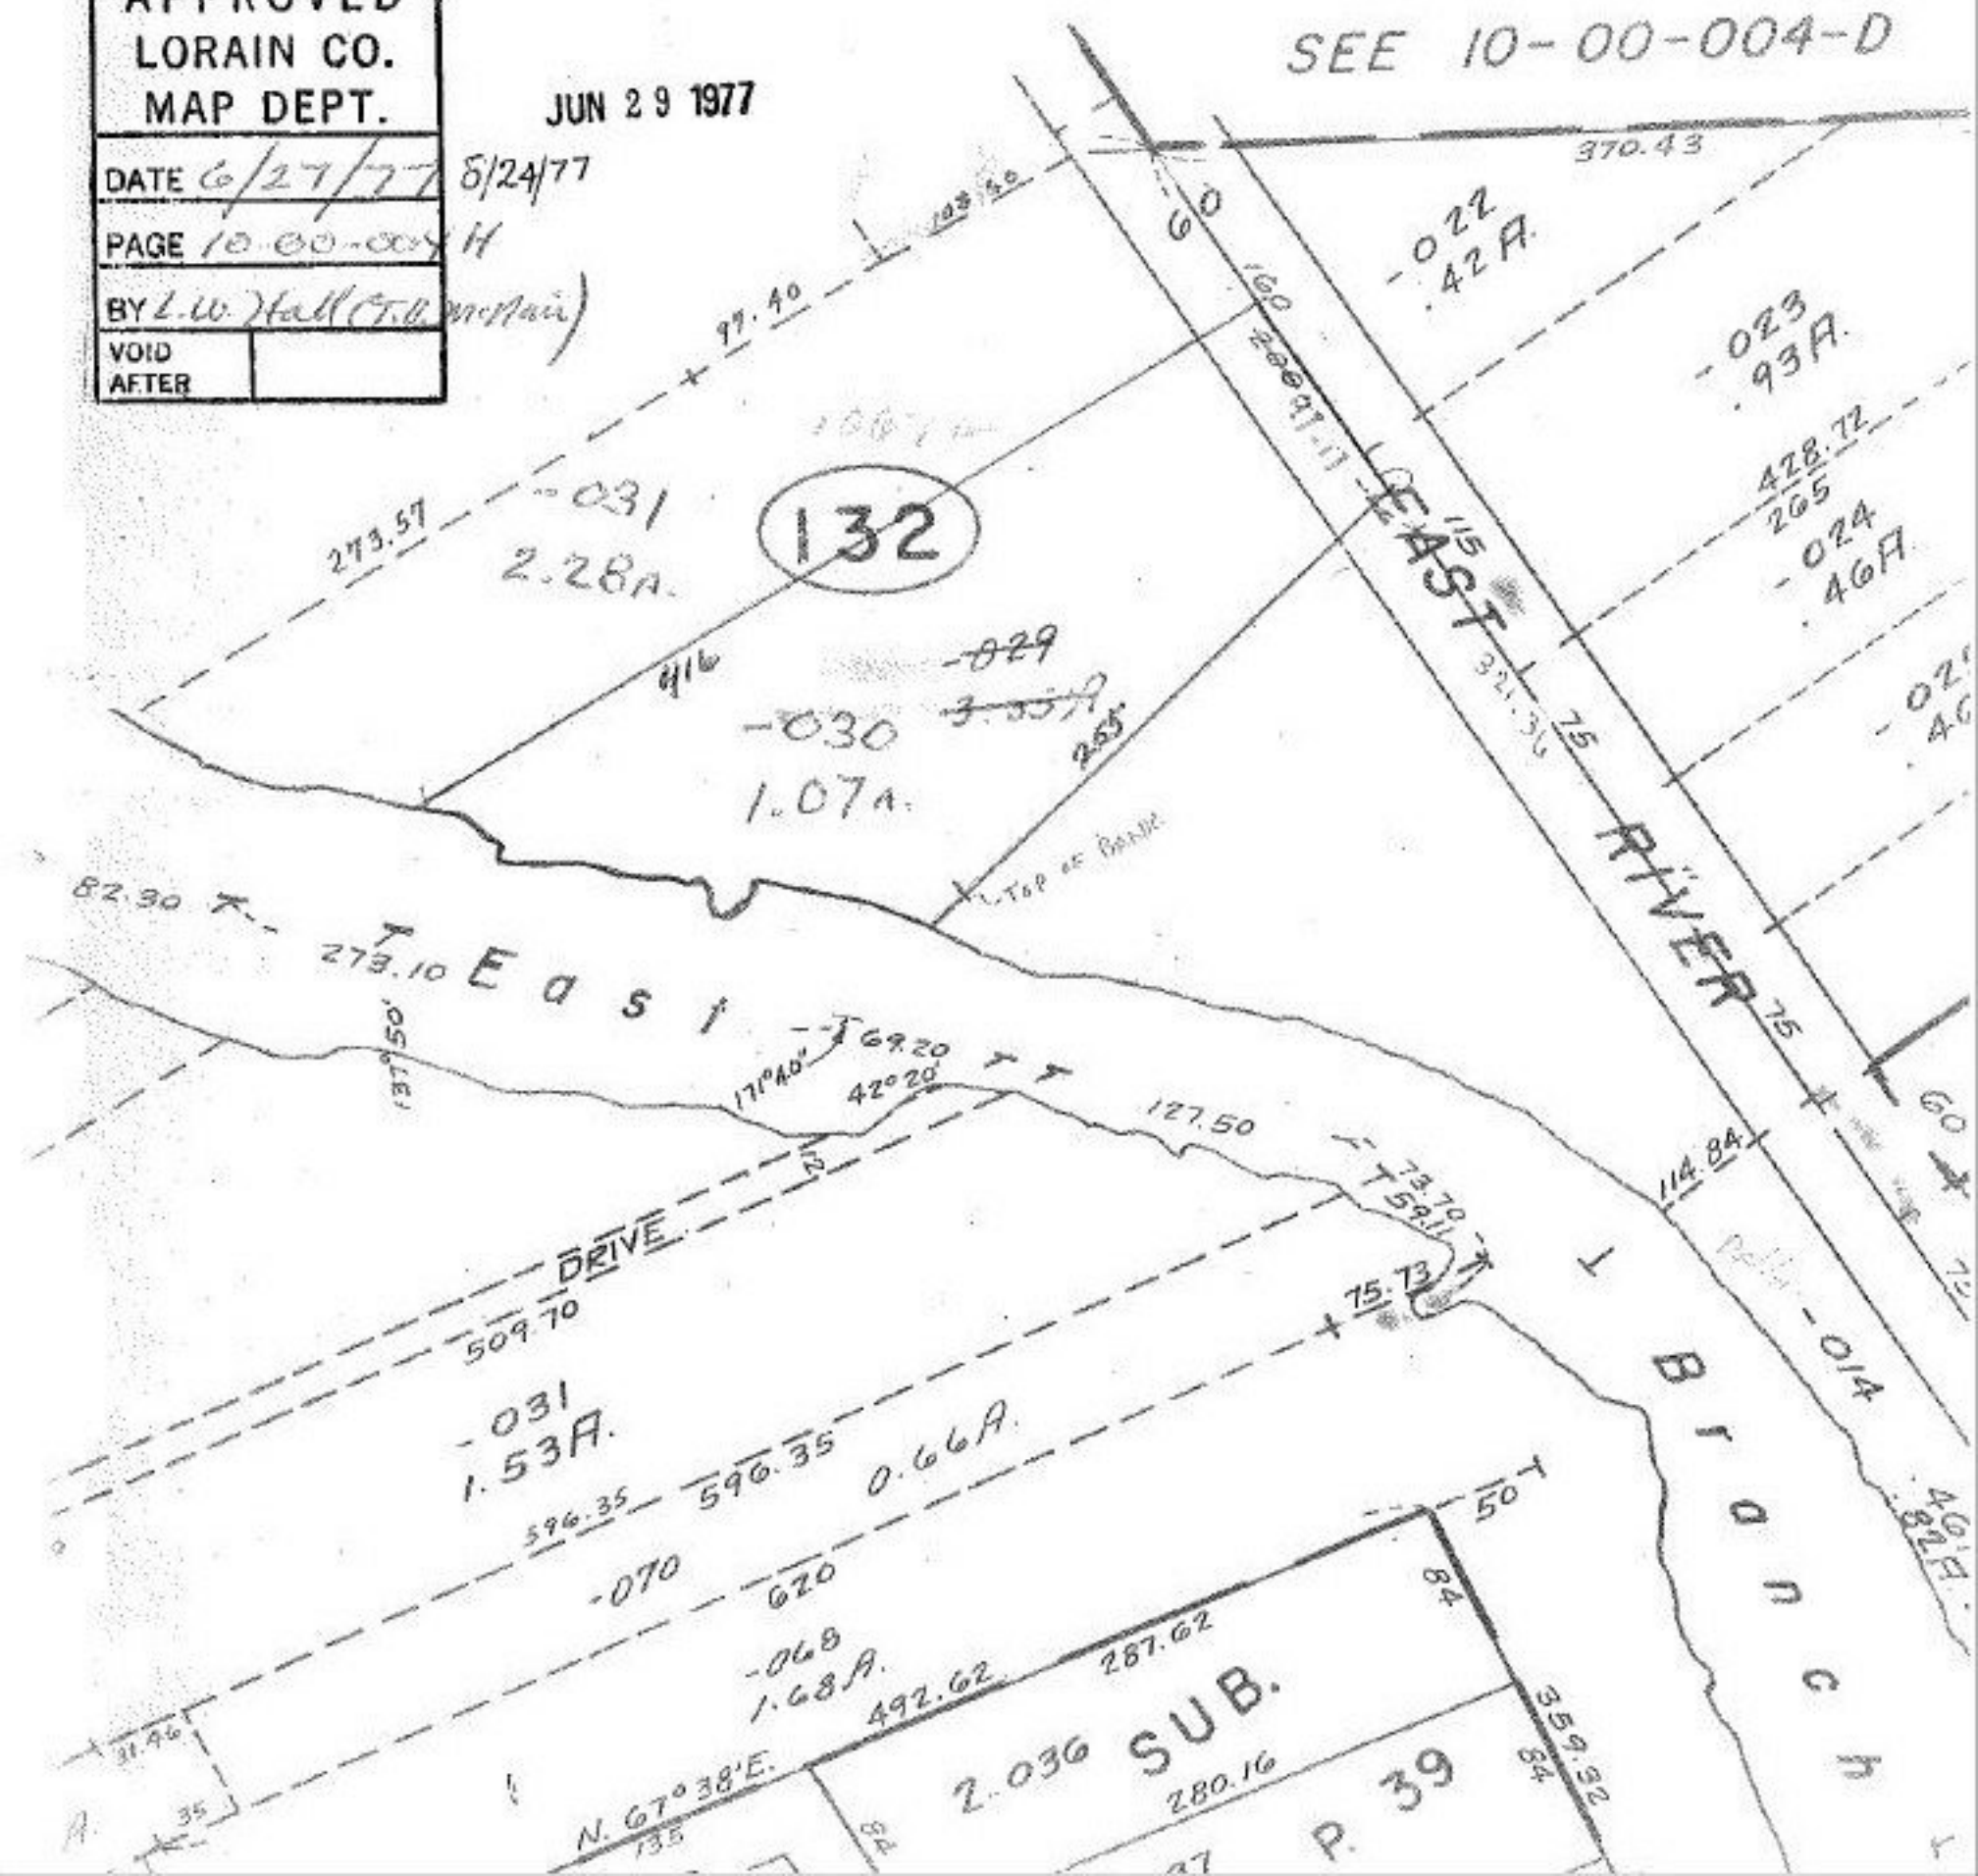
VOID AFTER