


SEE

SEE

10697

SEE 1-08 1035A

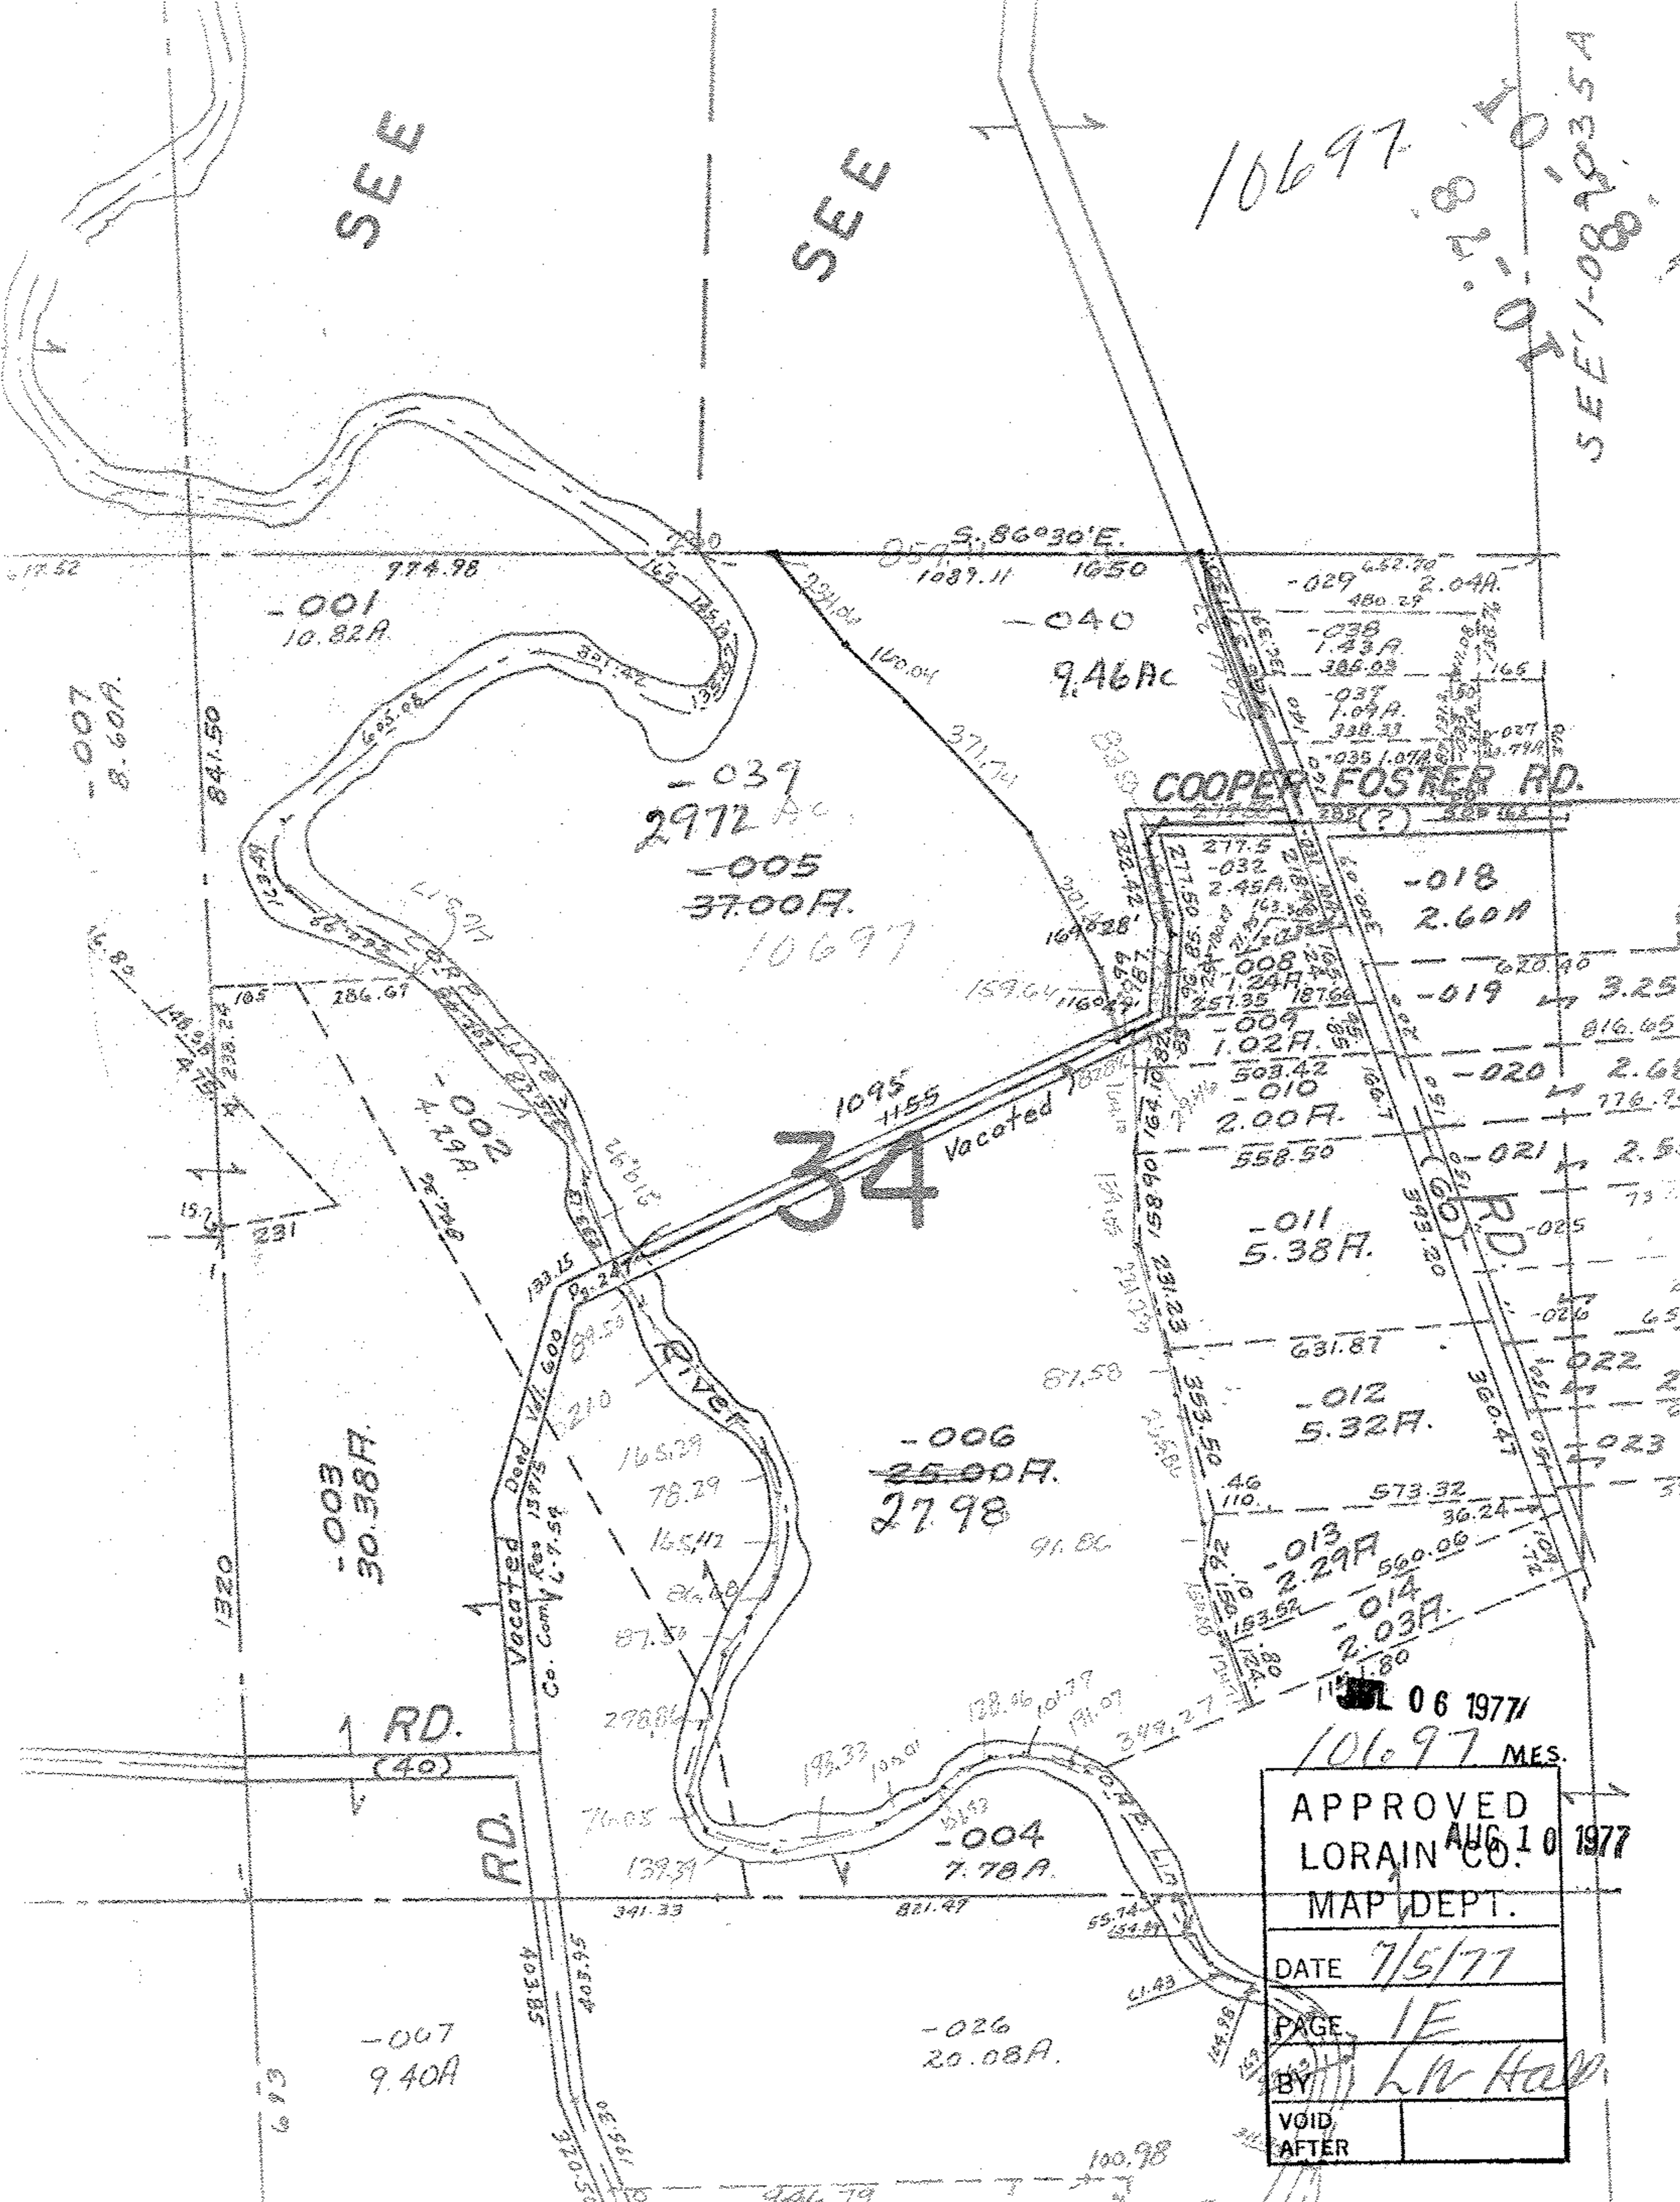

APPROVED
LORAIN CO. 10 1977
MAP DEPT.

DATE 7/5/77

PAGE 1E

BY L.R. Hall

VOID AFTER