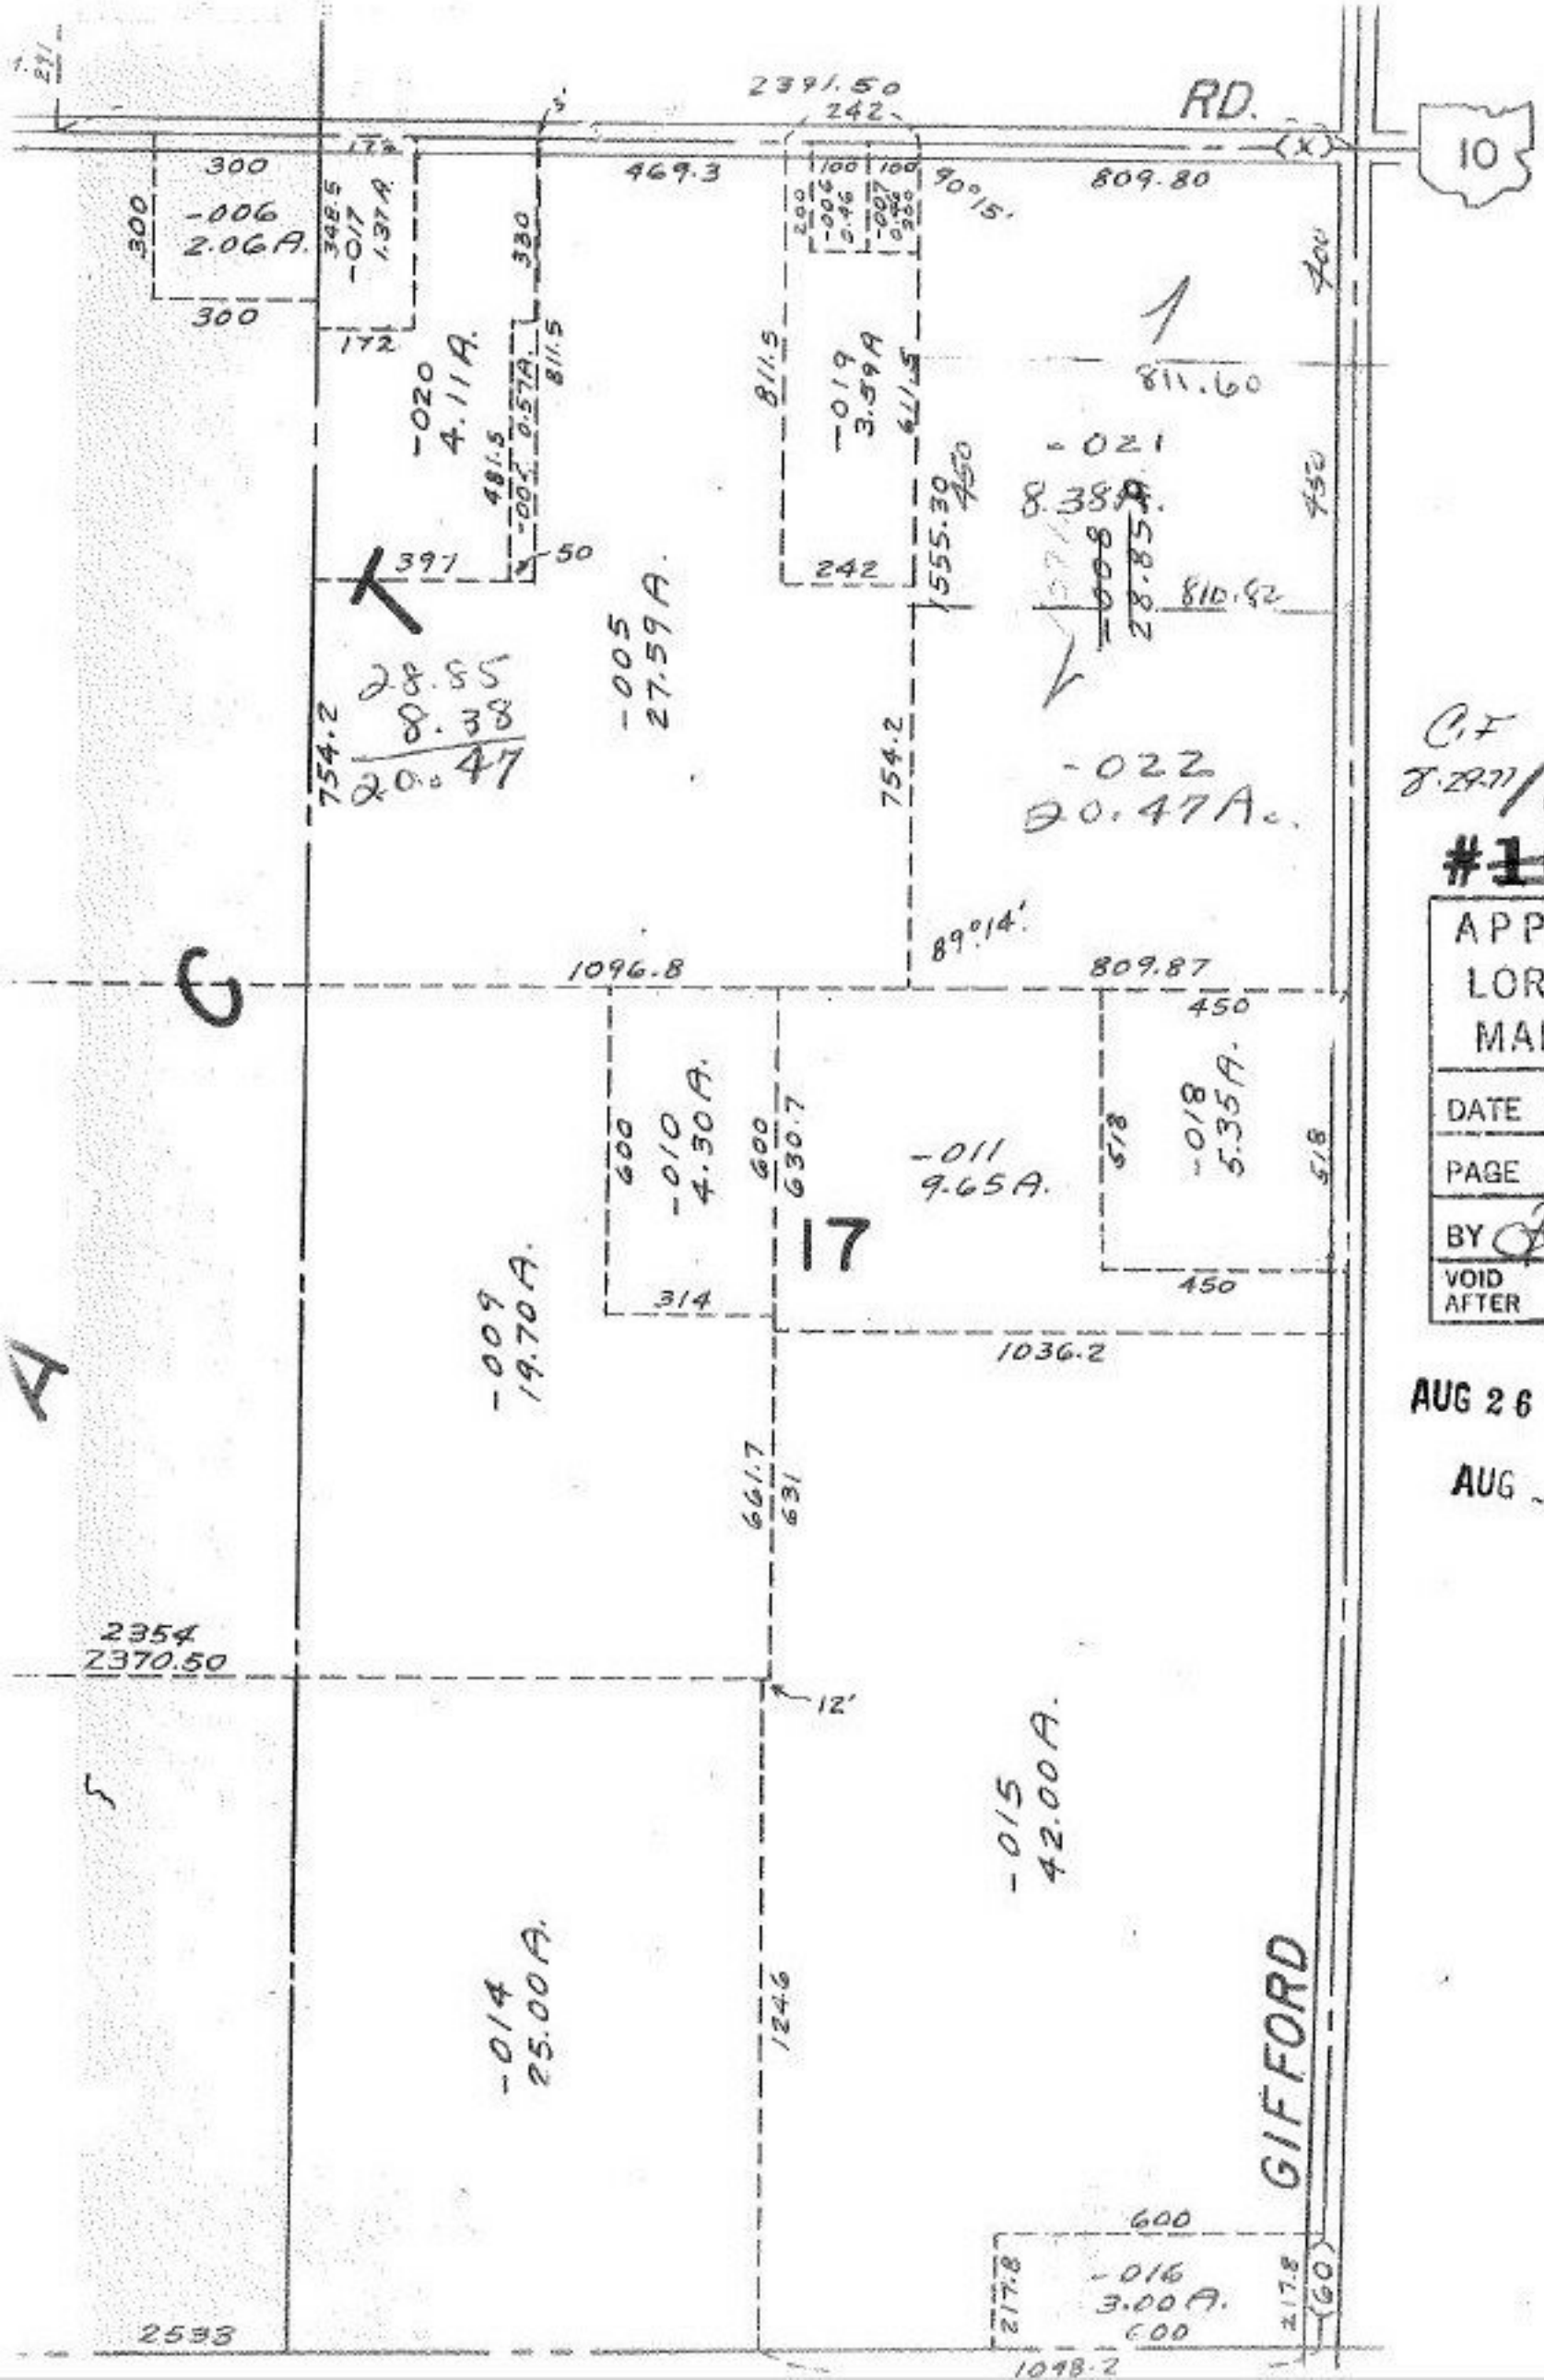

10711
10-78

C.F
8-29-77 10711

~~#10710~~

APPROVED
LORAIN CO.
MAP DEPT.

DATE 7-8-77

PAGE 8-G

BY [signature]

VOID AFTER

AUG 26 1977

AUG ... 1977