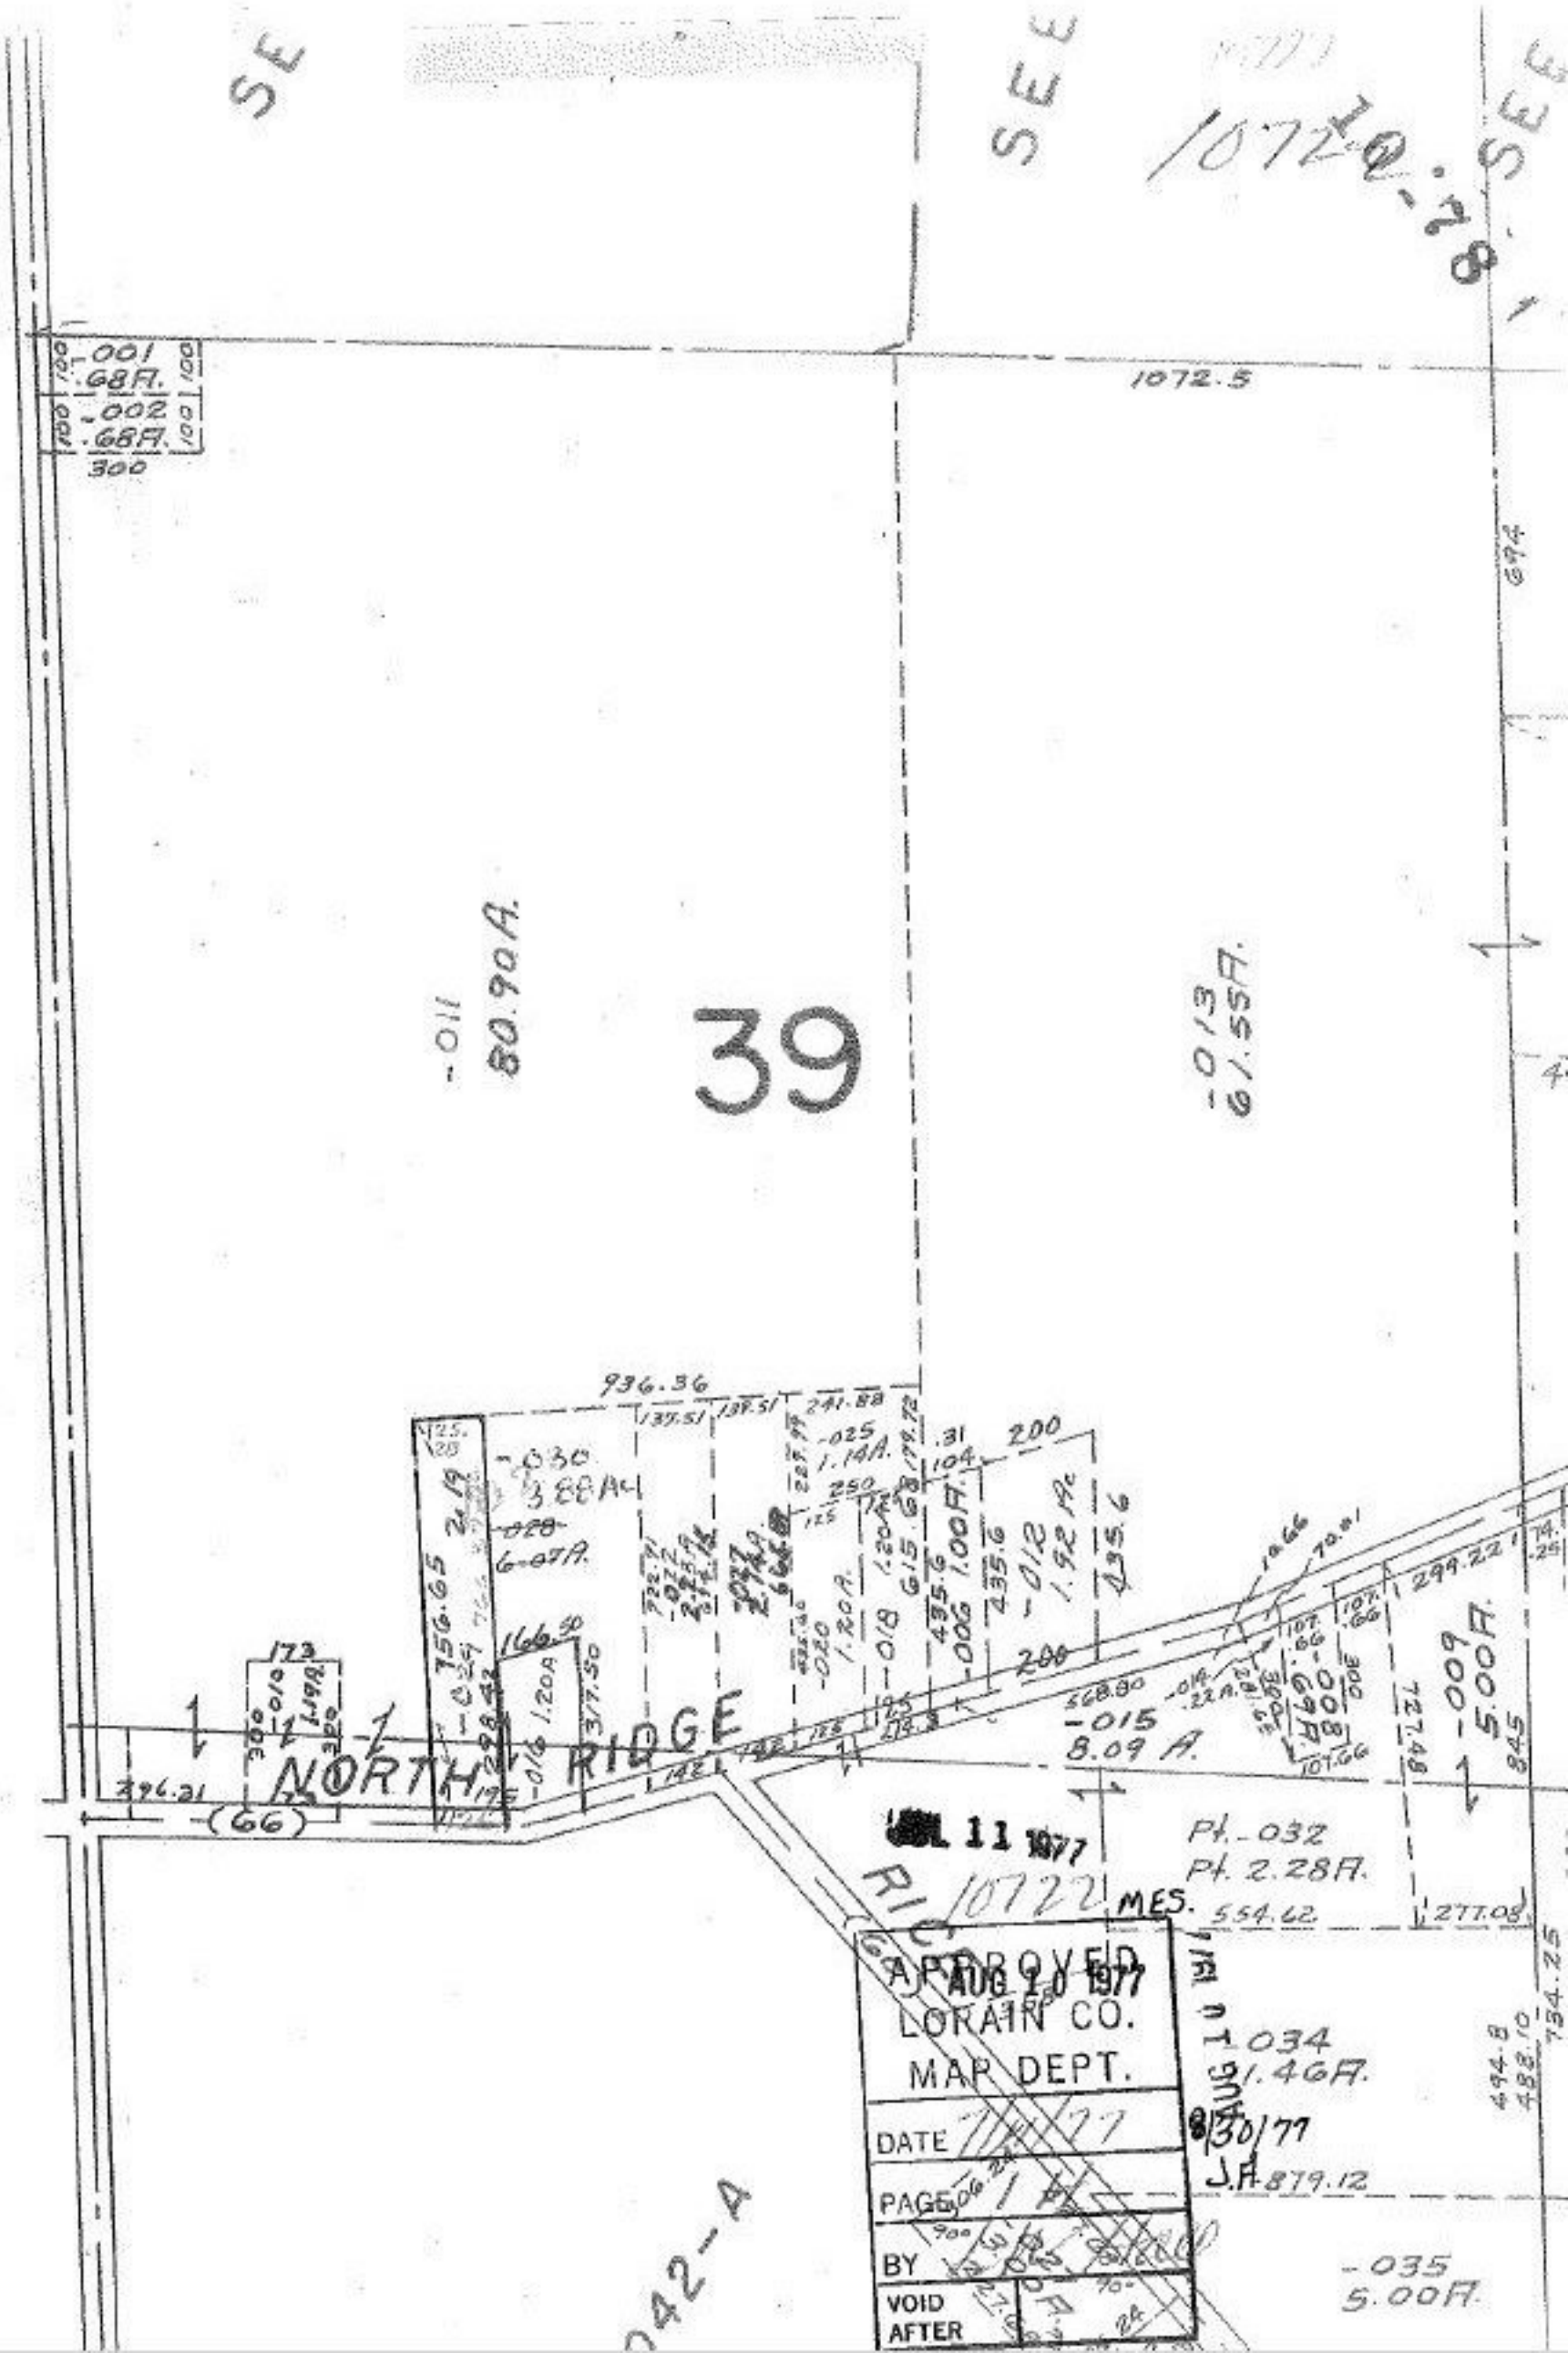

SEE
SEE
SEE
1072-0.78
1072.5
-001
.68A.
-002
.68A.
300
-011
80.90A.
39
-013
61.55A.
936.36
-030
3.88Ac
-028
6.07A.
-025
1.14A.
-012
1.92Ac
-015
8.09 A.
-009
5.00A.
NORTH RIDGE
(66)
Pt.-032
Pt. 2.28A.
MES.
554.62
277.08
-034
1.46A.
879.12
-035
5.00A.
042-A
APPROVED
AUG 10 1977
LORAIN CO.
MAP DEPT.
DATE
PAGE
BY
VOID
AFTER