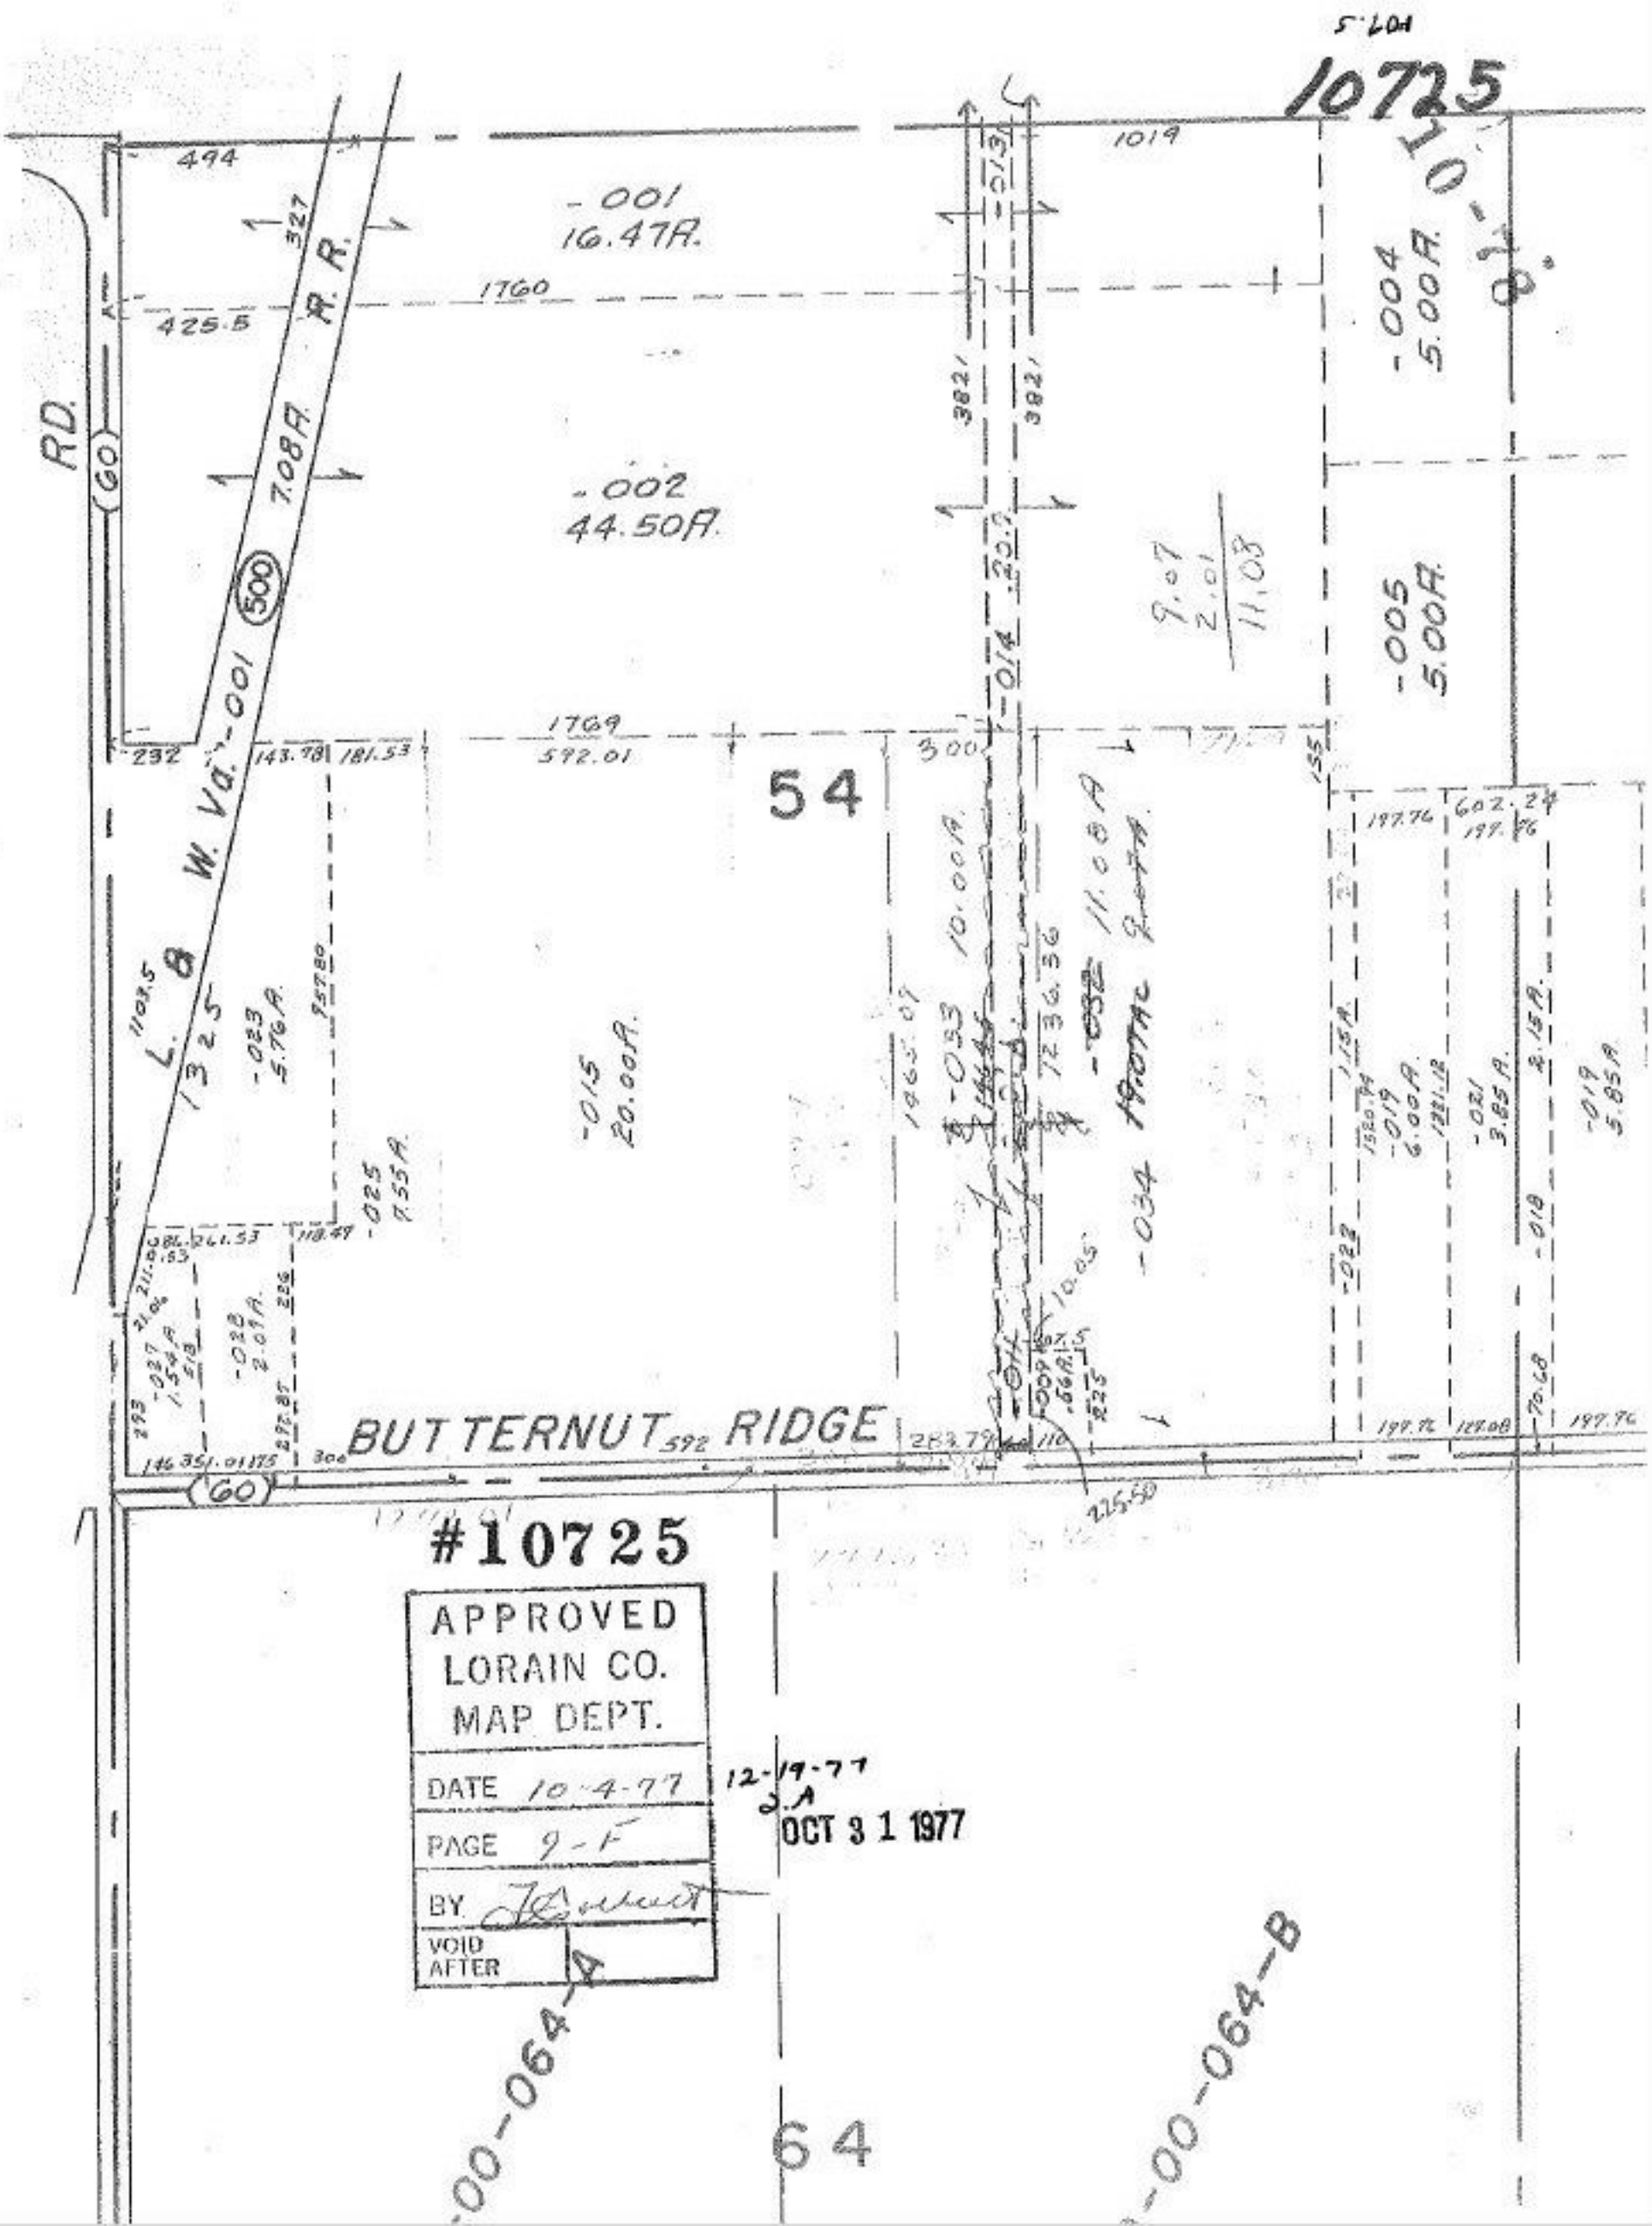
10725
RD.
(60)
R. R.
7.08A.
-001
16.47A.
-002
44.50A.
-004
5.00A.
-005
5.00A.
-015
20.00A.
-023
5.76A.
-025
7.55A.
-028
2.09A.
-033
10.00A.
-034
11.08A
19.07AC
54
BUTTERNUT RIDGE
(60)
#10725
APPROVED
LORAIN CO.
MAP DEPT.
DATE 10-4-77
PAGE 9-F
BY
VOID AFTER
12-19-77
OCT 3 1 1977
64