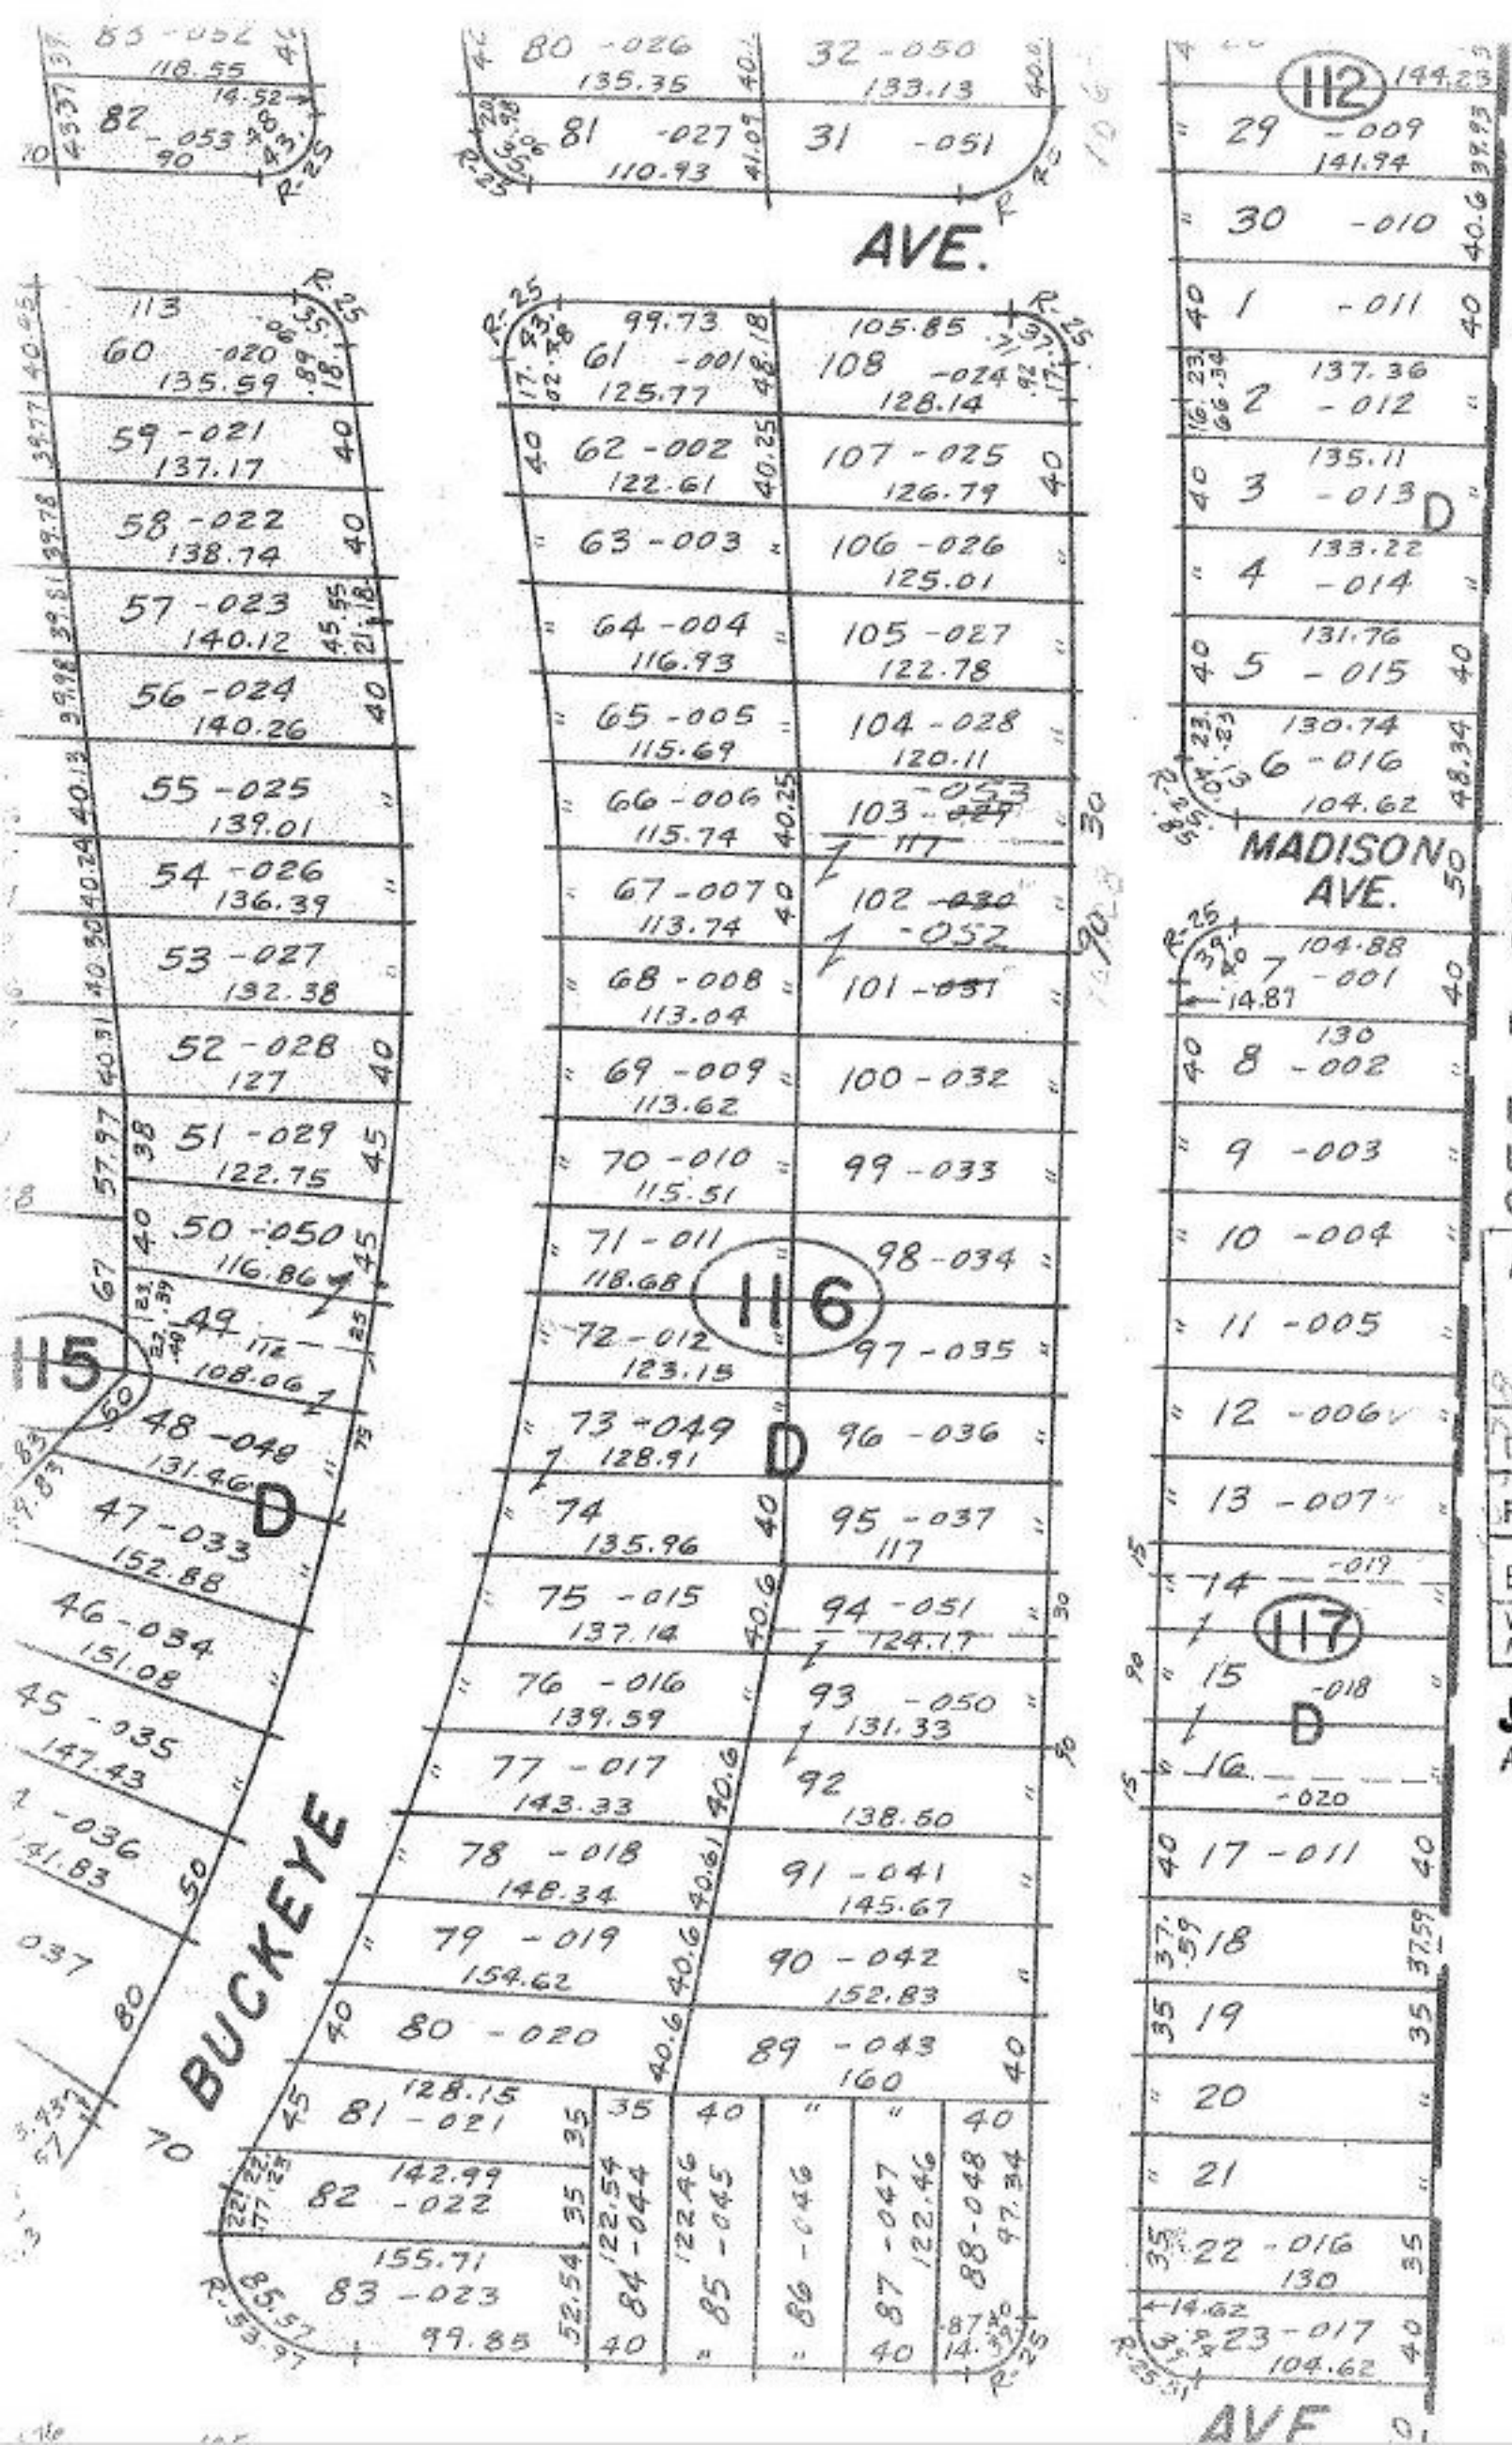

10-78

10728

SEE 3-00-034-B

#10728

APPROVED
LORAIN CO.
MAP DEPT.

DATE 7-13-77

PAGE 3-00-035

BY [signature]

VOID AFTER

JUL 13 1977

AUG 10, 1977 J.B.