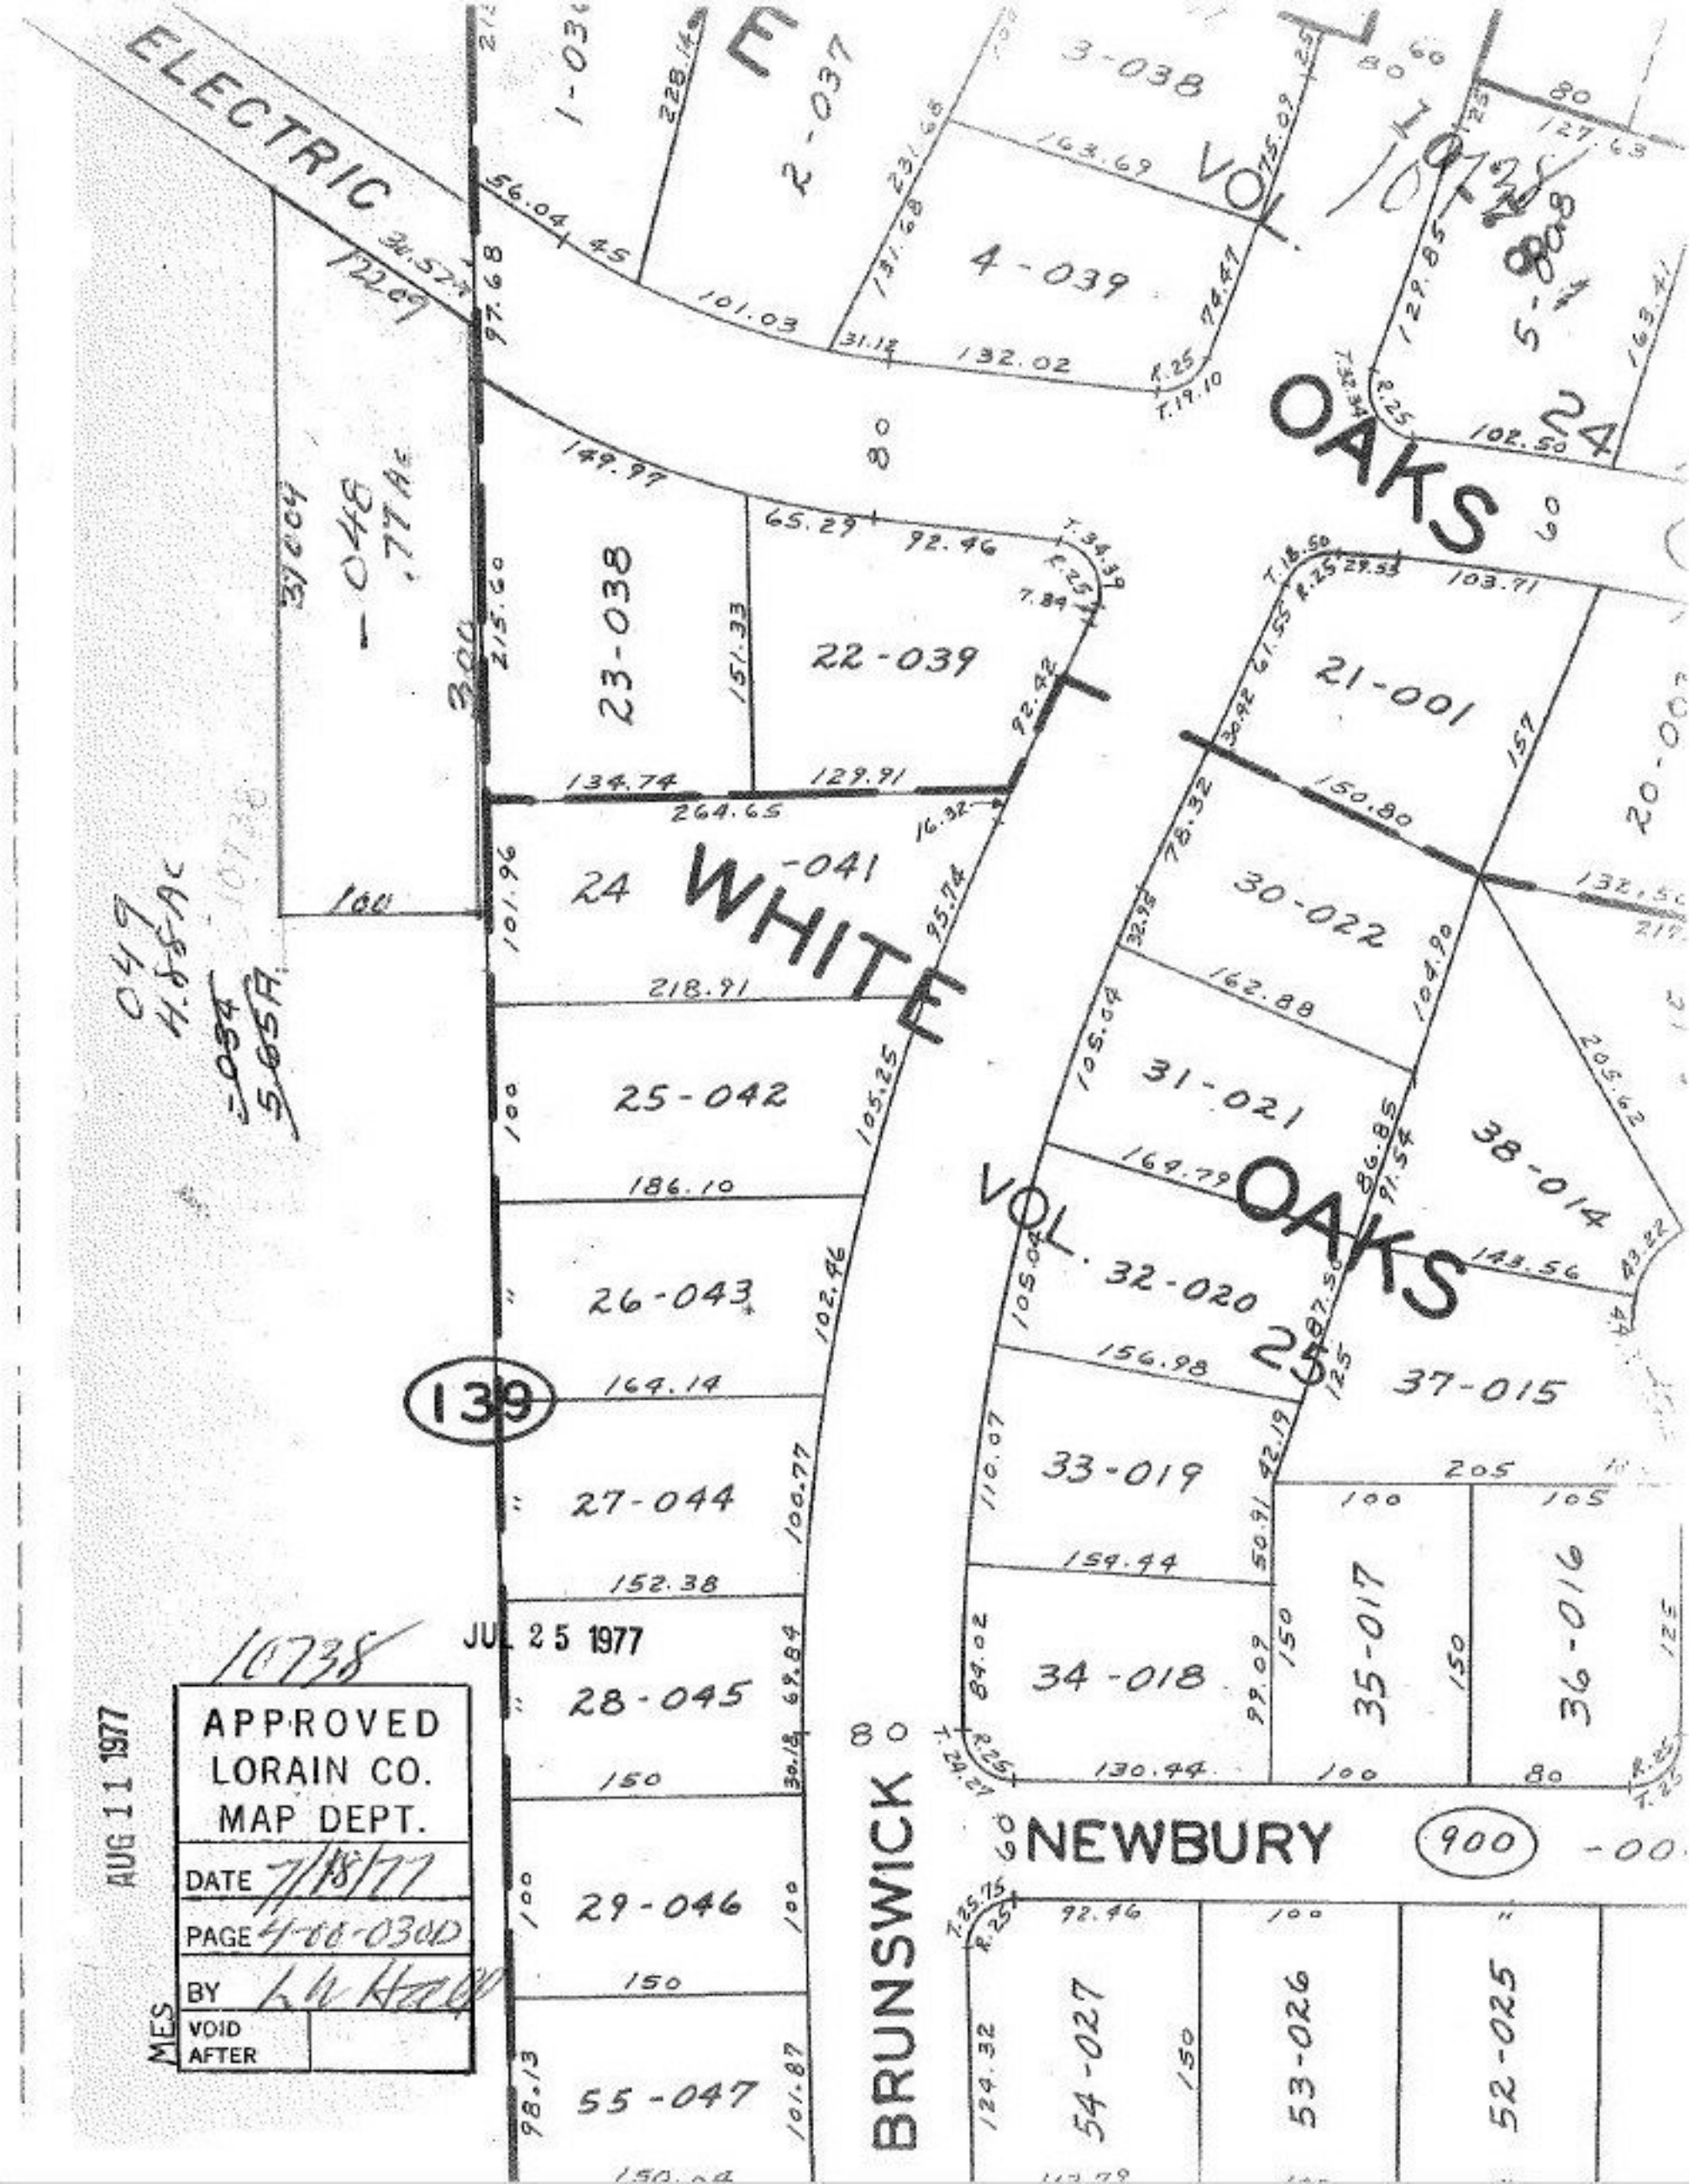
ELECTRIC
WHITE
OAKS
OAKS
NEWBURY
BRUNSWICK
VOL.
VOL.
139
900
-048
.77 Ac
-041
24
25
1-036
2-037
3-038
4-039
5-008
23-038
22-039
21-001
30-022
31-021
38-014
32-020
37-015
33-019
34-018
35-017
36-016
25-042
26-043
27-044
28-045
29-046
55-047
54-027
53-026
52-025
JUL 25 1977
10738
APPROVED
LORAIN CO.
MAP DEPT.
DATE 7/18/77
PAGE 4-00-030D
BY
VOID
AFTER
AUG 11 1977
MES