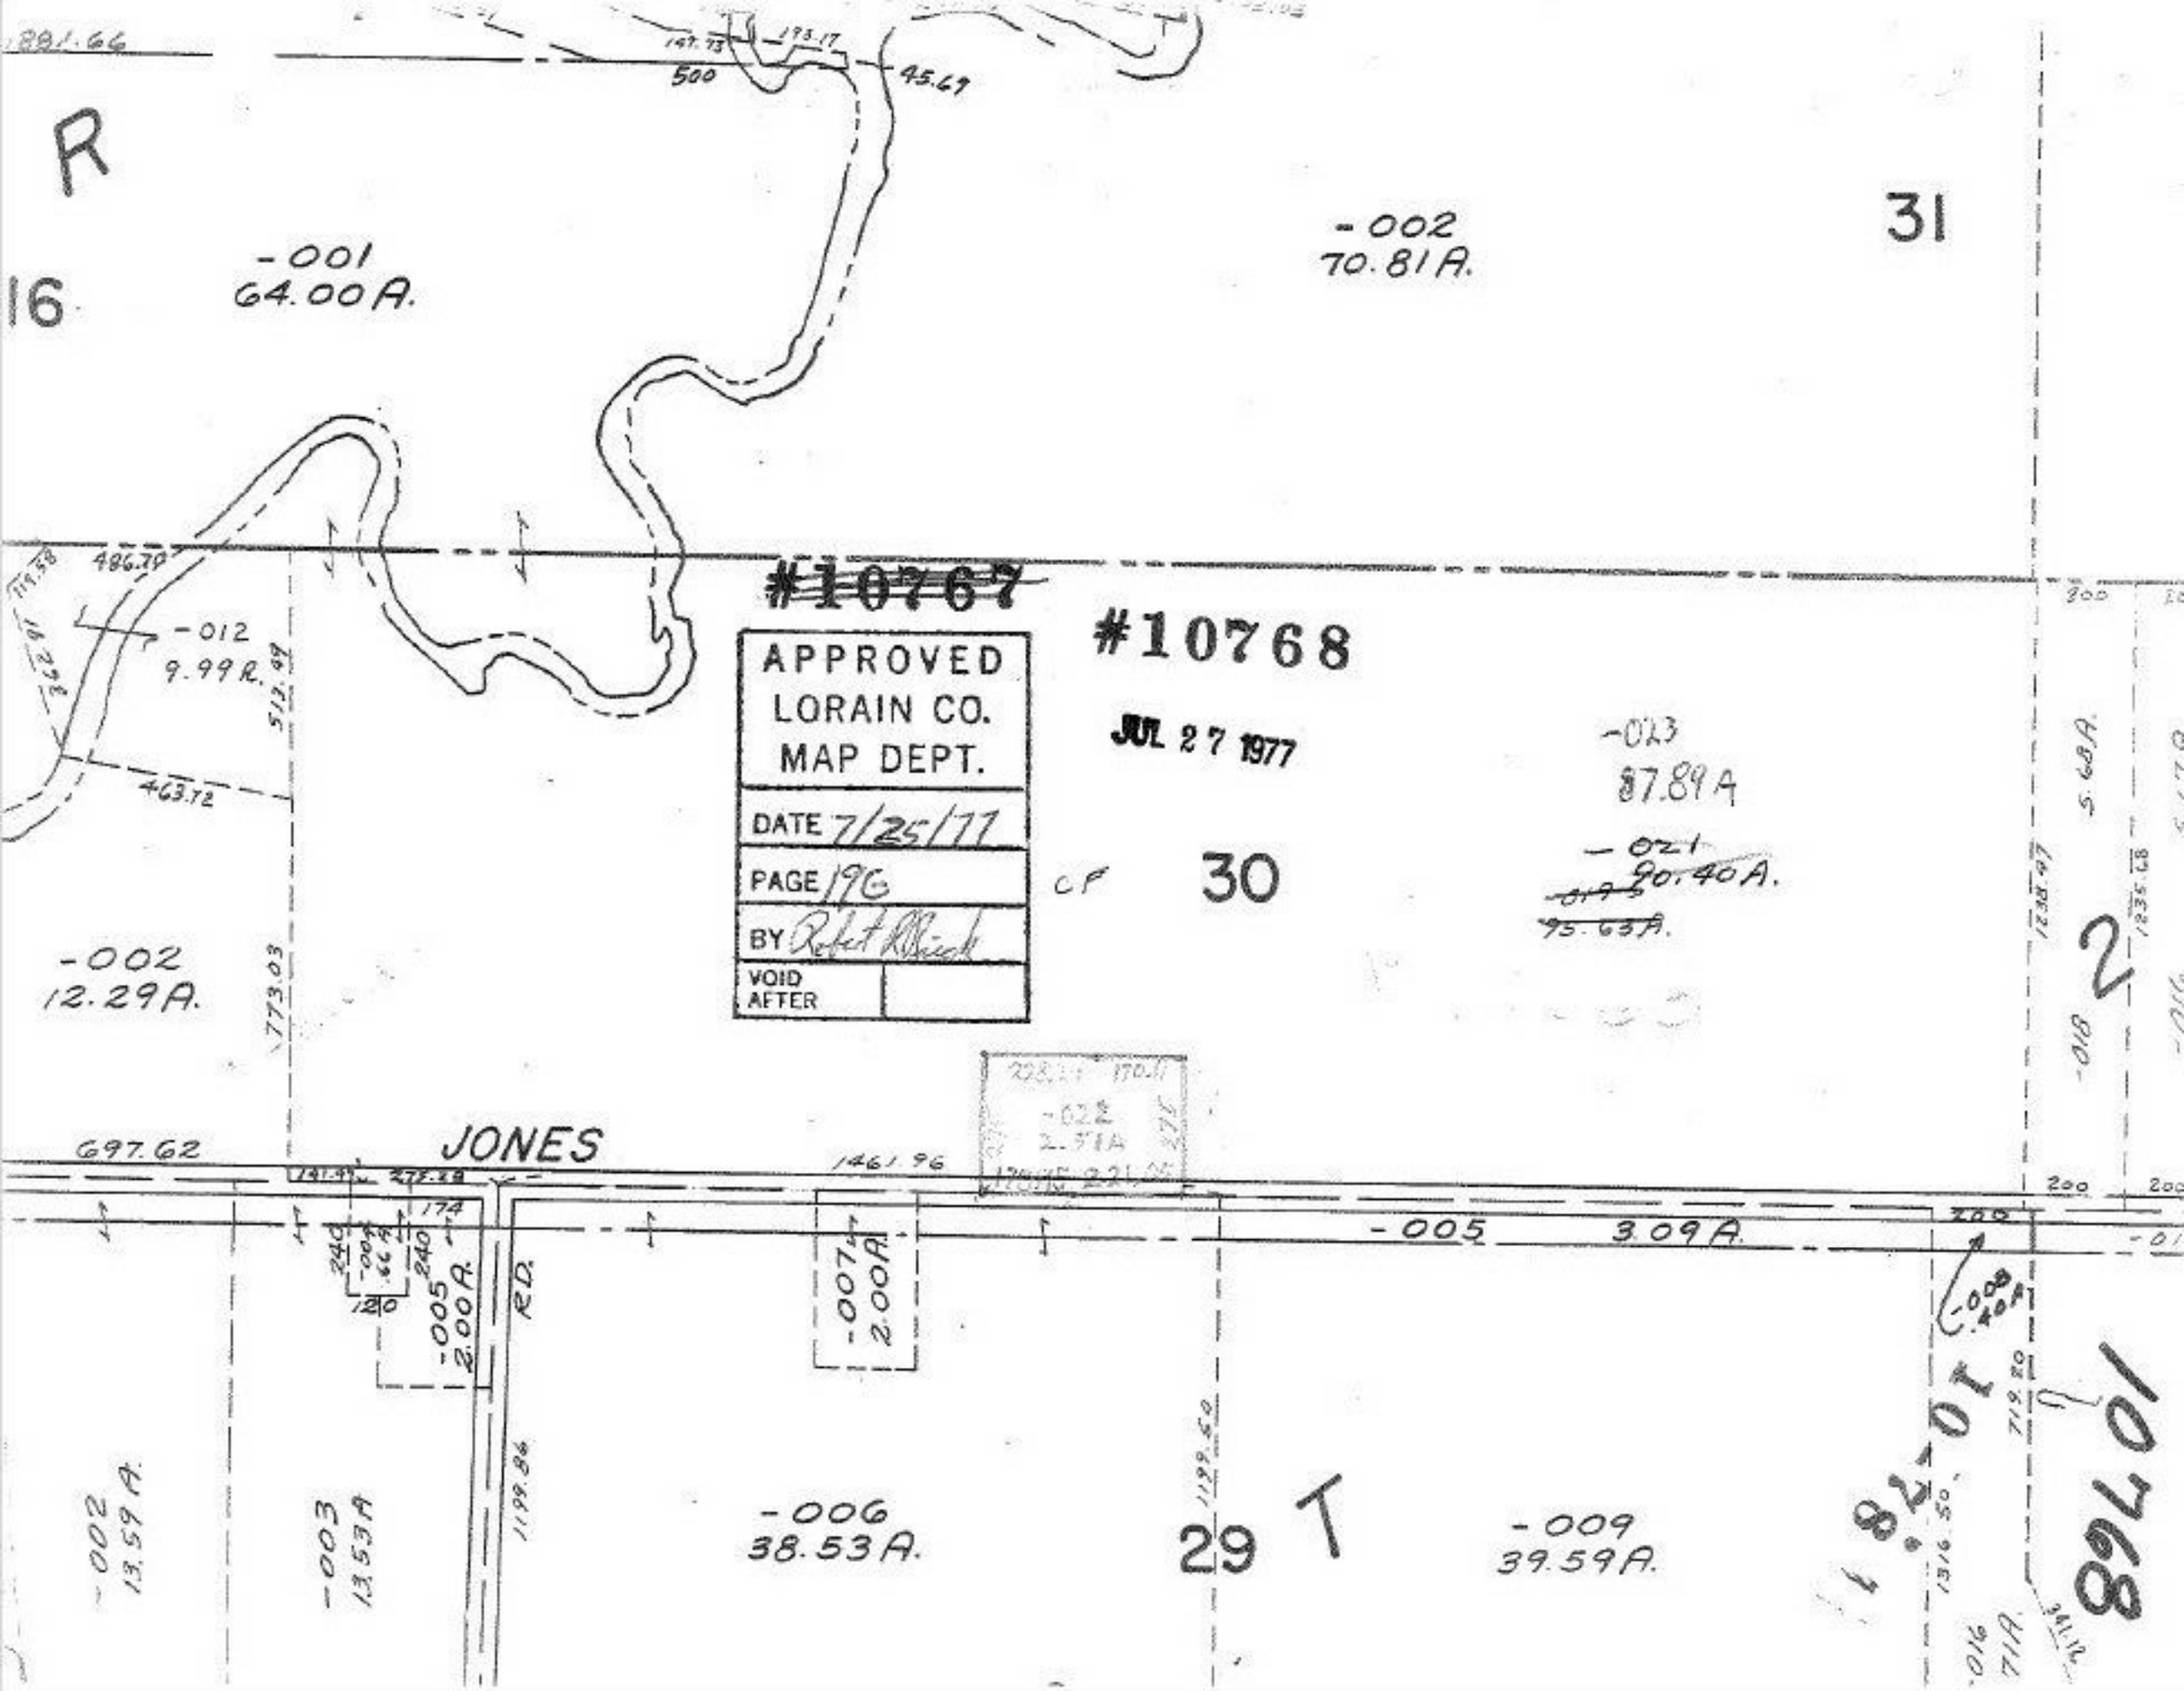

R
16
-001
64.00A.
-002
70.81A.
31
-012
9.99R.
-002
12.29A.
#10767
APPROVED
LORAIN CO.
MAP DEPT.
DATE 7/25/77
PAGE 196
BY Robert R Birch
VOID AFTER
#10768
JUL 27 1977
30
-023
87.89A
-021
90.40A.
95.63A.
JONES
697.62
1461.96
-005
3.09A.
-005
2.00A.
-007
2.00A.
-006
38.53A.
29
T
-009
39.59A.
-002
13.59A.
-003
13.53A
10768