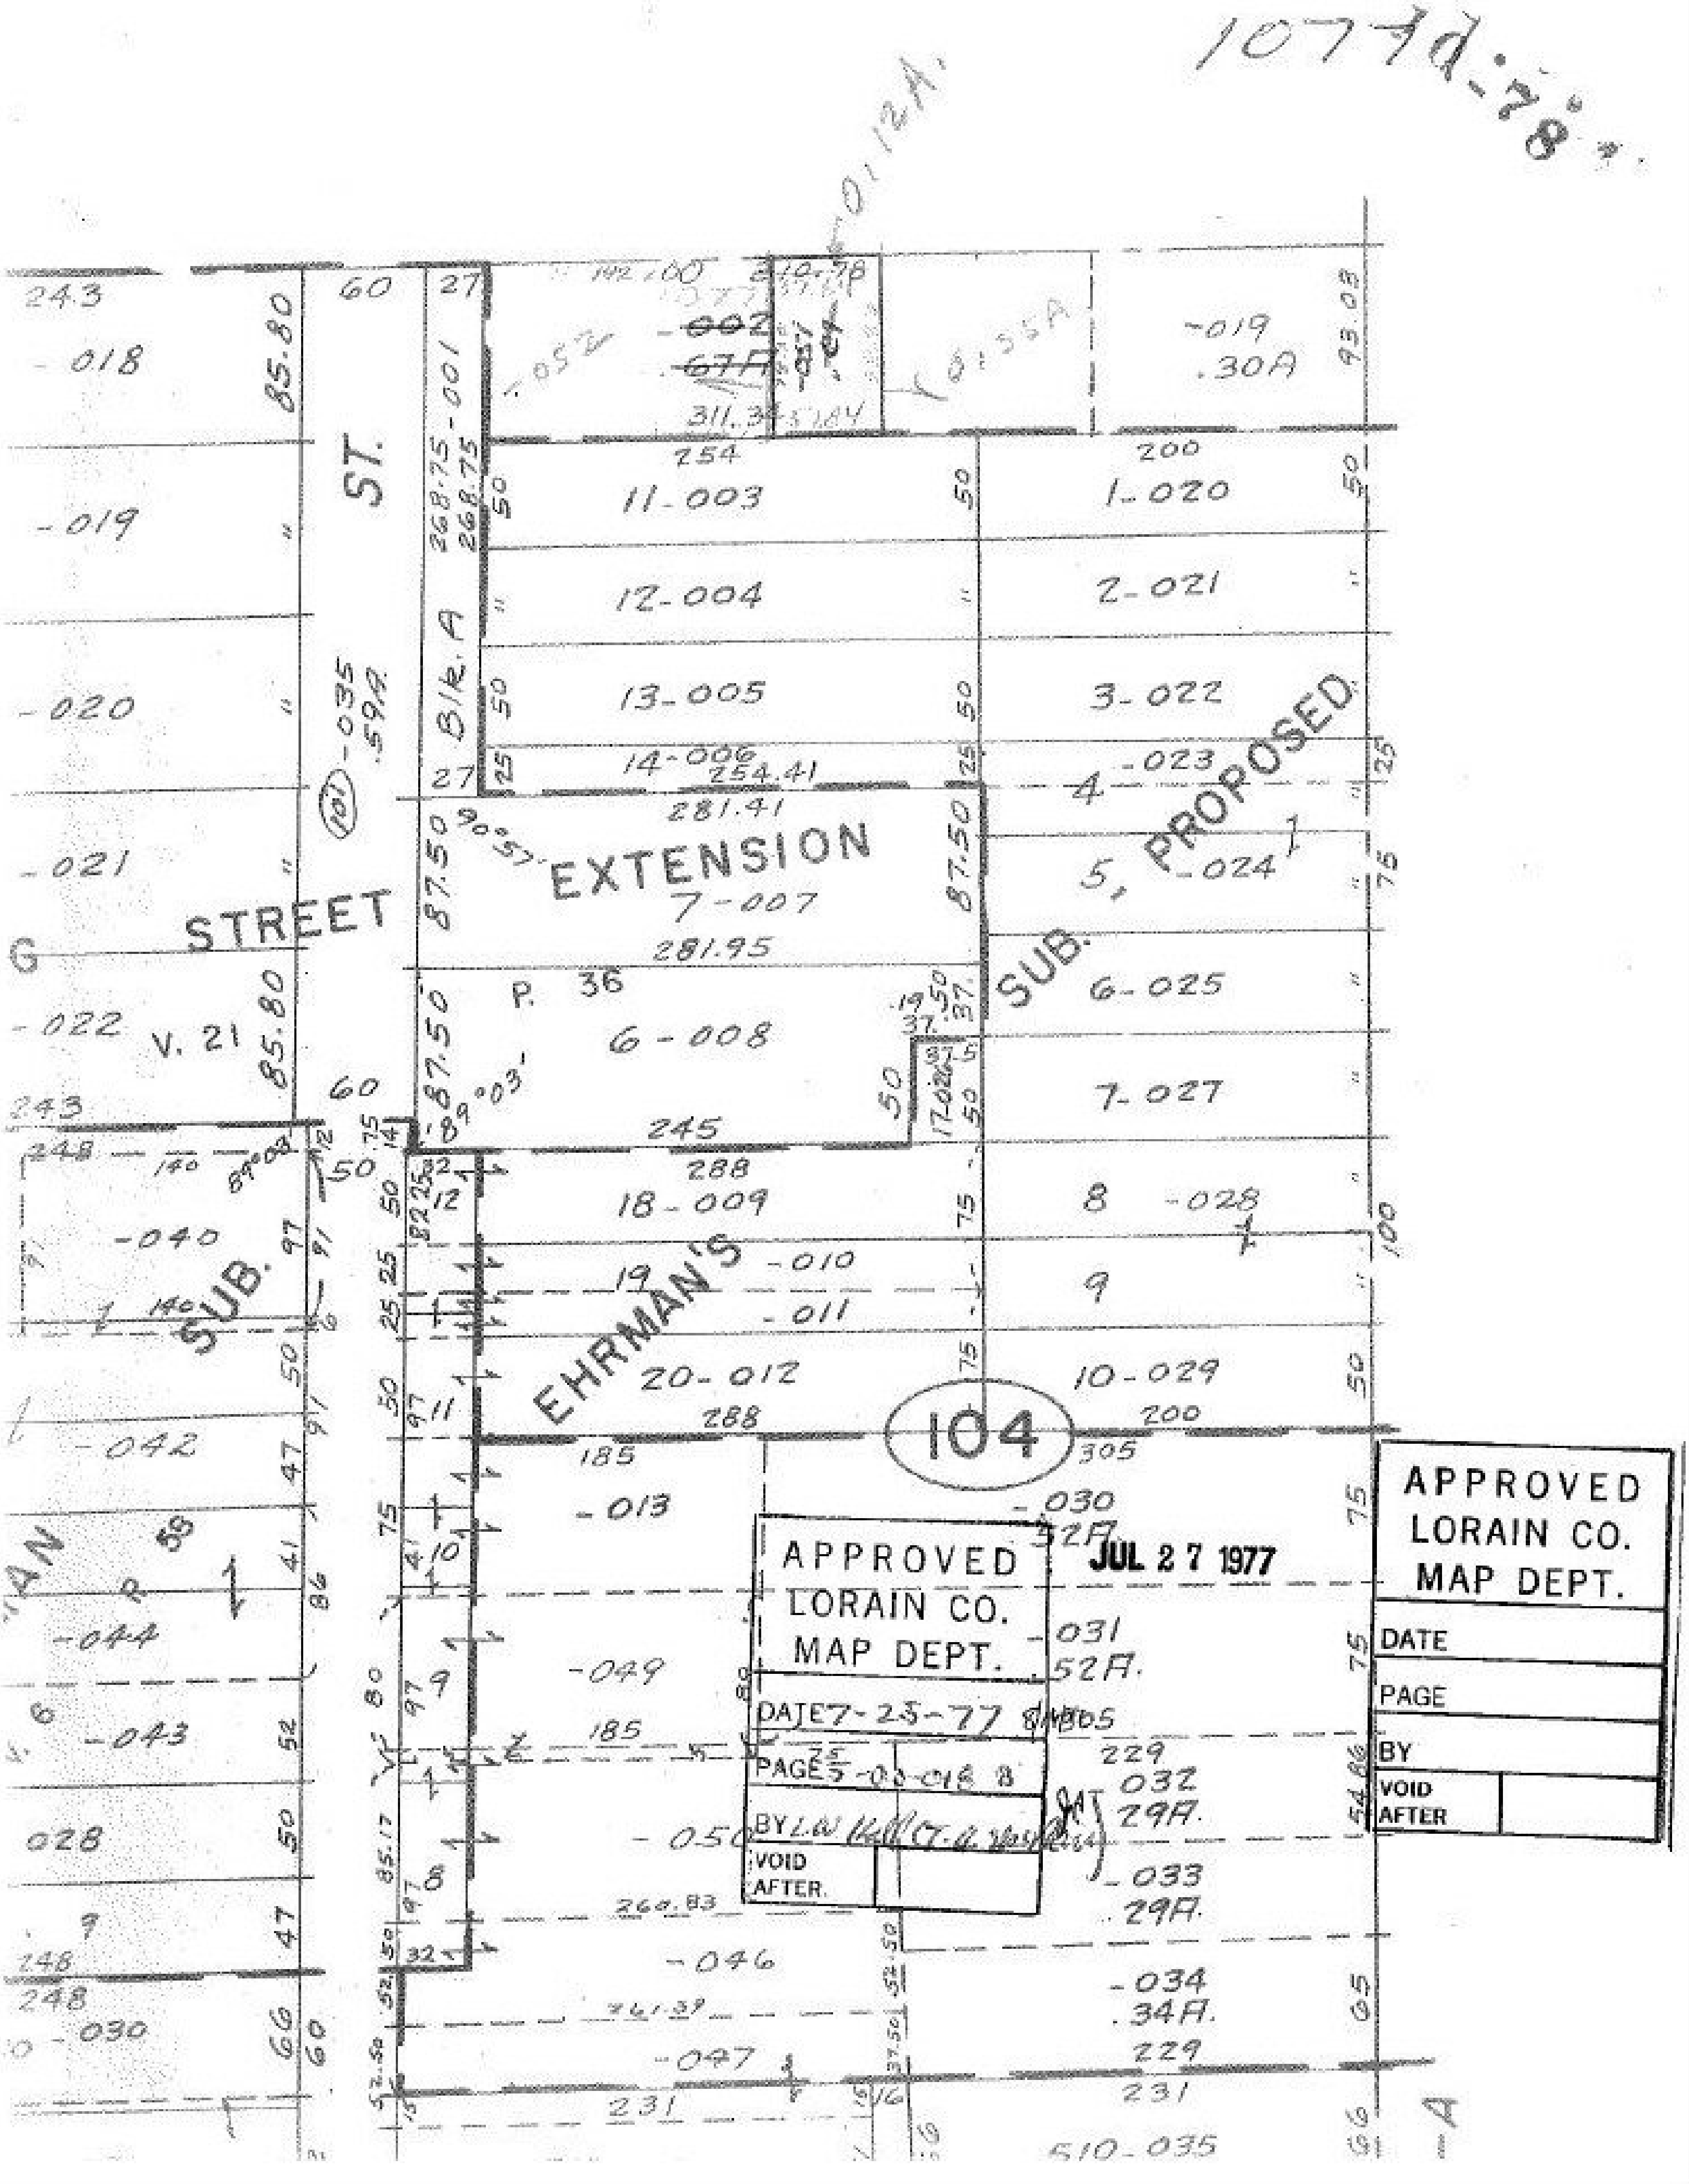
1077d-78
ST.
STREET
G
V. 21
P. 36
BLK. A
EXTENSION
EHRMAN'S
SUB.
SUB. PROPOSED
104
11-003
12-004
13-005
14-006
7-007
6-008
18-009
-010
19
-011
20-012
-013
-049
-050
-046
-047
1-020
2-021
3-022
4-023
5-024
6-025
7-027
8 -028
9
10-029
-019
.30A
-018
-019
-020
-021
-022
-040
-042
-044
-043
-030
.52A
-031
.52A
-032
.29A
-033
.29A
-034
.34A
610-035
APPROVED
LORAIN CO.
MAP DEPT.
DATE 7-25-77
PAGE
BY
VOID
AFTER.
JUL 27 1977
APPROVED
LORAIN CO.
MAP DEPT.
DATE
PAGE
BY
VOID
AFTER