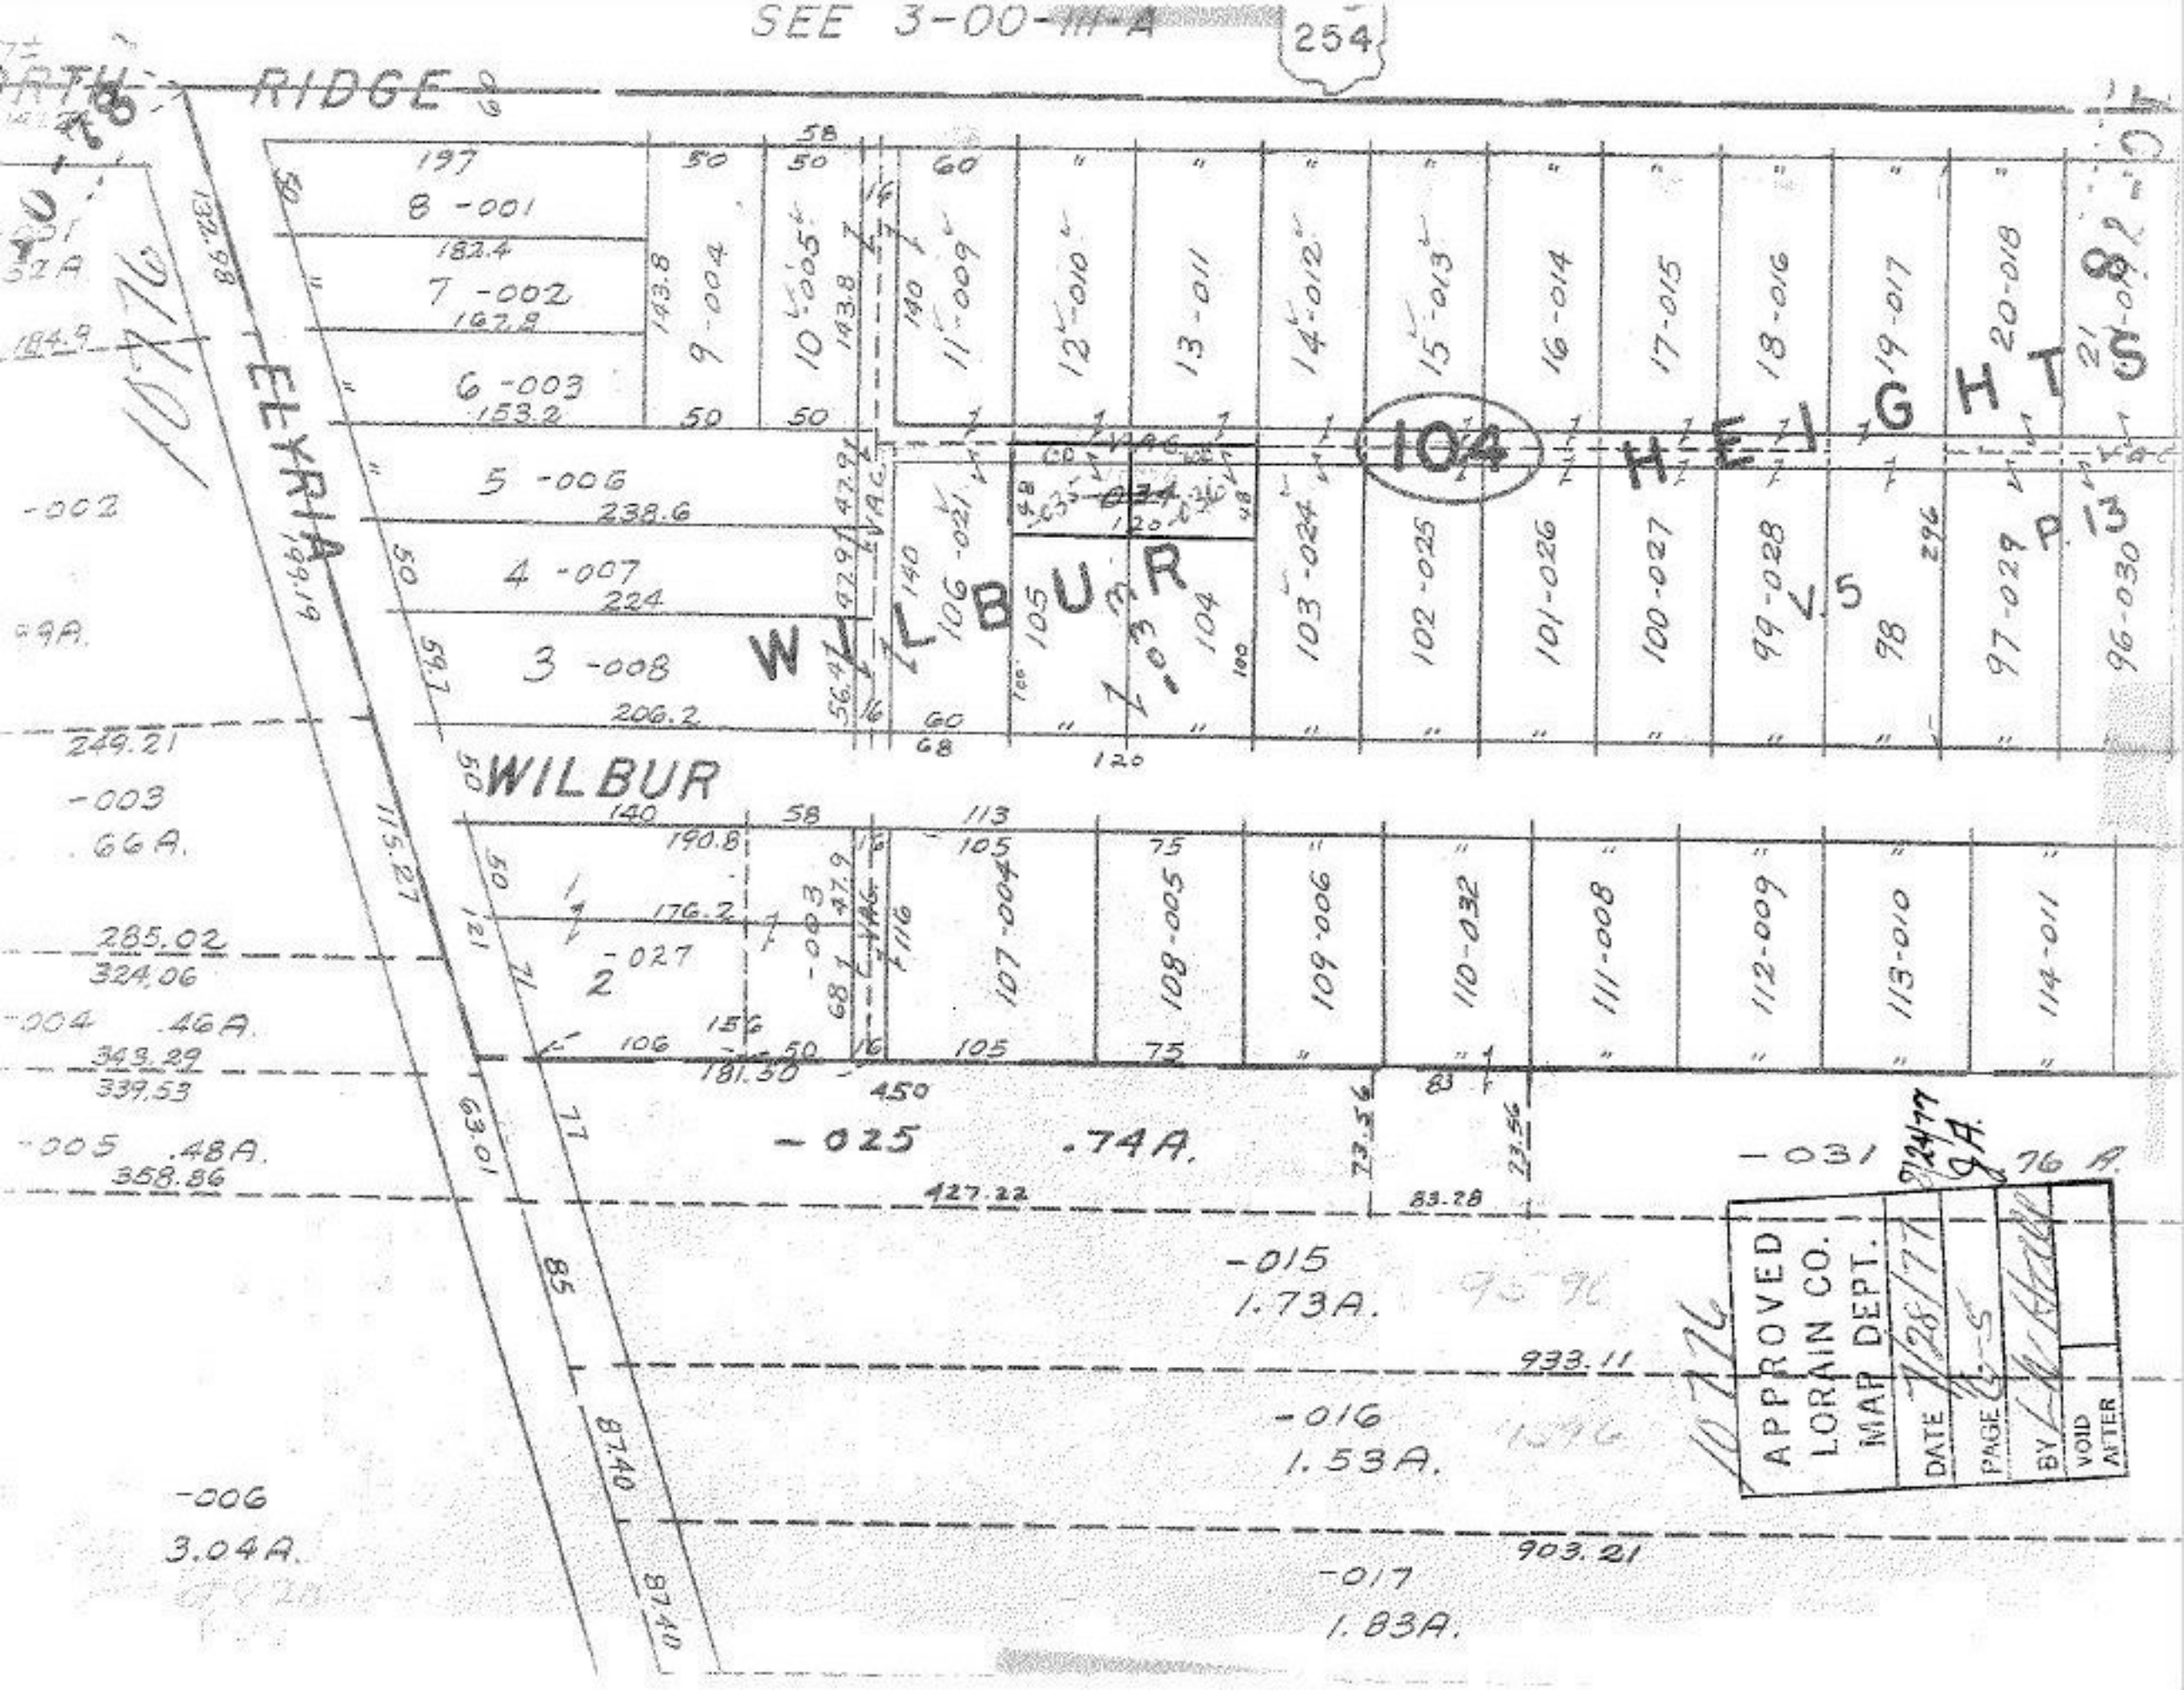
SEE 3-00-111-A
254
RIDGE
ELYRIA
WILBUR
WILBUR
104 HEIGHTS
V.5
P.13
8-001
7-002
6-003
5-006
4-007
3-008
9-004
10-005
11-009
12-010
13-011
14-012
15-013
16-014
17-015
18-016
19-017
20-018
106-021
105
104
103-024
102-025
101-026
100-027
99-028
98
97-029
96-030
107-004
108-005
109-006
110-032
111-008
112-009
113-010
114-011
-002
-003
.66A.
-004 .46A.
-005 .48A.
-006
3.04A.
-025 .74A.
-031 .76 A.
-015
1.73A.
-016
1.53A.
-017
1.83A.
-027
249.21
285.02
324.06
343.29
339.53
358.86
933.11
903.21
APPROVED
LORAIN CO.
MAP DEPT.
DATE
PAGE
BY
VOID AFTER