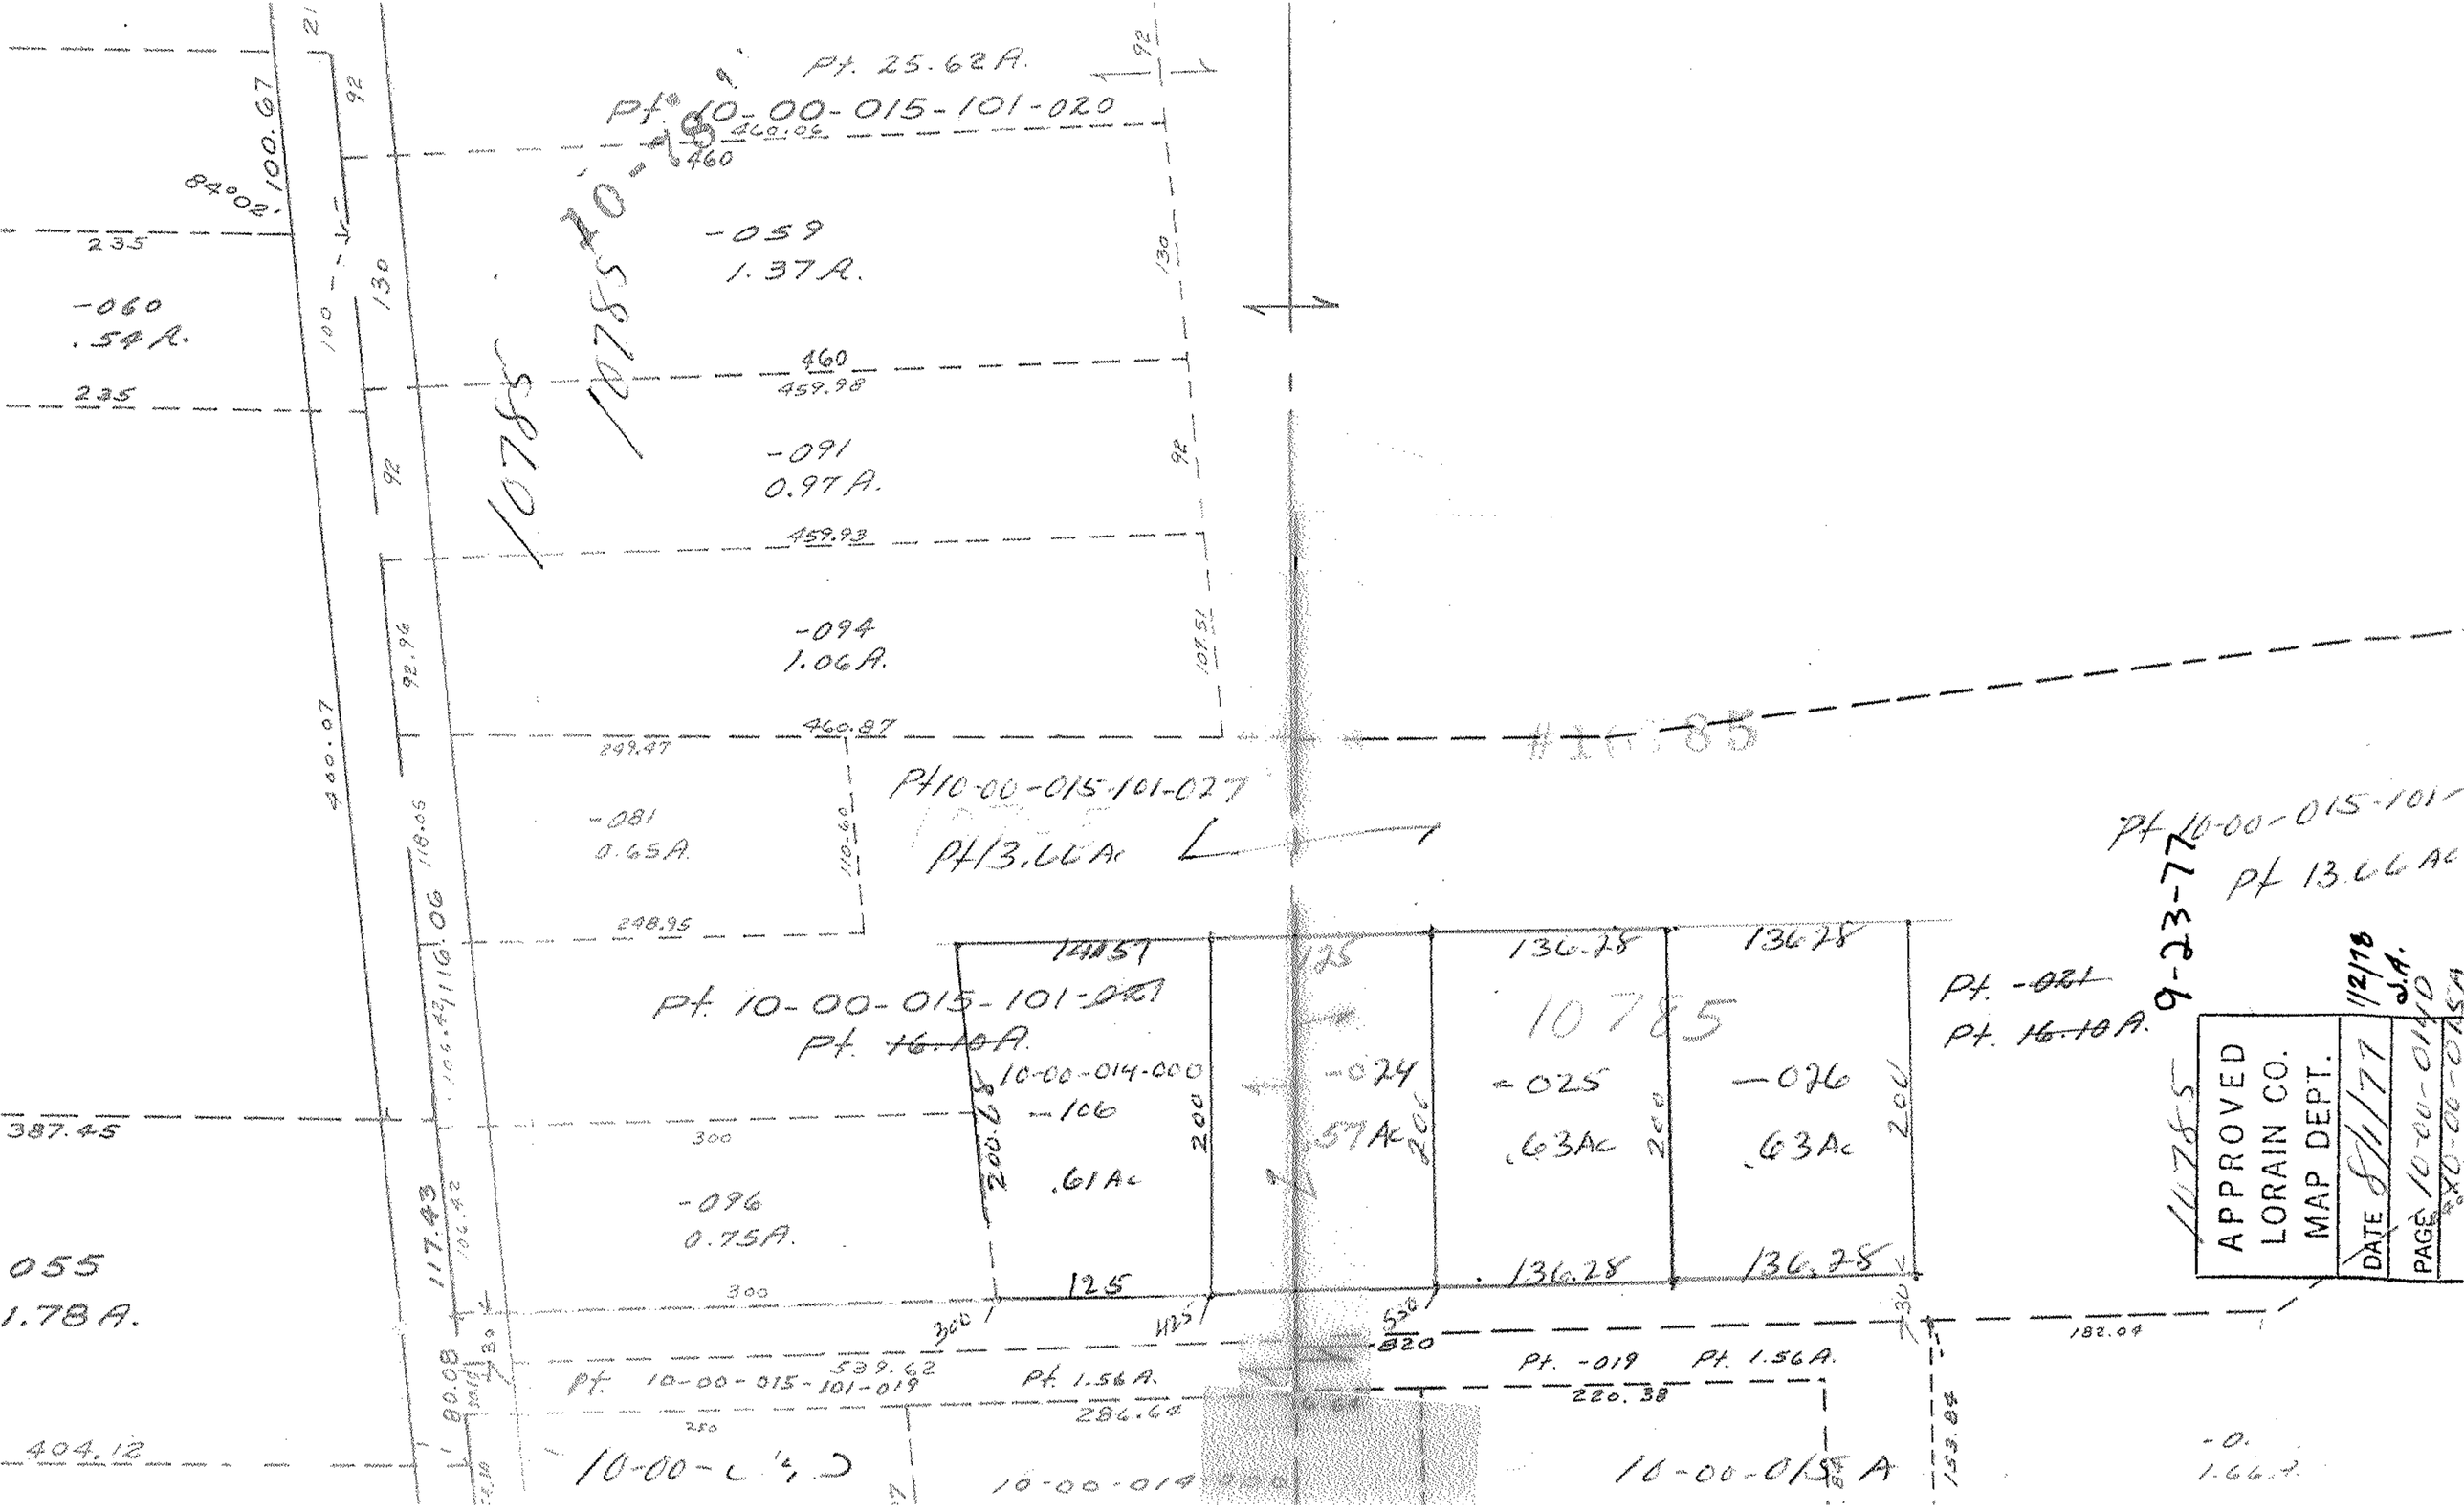

Pt. 25.62 A.
Pt. 10-00-015-101-020
460.06
460
-059
1.37 A.
10785
10785
10785
-060
.54 A.
235
235
460
459.98
-091
0.97 A.
459.93
-094
1.06 A.
460.87
249.47
-081
0.65 A.
248.95
Pt 10-00-015-101-027
Pt 13.66 Ac
Pt. 10-00-015-101-021
Pt. 16.10 A.
10-00-014-000
-106
.61 Ac
125
-024
.57 Ac
136.28
-025
.63 Ac
136.28
-026
.63 Ac
136.28
136.28
Pt. -021
Pt. 16.10 A.
10785
9-23-77
Pt 10-00-015-101-
Pt 13.66 Ac
387.45
300
-096
0.75 A.
300
055
1.78 A.
117.43
Pt. 10-00-015-101-019
539.62
Pt. 1.56 A.
286.64
Pt. -019
Pt. 1.56 A.
220.38
182.04
153.84
404.12
10-00-014
10-00-015 A
-0.
1.66 A.
APPROVED
LORAIN CO.
MAP DEPT.
DATE 8/1/77
PAGE 10-00-014