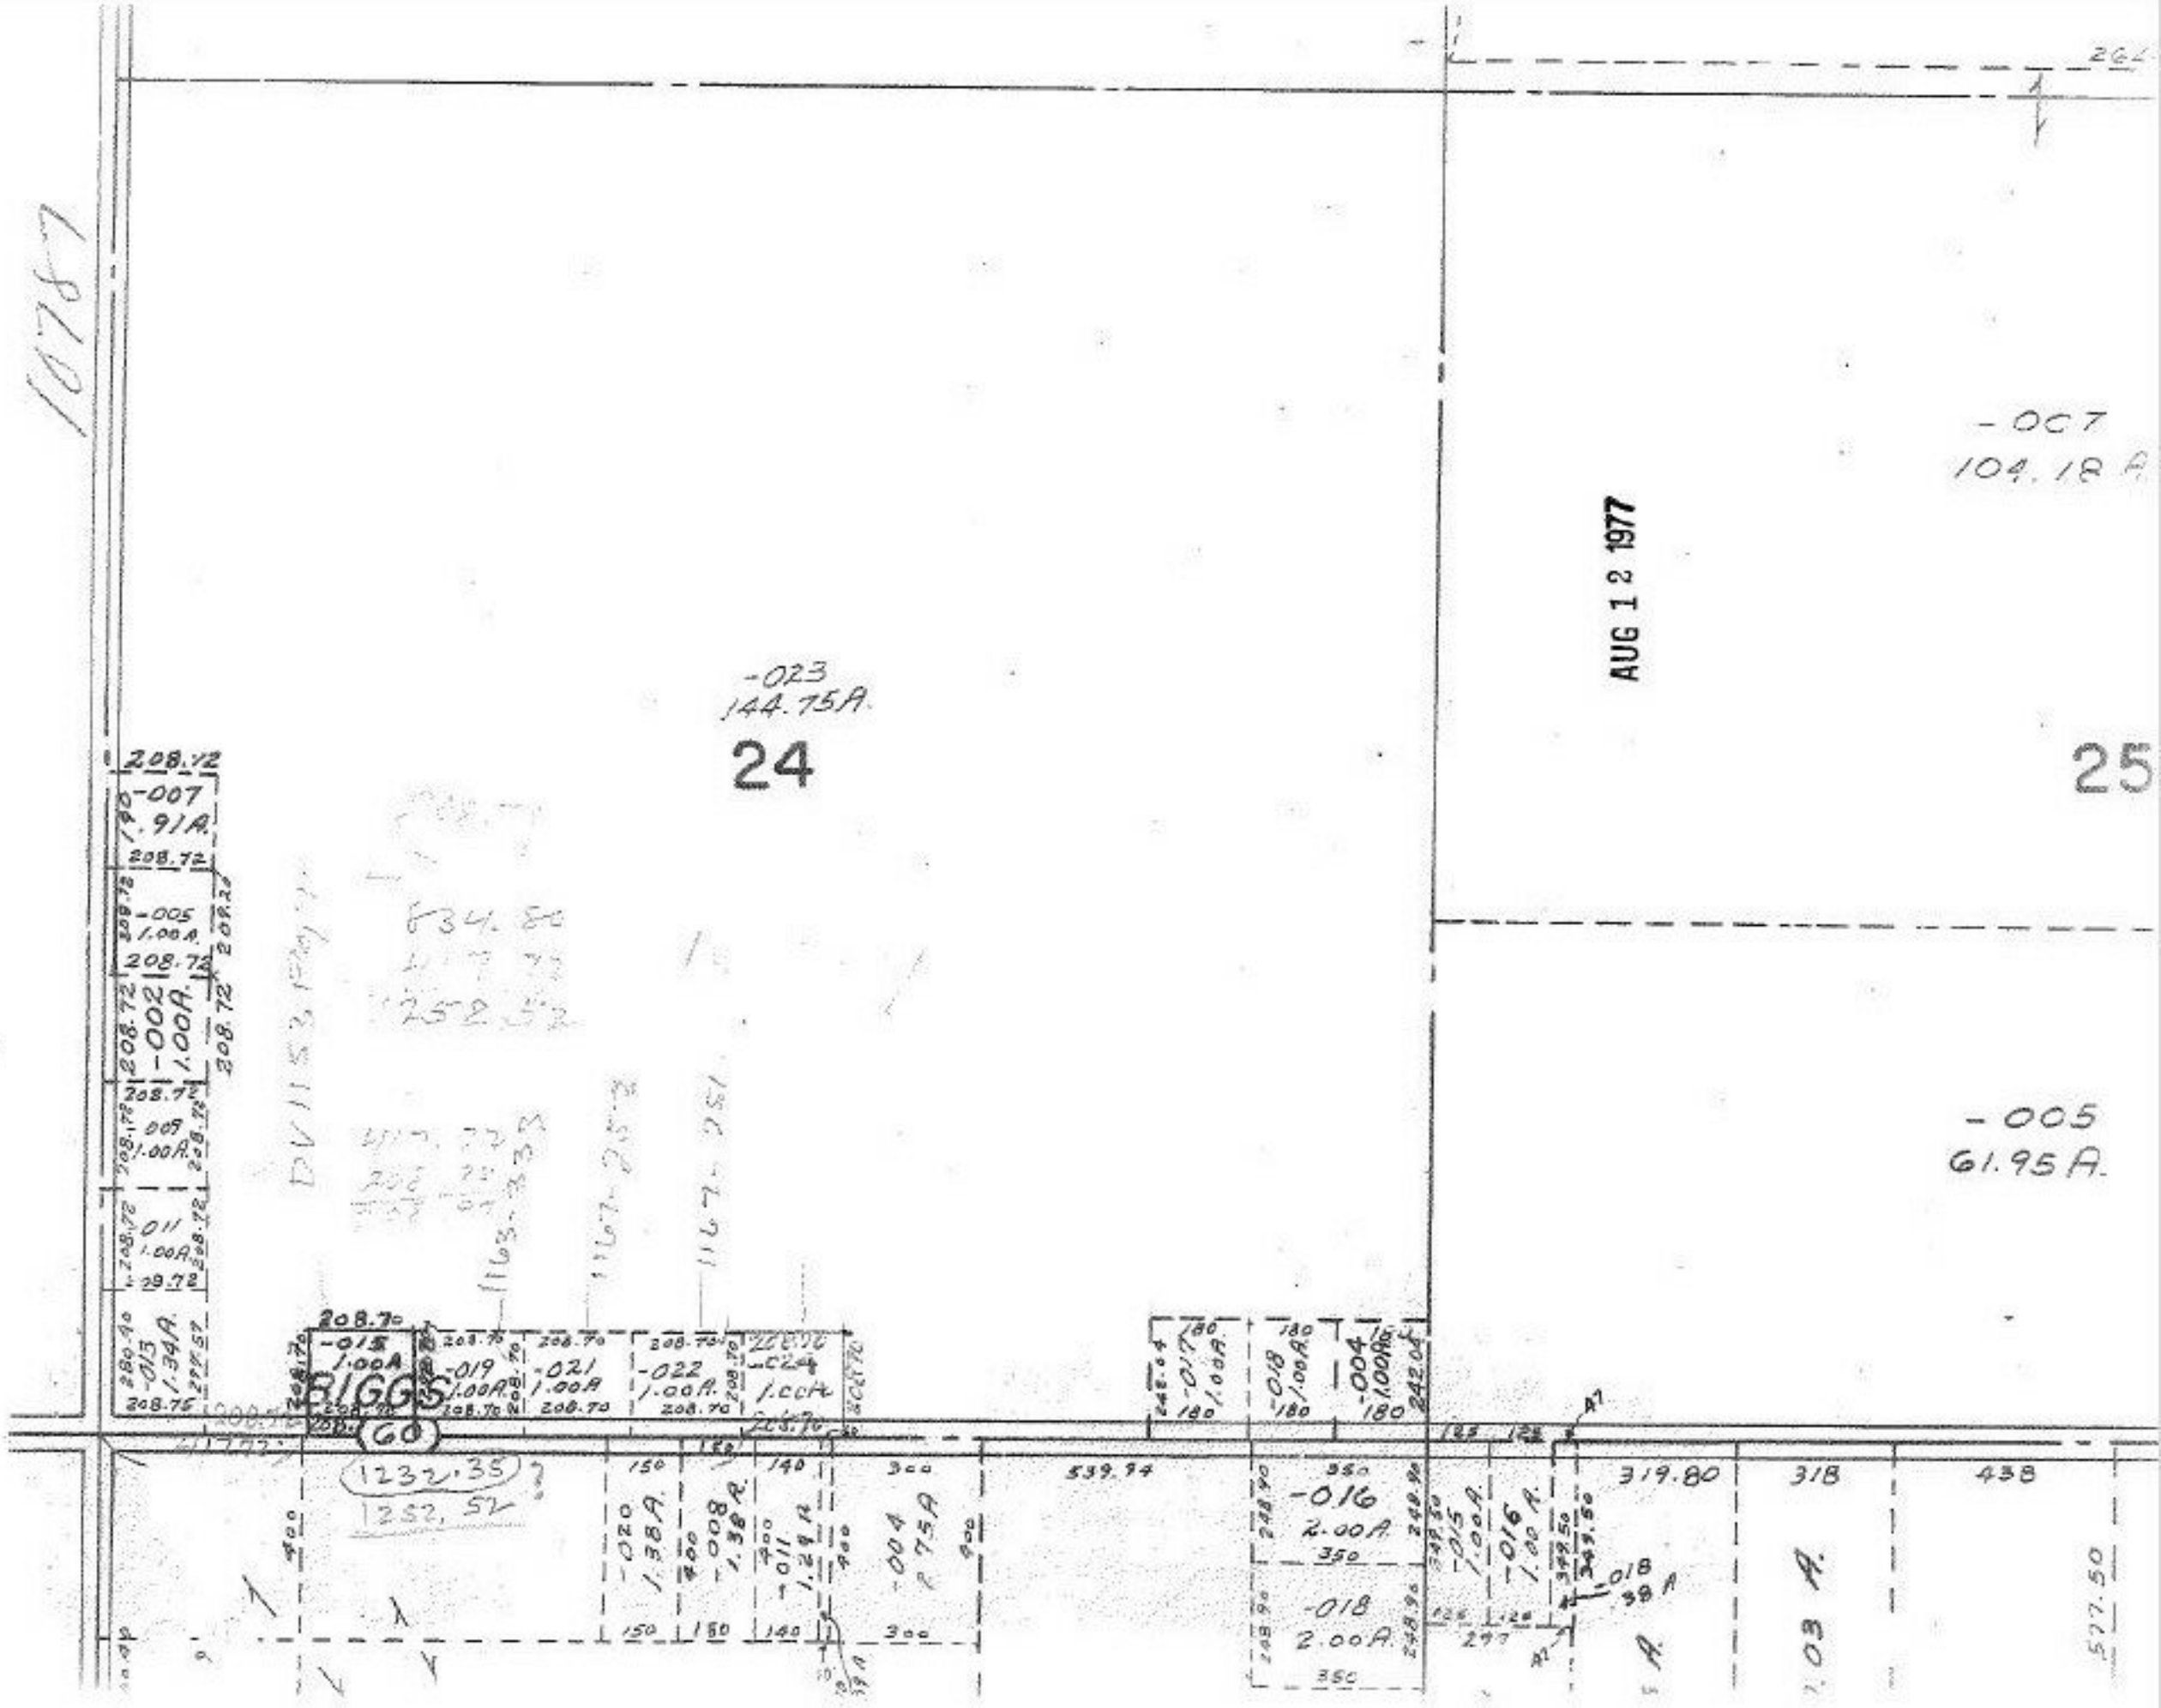

10787
-007
104.18 A
AUG 12 1977
-023
144.75A.
24
25
-005
61.95 A.
BIGGS
(60)
1232.35
1252.52
-015
1.00A
-019
1.00A
-021
1.00A
-022
1.00A
-016
2.00A
-018
2.00A
-018
.38 A
319.80
318
438
539.94
577.50