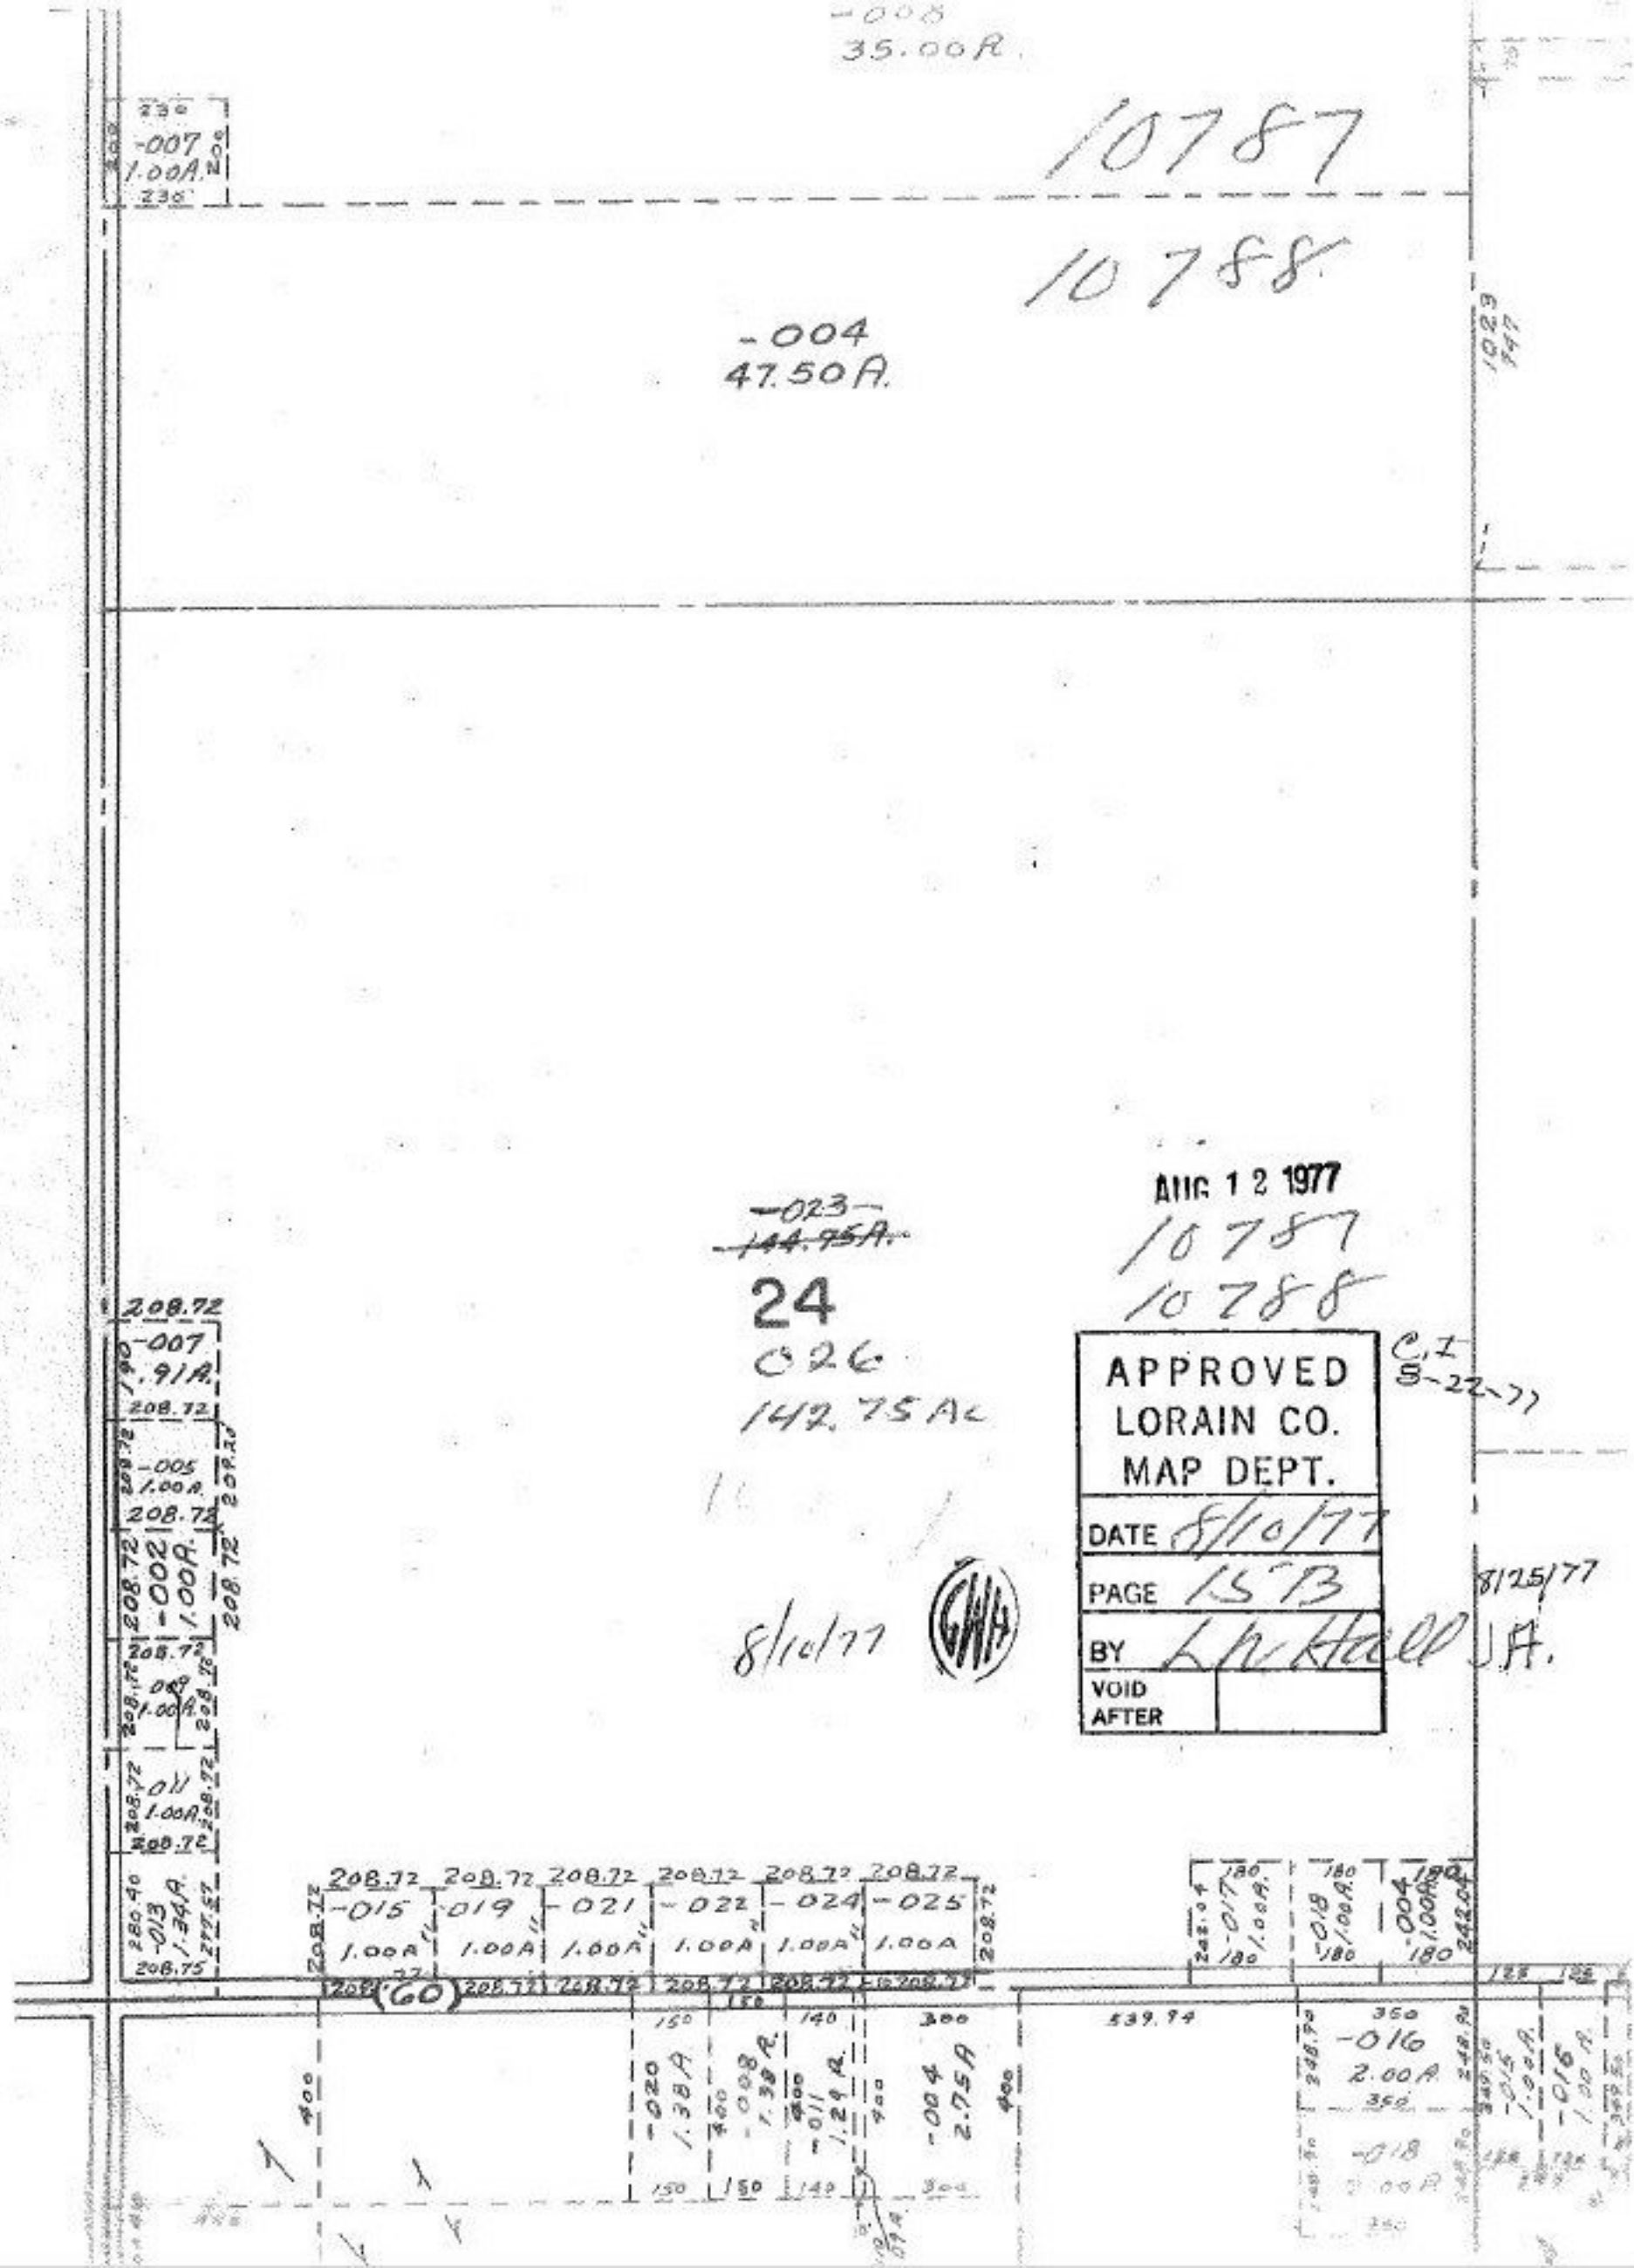
-008
35.00A.
10787
10788
-007
1.00A.
-004
47.50A.
-023
~~144.75A.~~
24
026
142.75 Ac
AUG 12 1977
10787
10788
APPROVED
LORAIN CO.
MAP DEPT.
DATE 8/10/77
PAGE 15B
BY L.H. Hall
VOID AFTER
C.I.
8-22-77
8/10/77
8/25/77
J.A.
-007
.91A.
-005
1.00A.
-002
1.00A.
-011
1.00A.
-013
1.34A.
-015
1.00A
-019
1.00A
-021
1.00A
-022
1.00A
-024
1.00A
-025
1.00A
-017
1.00A.
-018
1.00A.
-004
1.00A.
-020
1.38A
-008
1.38A.
-011
1.29A.
-004
2.75A
-016
2.00A.
-018
2.00A
-015
1.00A.
-016
1.00A.
(60)
539.94
208.72
208.75
1023
947