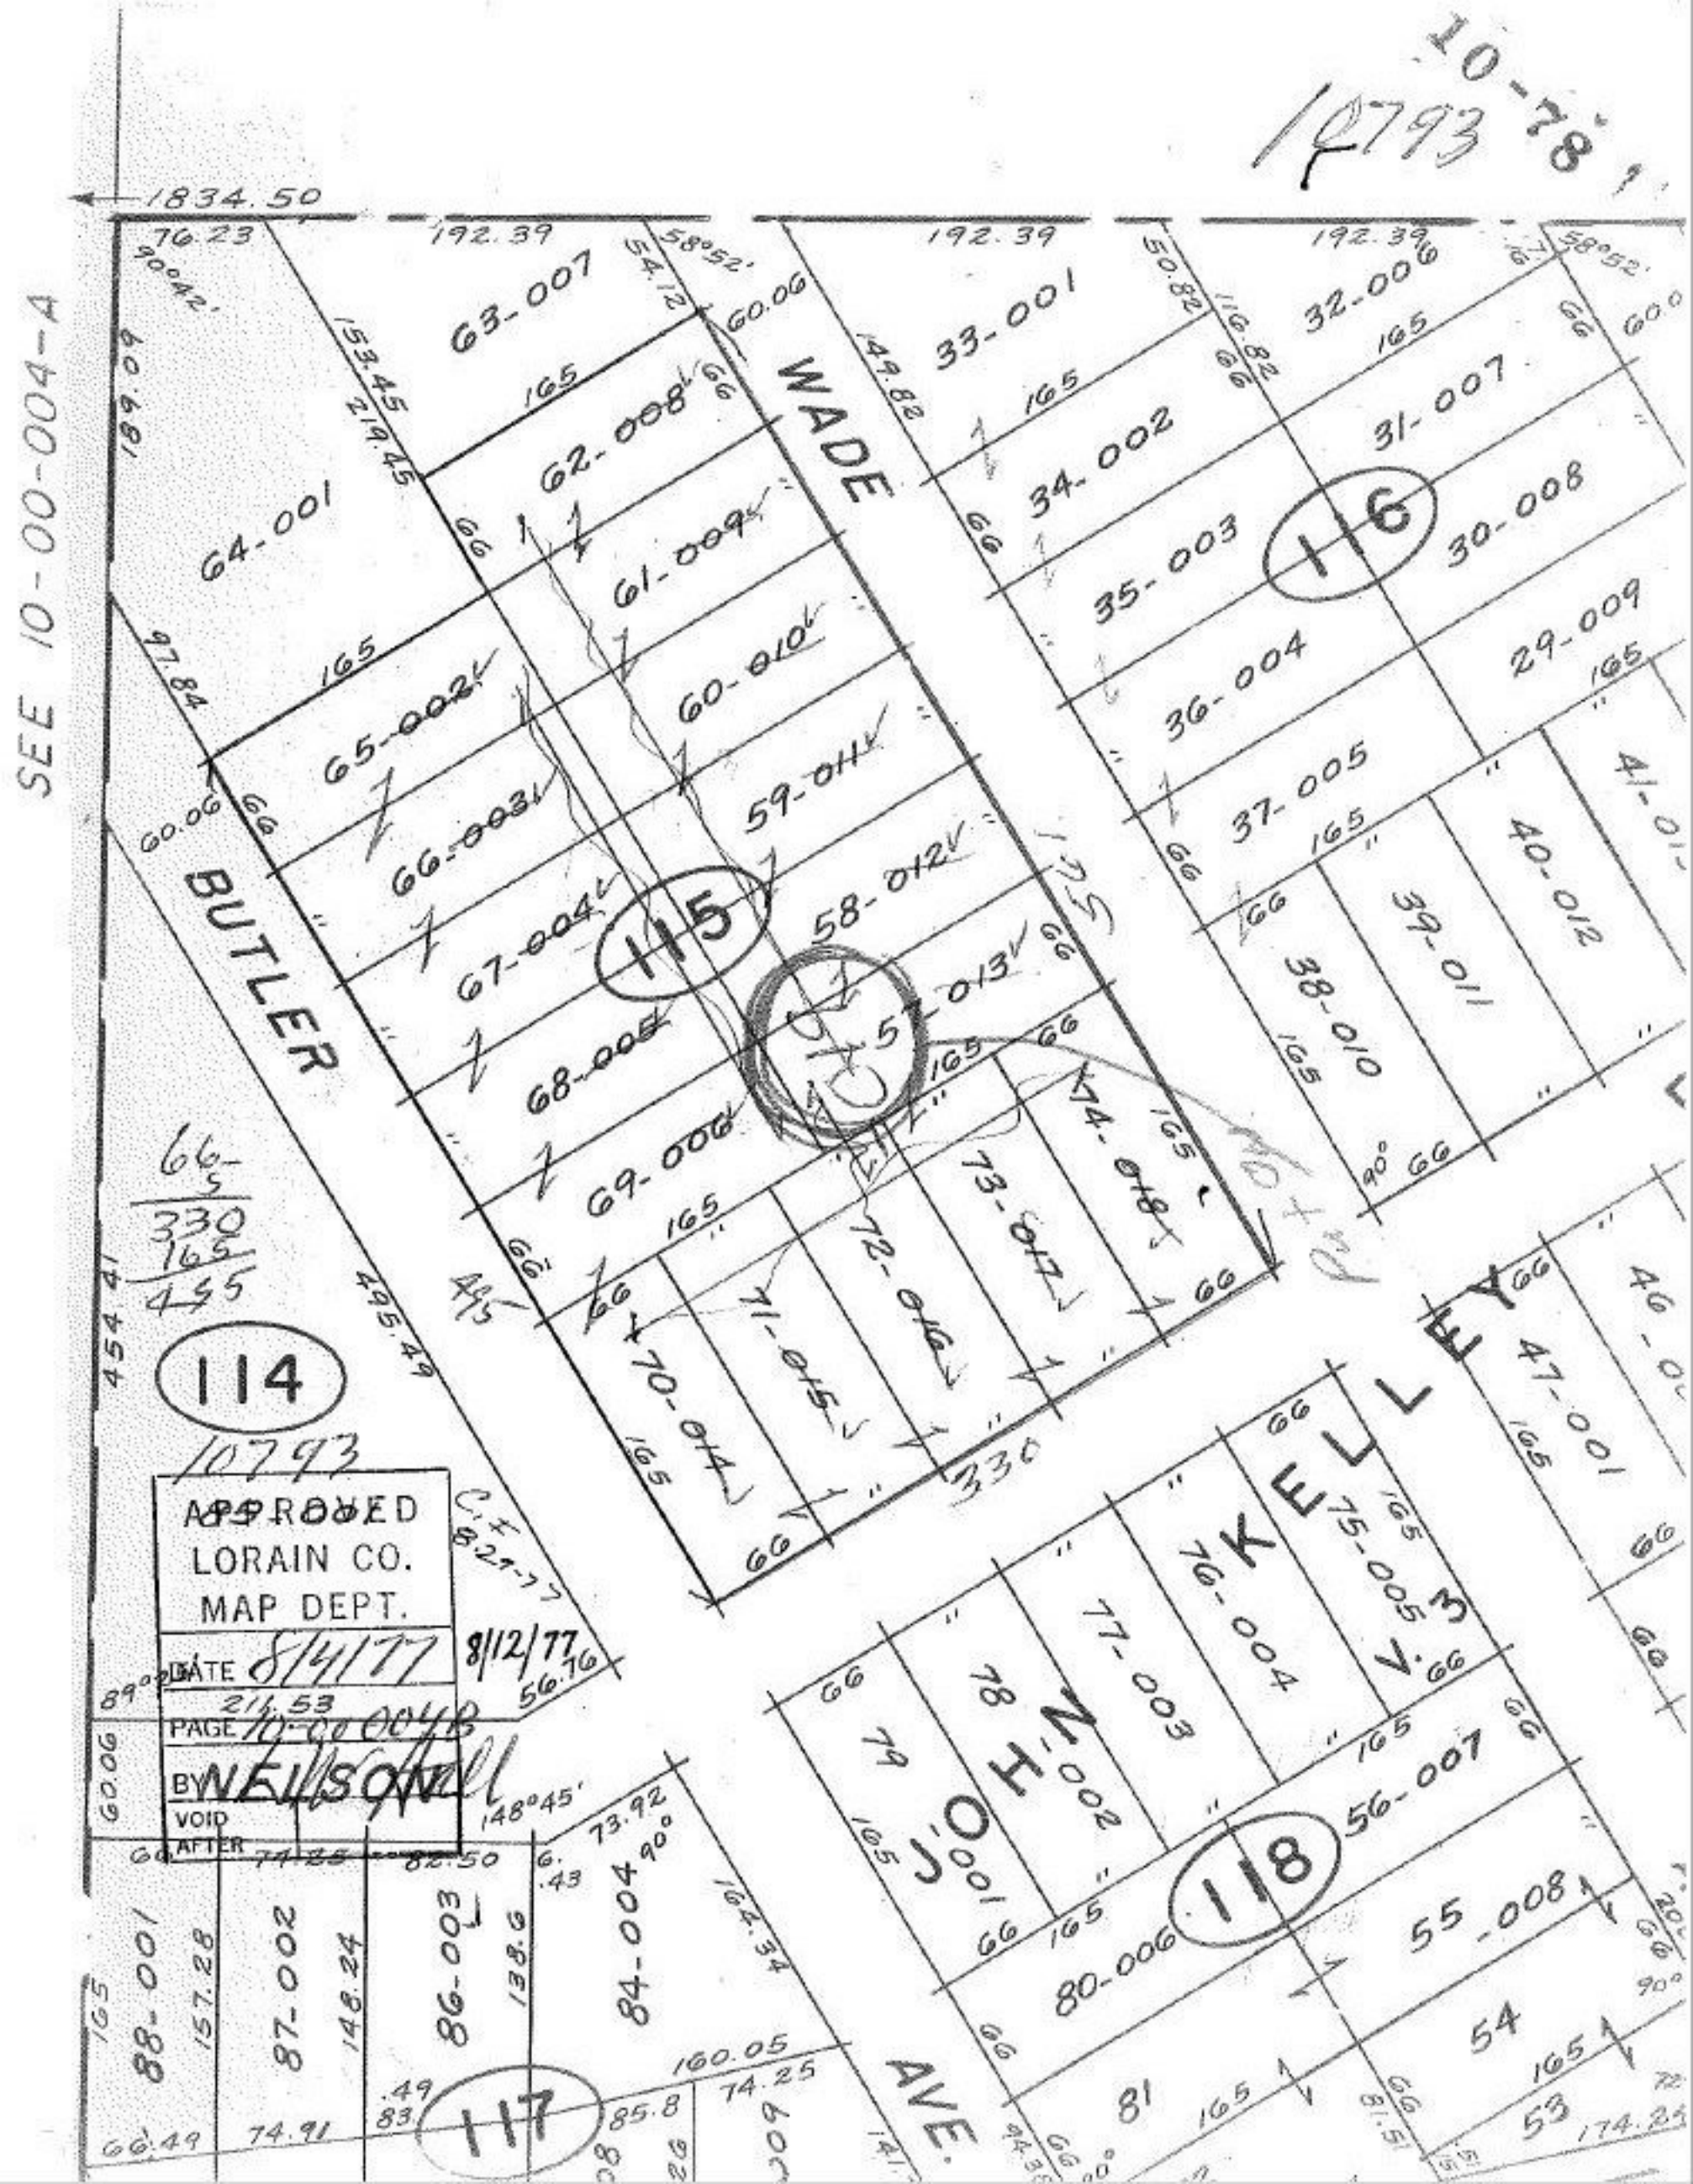
10-78
10793
1834.50
SEE 10-00-004-A
WADE
BUTLER
KELLEY
JOHN
AVE.
114
115
116
117
118
10793
APPROVED
LORAIN CO.
MAP DEPT.
DATE 8/4/77
8/12/77
PAGE 10-00-004B
BY NELSON
VOID
AFTER
63-007
62-008
61-009
60-010
59-011
58-012
57-013
64-001
65-002
66-003
67-004
68-005
69-006
70-014
71-015
72-016
73-017
74-018
33-001
34-002
35-003
36-004
37-005
38-010
39-011
40-012
32-006
31-007
30-008
29-009
47-001
75-005
76-004
77-003
78-002
79-001
80-006
56-007
55-008
54
53
81
88-001
87-002
86-003
84-004
66-
5
330
165
455