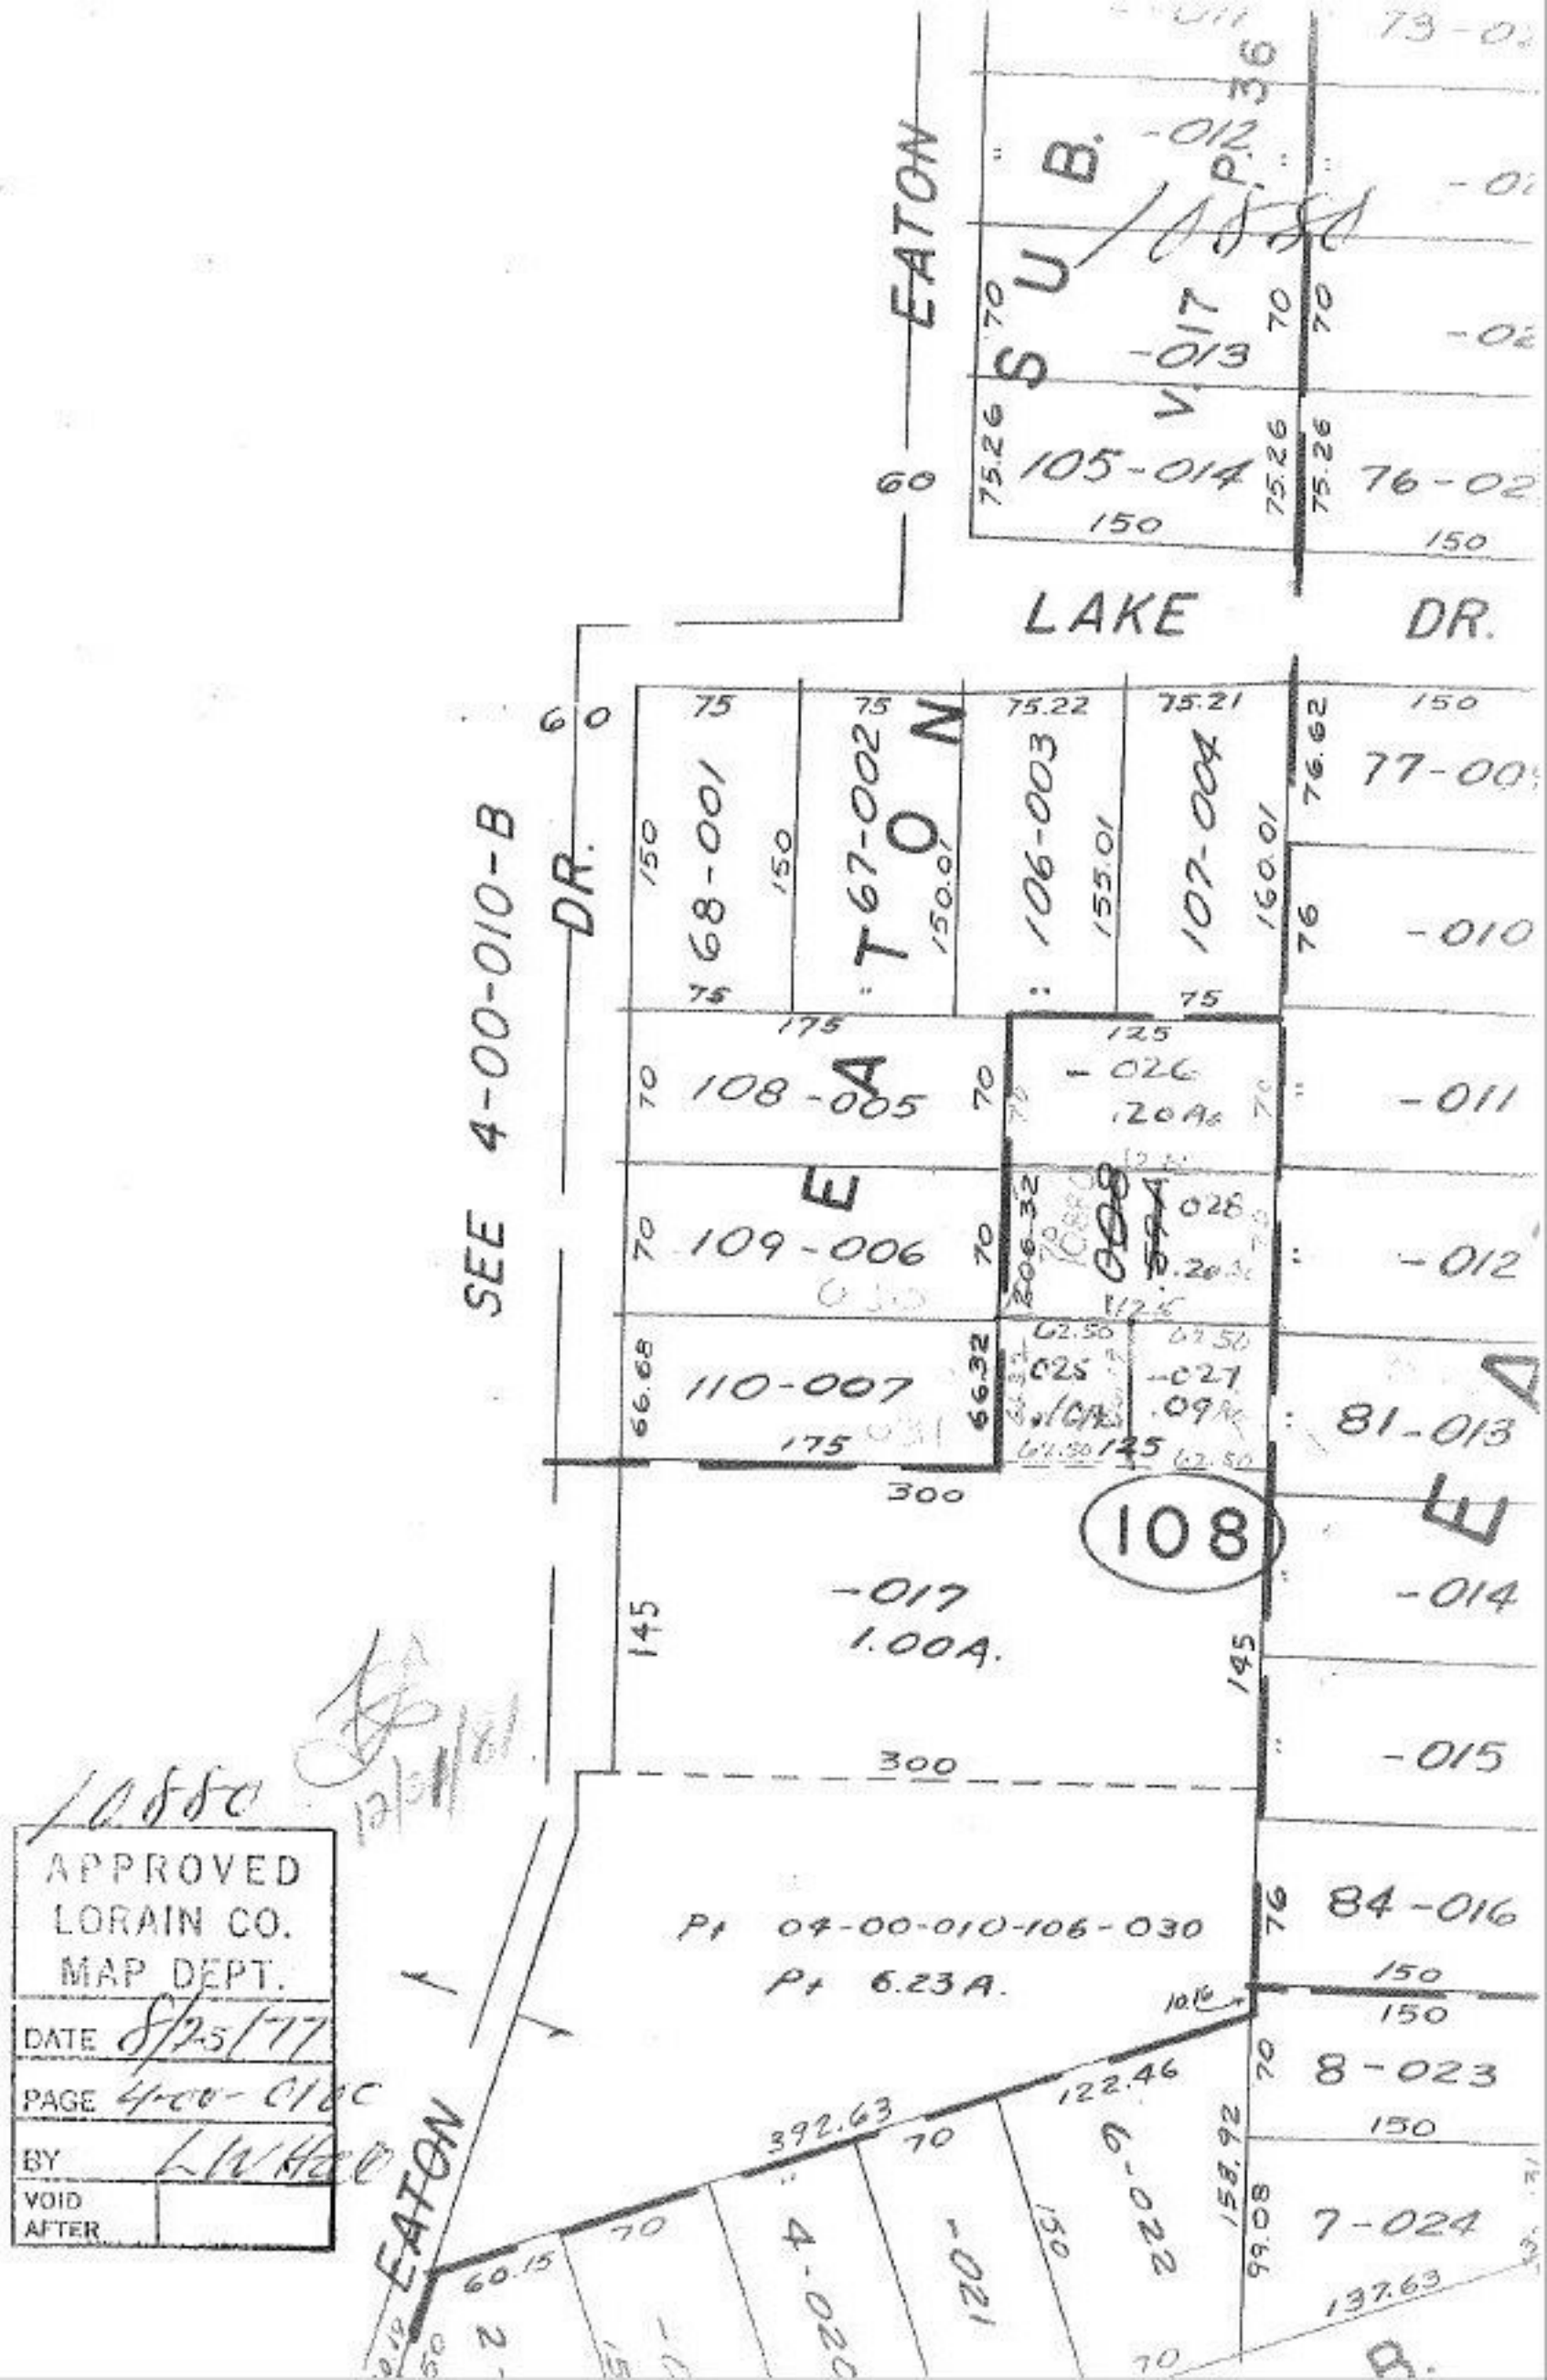
EATON
SUB.
V. 17 P. 36
-012
-013
105-014
76-02
LAKE DR.
SEE 4-00-010-B
DR.
68-001
67-002
106-003
107-004
77-00
-010
108-005
-026
.20 Ac
-011
109-006
-012
110-007
-027
.09 Ac
81-013
108
-017
1.00A.
-014
-015
Pt 04-00-010-106-030
Pt 6.23A.
84-016
8-023
7-024
6-022
-021
4-020
EATON
10880
APPROVED
LORAIN CO.
MAP DEPT.
DATE 8/25/77
PAGE 4-00-010C
BY L.W. Hall
VOID AFTER