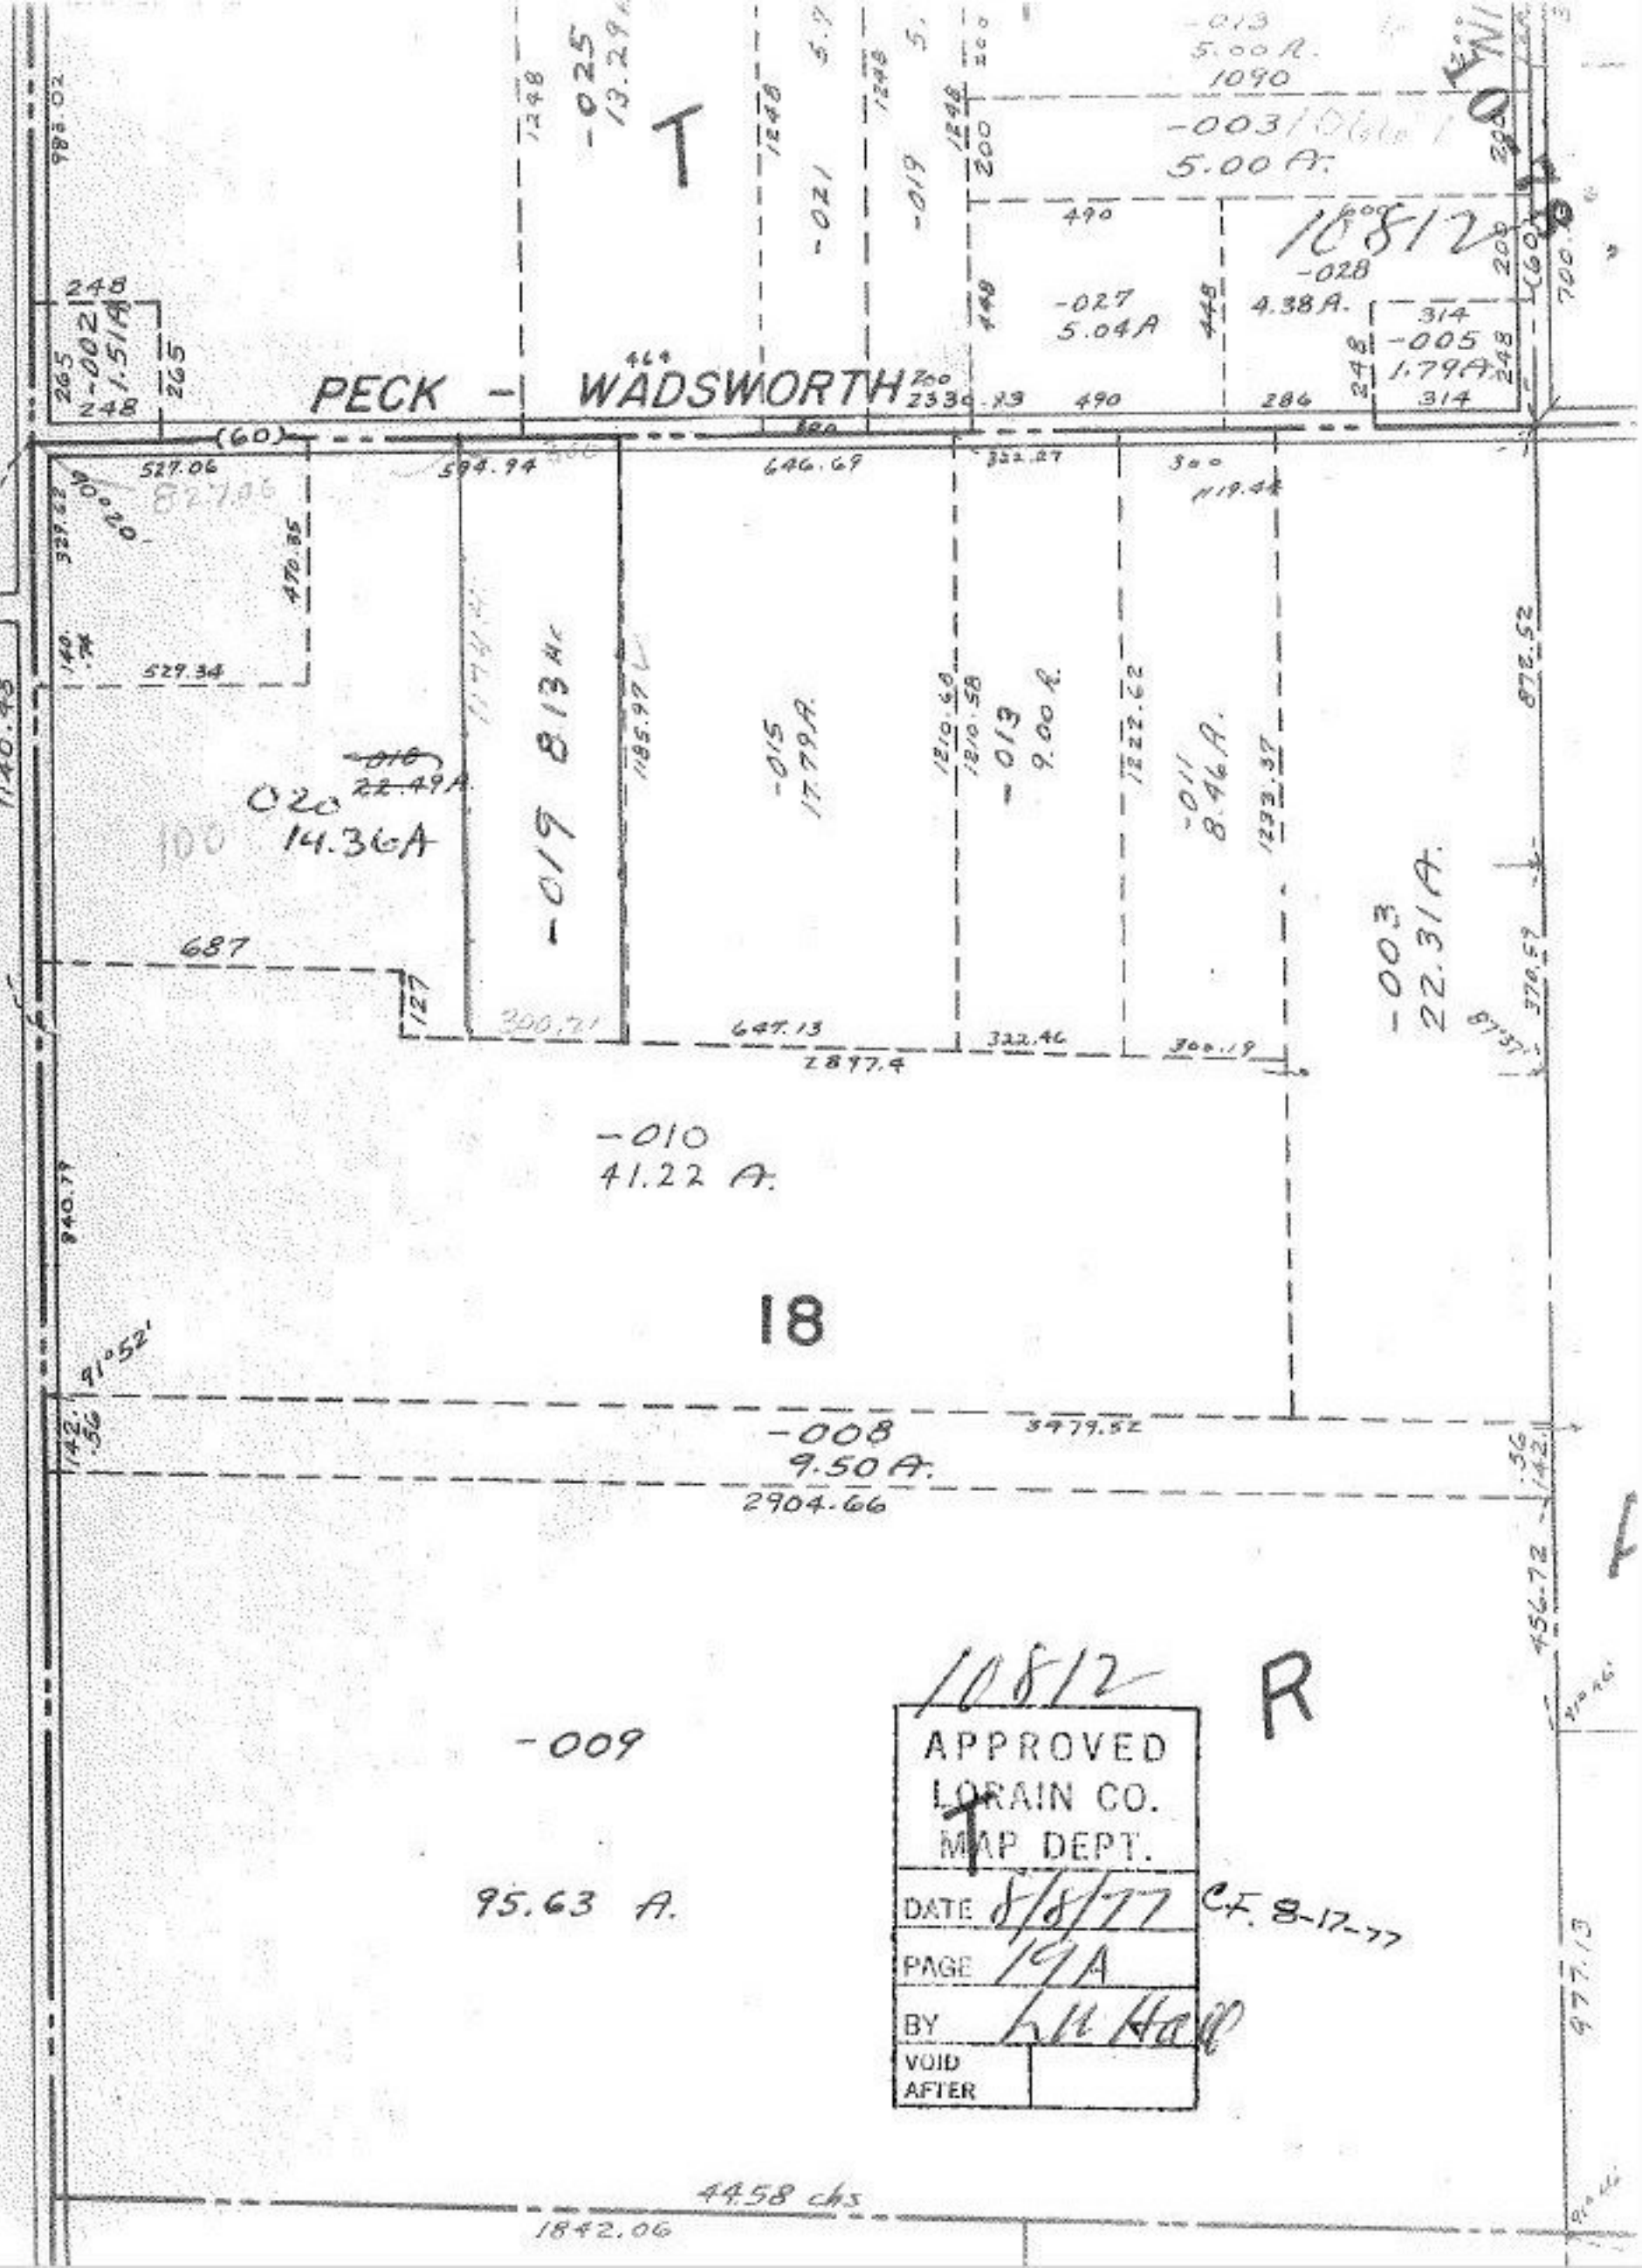

PECK - WADSWORTH
T
-025
13.29
-021
-019
-013
5.00 A.
1090
-003
5.00 A.
10812
-028
4.38 A.
-027
5.04 A
-005
1.79 A.
-002
1.51 A
-019 8.13 Ac
-015
17.79 A.
-013
9.00 A.
-011
8.46 A.
-003
22.31 A.
020
14.36 A
-010
41.22 A.
18
-008
9.50 A.
-009
95.63 A.
10812
R
APPROVED
LORAIN CO.
MAP DEPT.
DATE 8/8/77
C.F. 8-17-77
PAGE 19A
BY L.U. Hall
VOID AFTER
4458 chs
1842.06