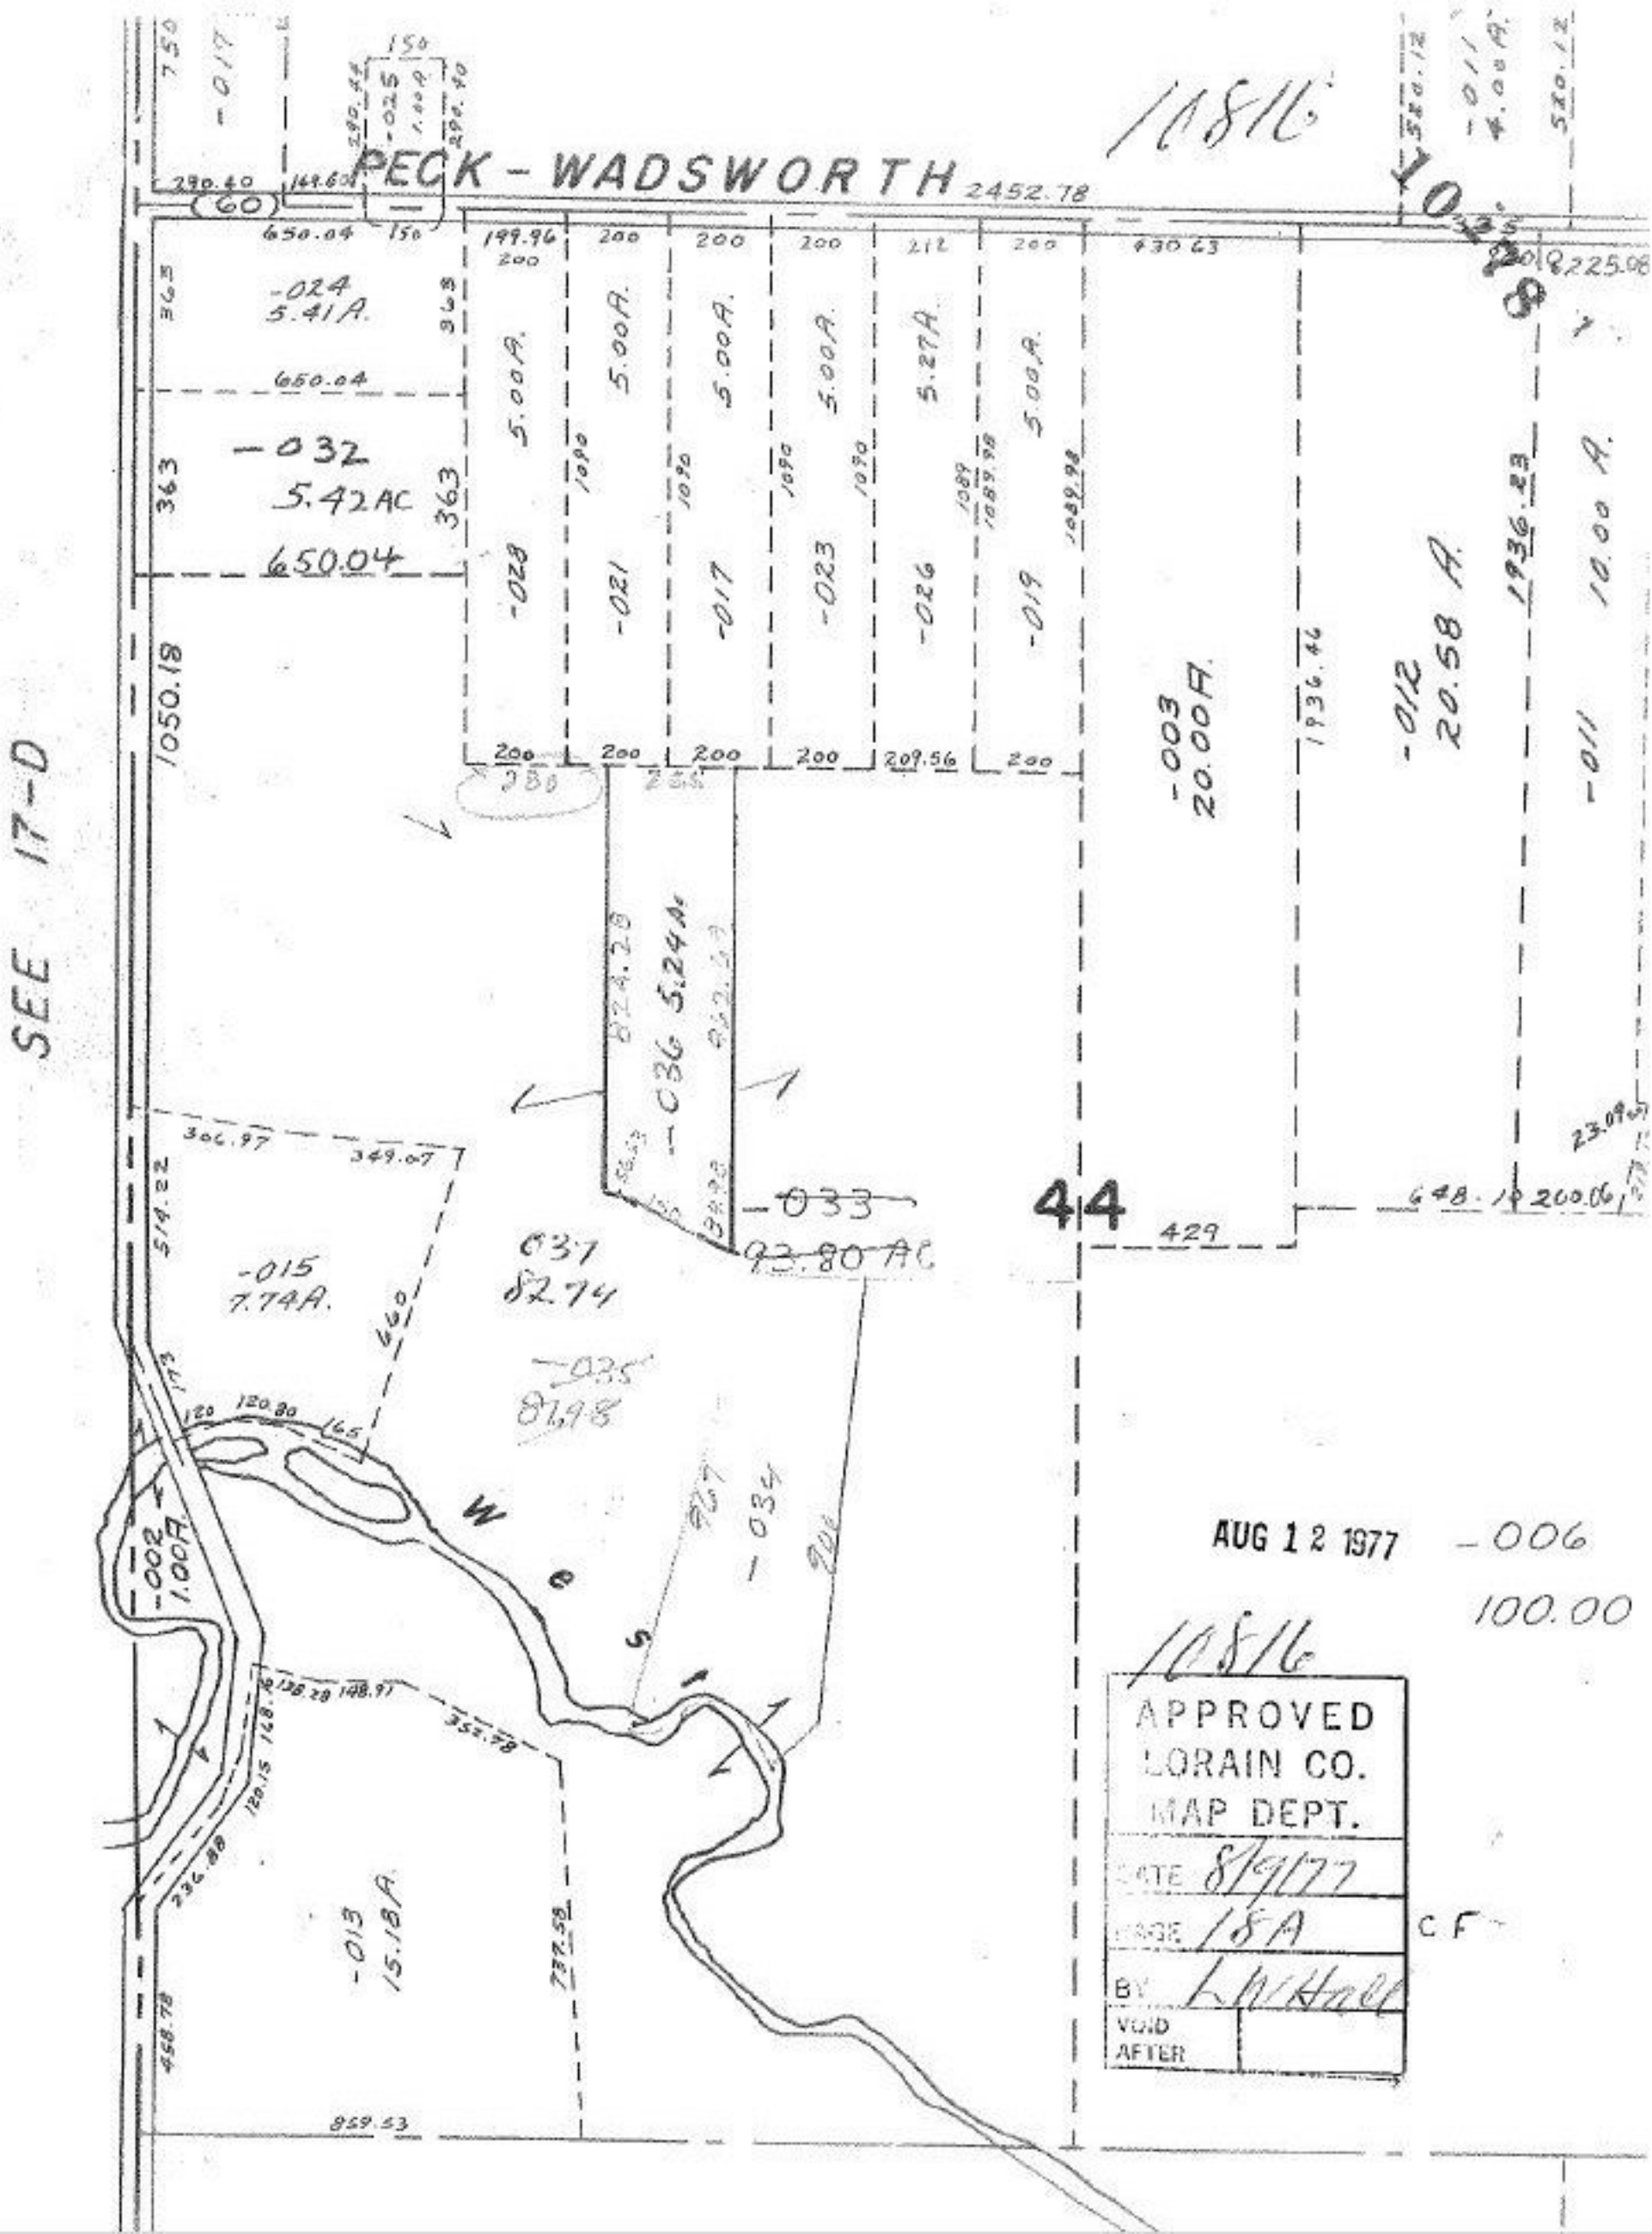

PECK - WADSWORTH
2452.78
10816
10278
SEE 17-D
-024
5.41A.
-032
5.42AC
650.04
5.00A.
5.27A.
-028
-021
-017
-023
-026
-019
-003
20.00A.
-012
20.58 A.
-011
10.00 A.
-036 5.24A.
-033
93.80 AC
44
-015
7.74A.
037
82.74
-035
87.98
-034
-002
1.00A.
-013
15.18A.
-006
100.00
AUG 12 1977
APPROVED
LORAIN CO.
MAP DEPT.
DATE 8/9/77
PAGE 18A
BY L.W. Hall
VOID AFTER
C F