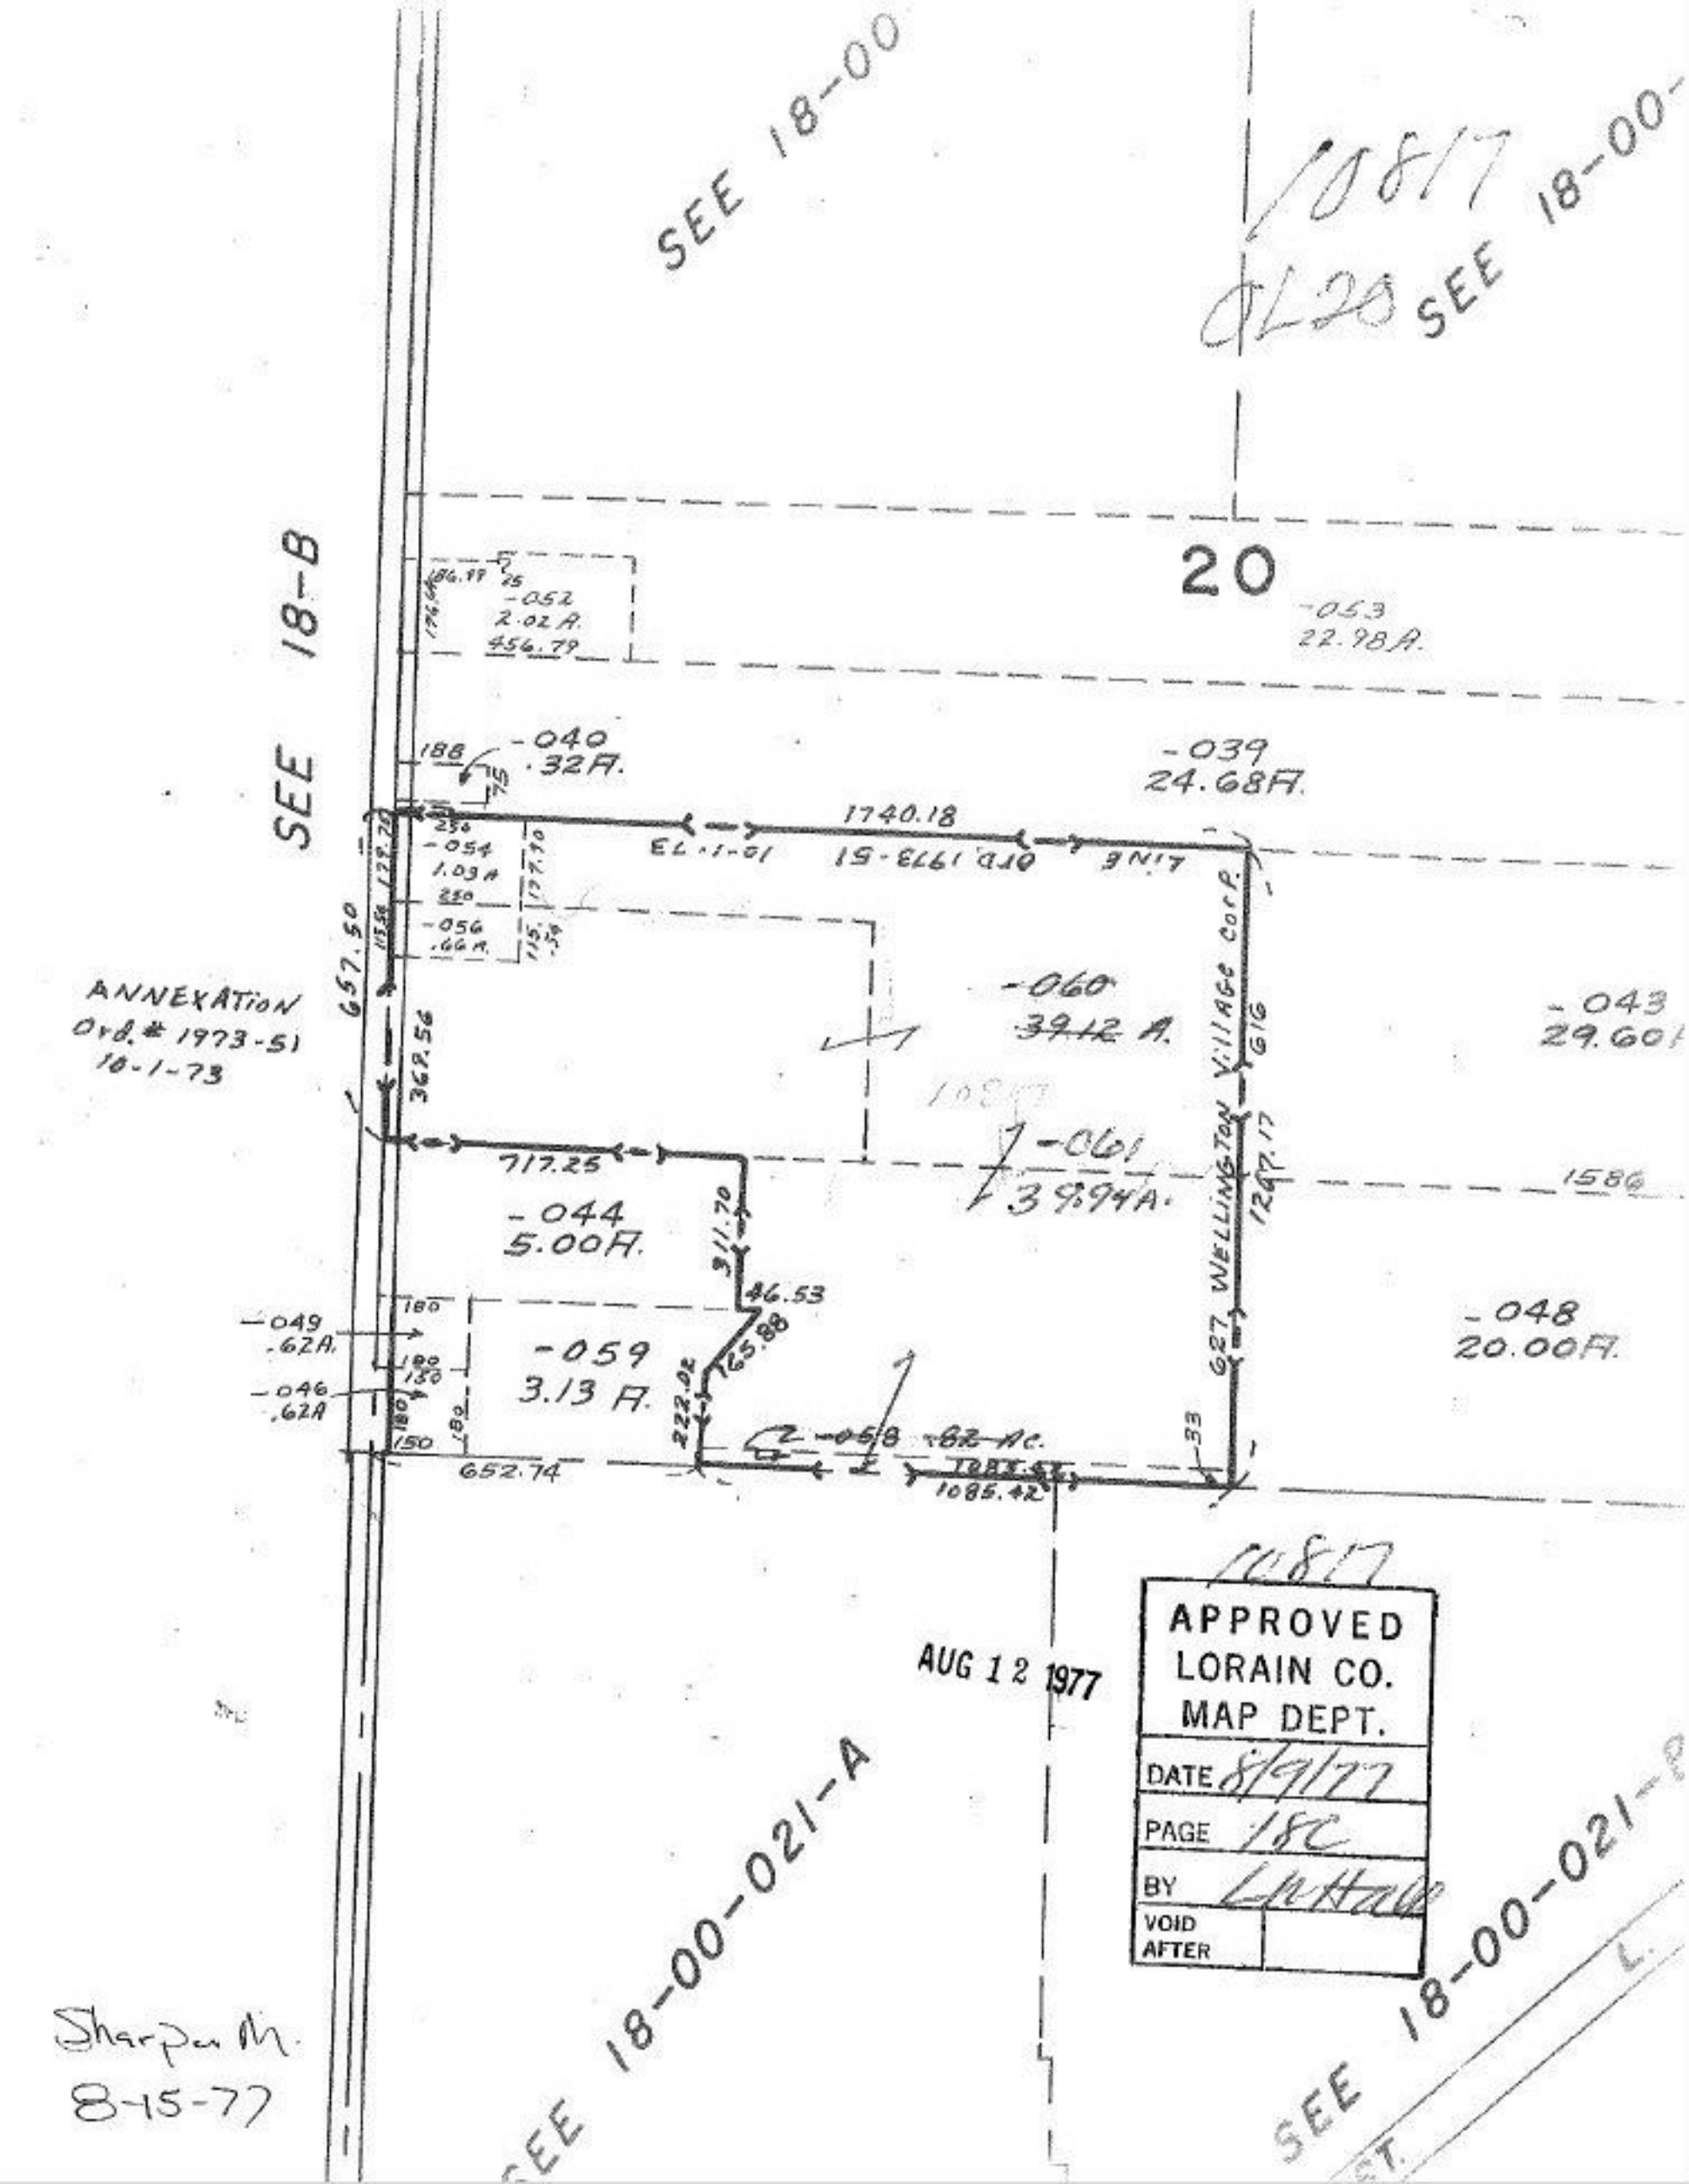
SEE 18-00
SEE 18-00-
10817
OL20
SEE 18-B
20
-052
2.02 A.
456.79
-053
22.98 A.
-040
.32 A.
-039
24.68 A.
1740.18
ORD. 1973-51
LINE
-054
1.03 A
-056
.66 A.
657.50
ANNEXATION
Ord. # 1973-51
10-1-73
-060
39.12 A.
-043
29.60
WELLINGTON VILLAGE CORP.
616
-061
39.94 A.
717.25
-044
5.00 A.
311.70
46.53
1586
-049
.62 A.
-046
.62 A
-059
3.13 A.
165.88
222.02
-048
20.00 A.
627
652.74
1085.42
10817
APPROVED
LORAIN CO.
MAP DEPT.
DATE 8/9/77
PAGE 18C
BY
VOID AFTER
AUG 12 1977
SEE 18-00-021-A
SEE 18-00-021-B
Sharpen M.
8-15-77