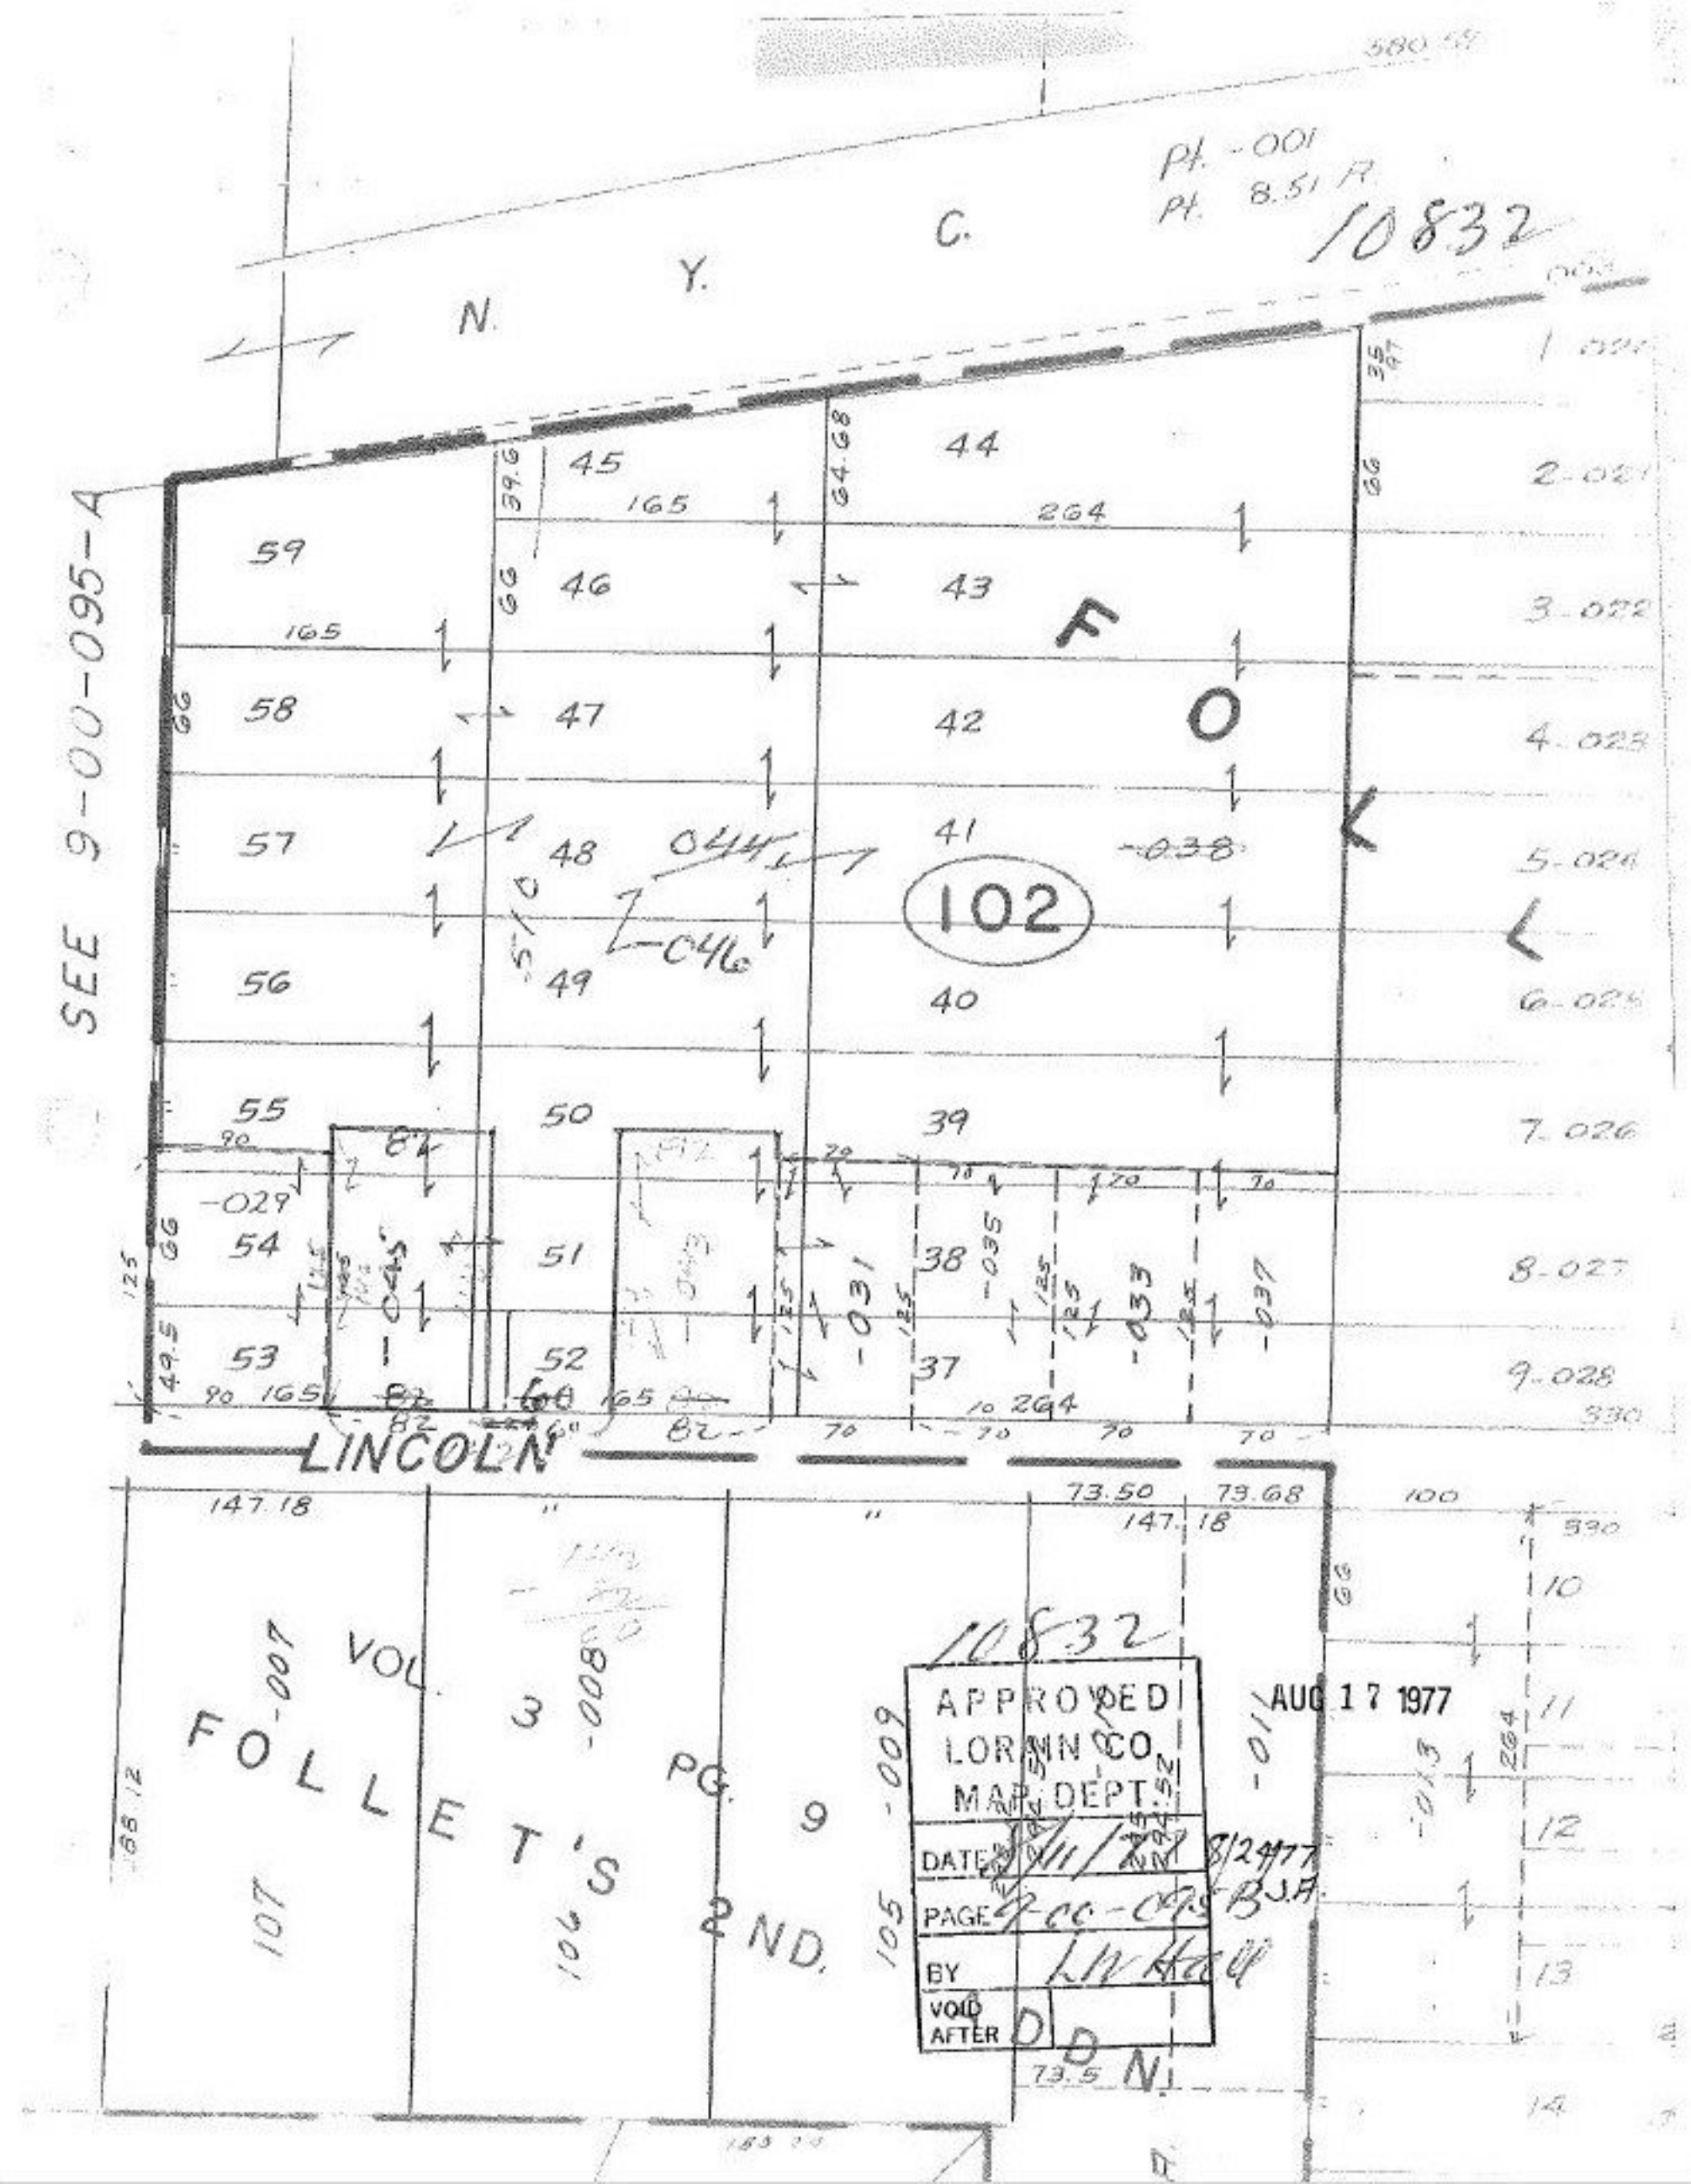

N. Y. C.
Pt. -001
Pt. 8.51 R
10832
SEE 9-00-095-A
FOLL
102
LINCOLN
VOL. 3 PG. 9
FOLLET'S 2ND.
10832
APPROVED
LORAIN CO.
MAP DEPT.
DATE 8/24/77
PAGE 9-00-095 B
BY LW Hall
VOID AFTER
AUG 17 1977